
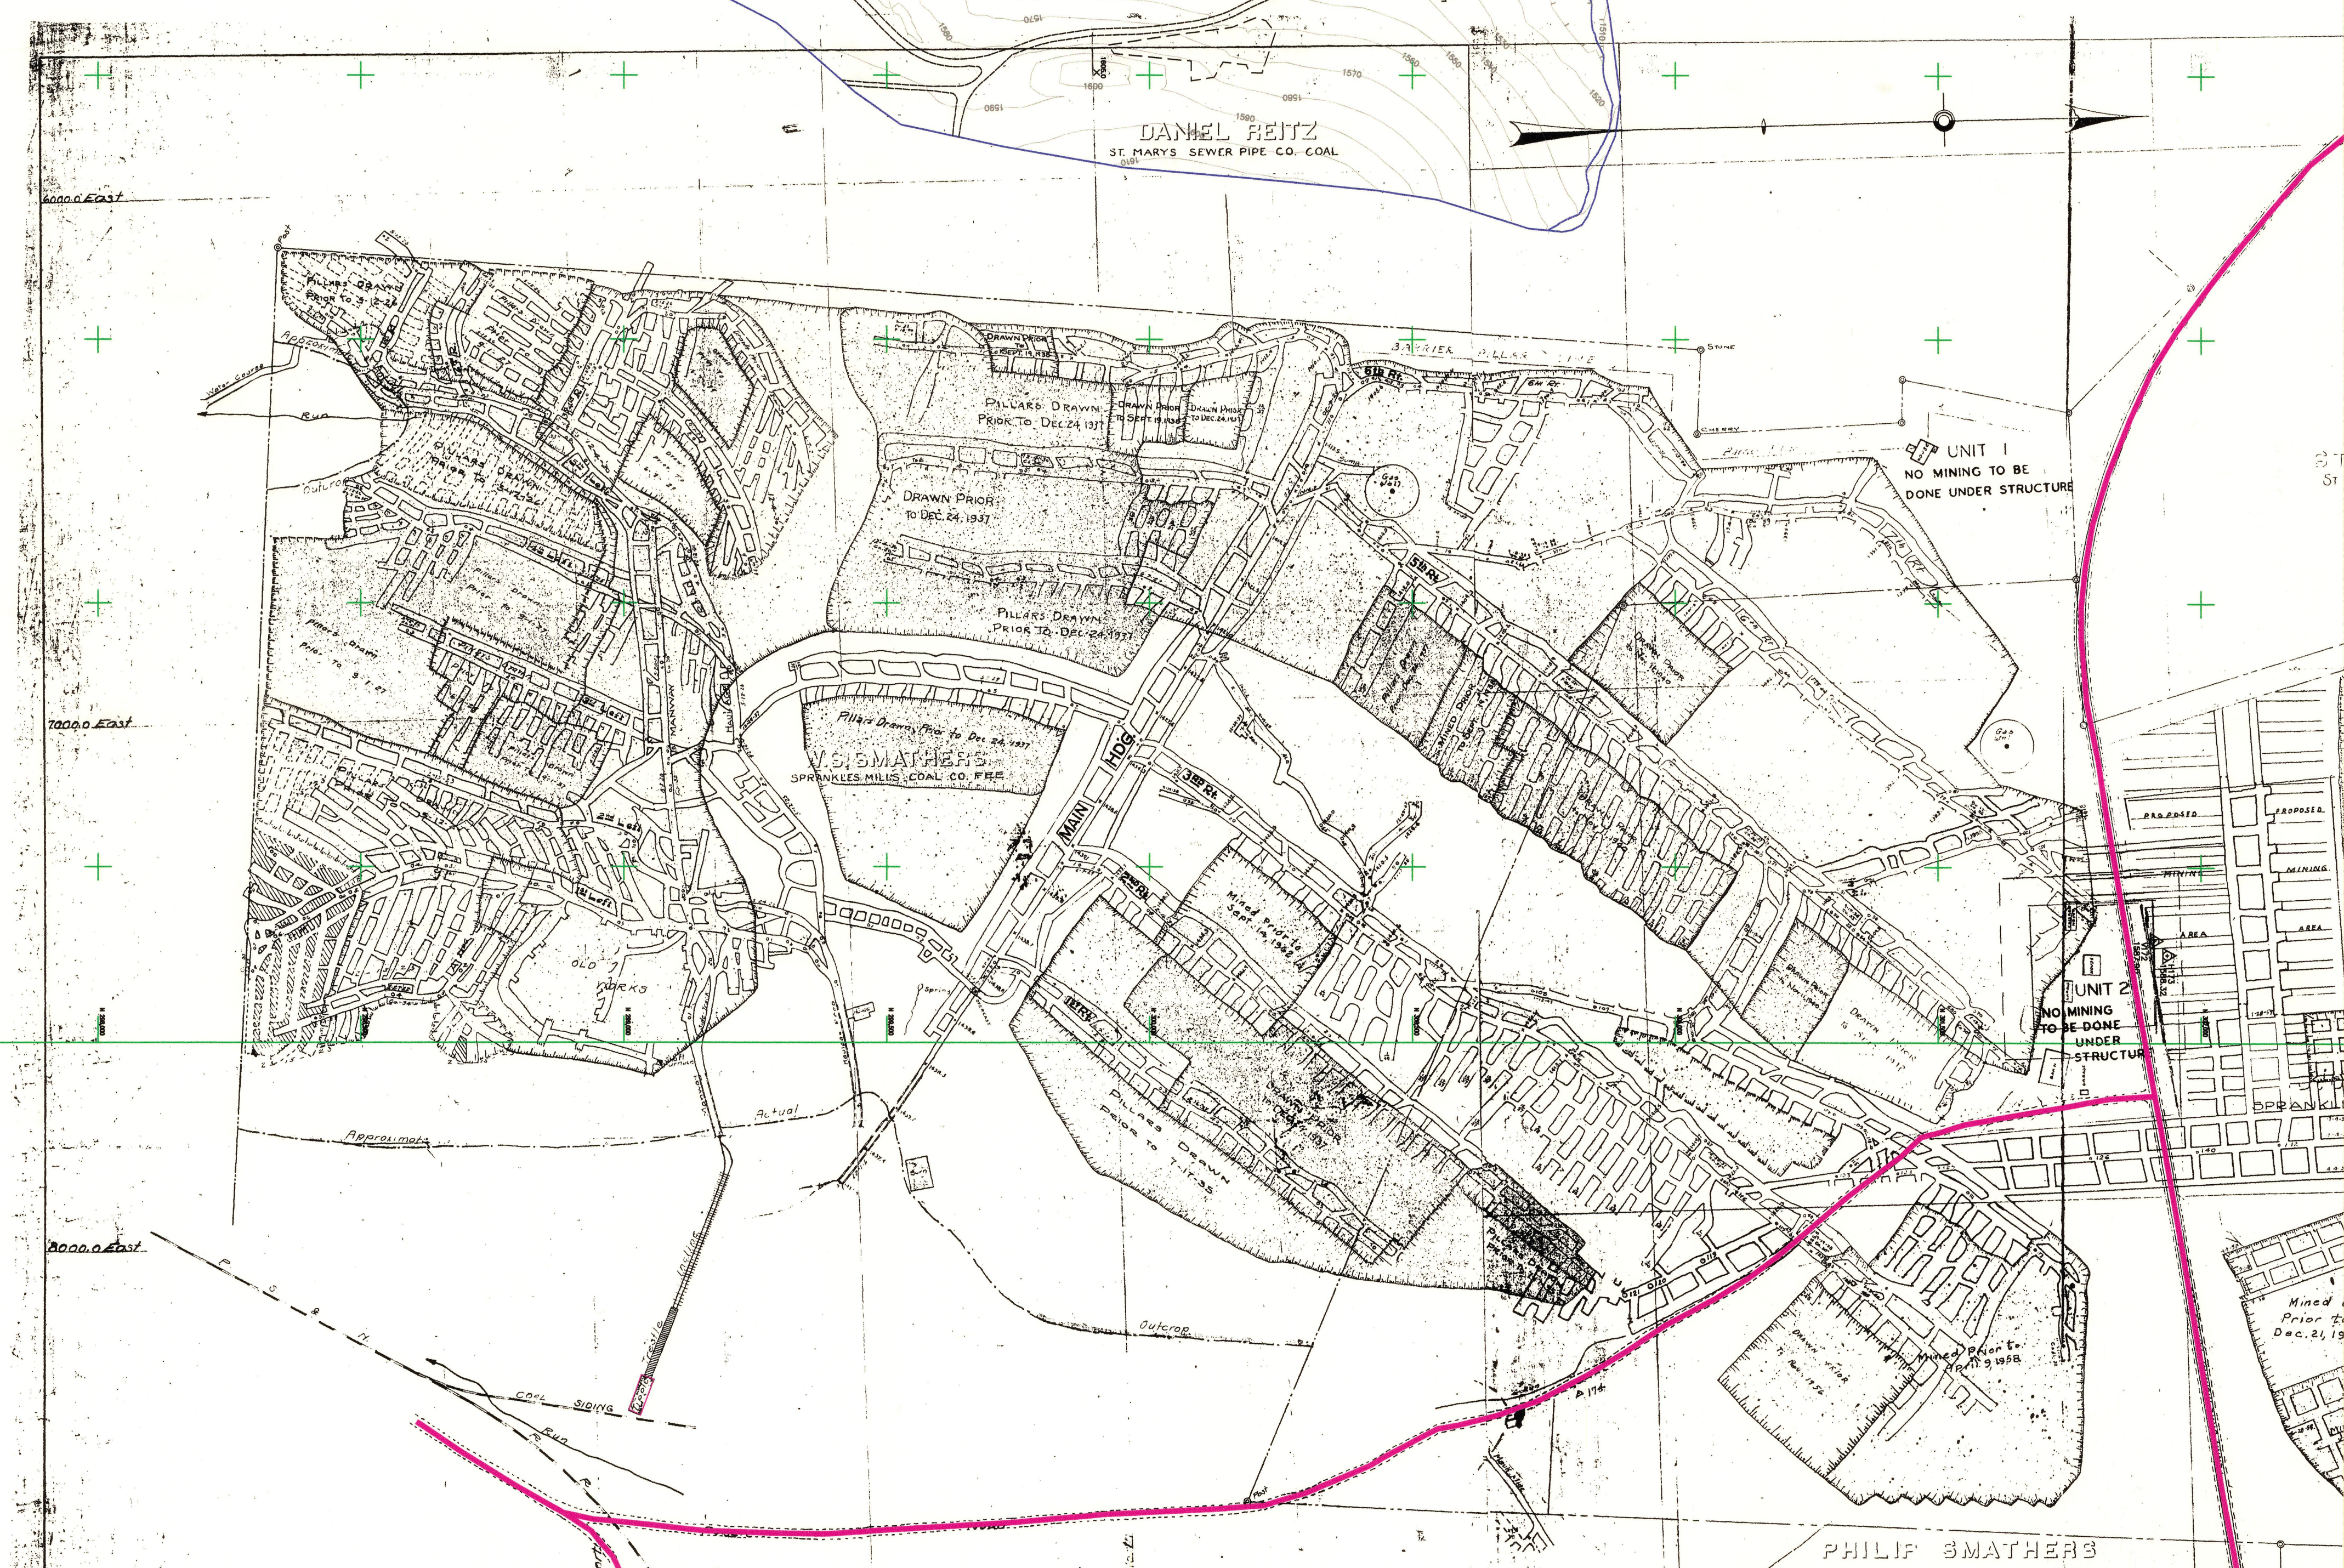


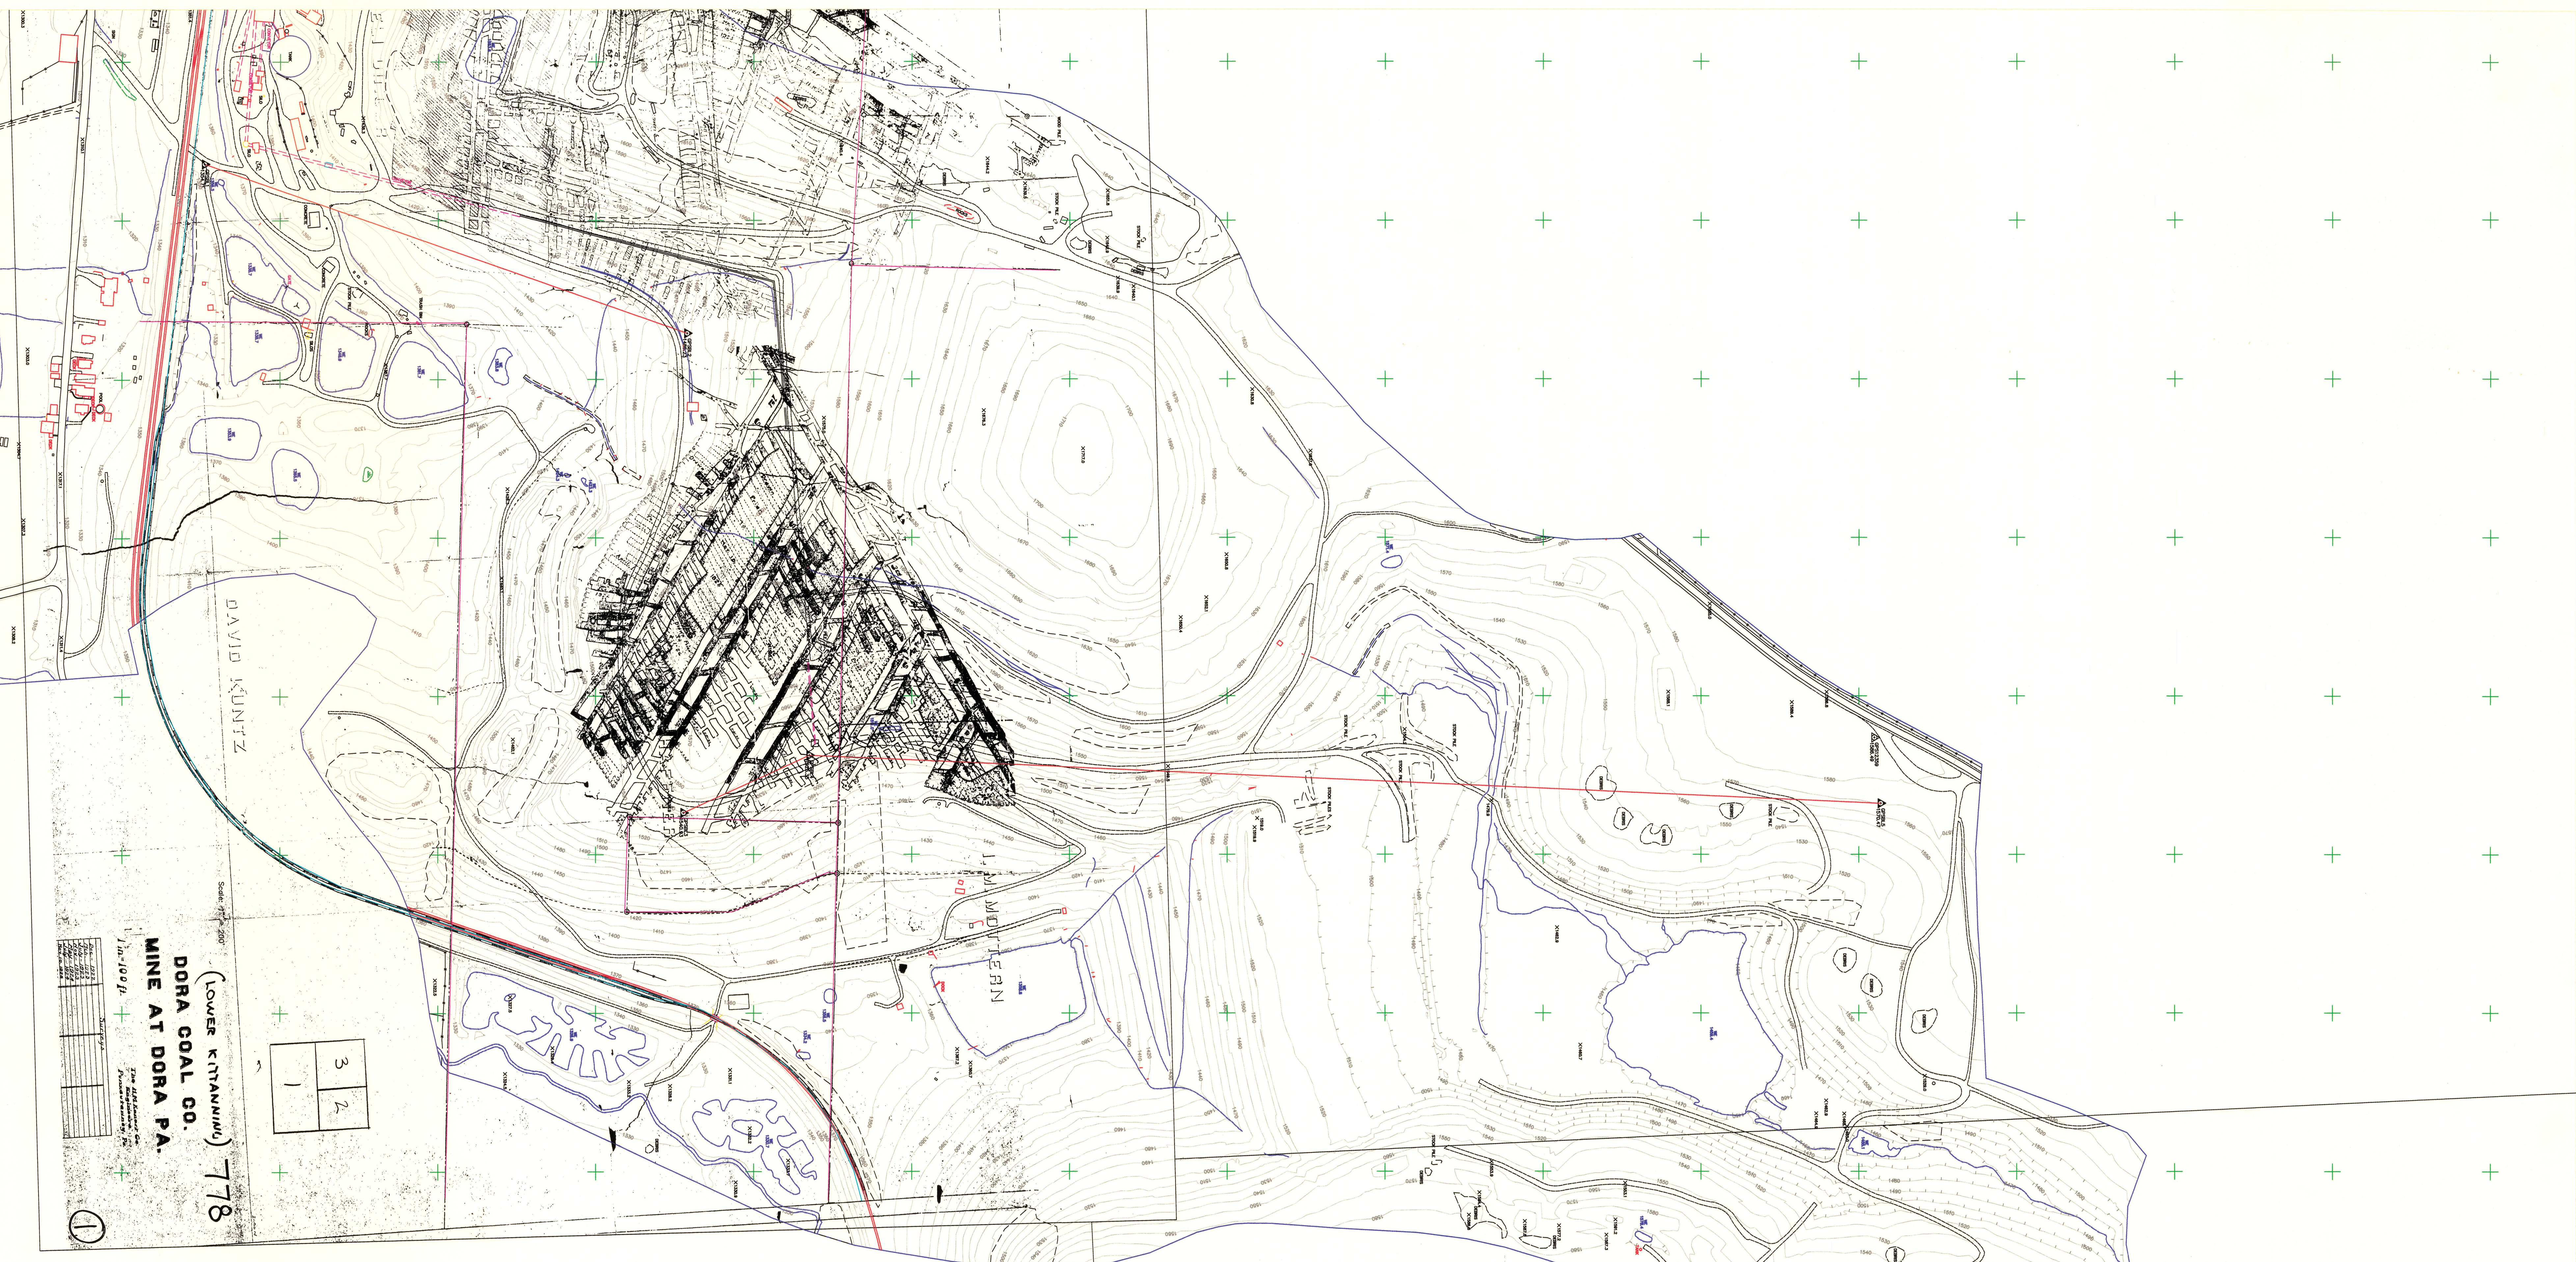

SCALE 1"=200'

1/3/20

DAVID KUNTZ

DORA COAL CO.

MINE AT DORA PA.

778

Scale 1"=200'


1

2

3