


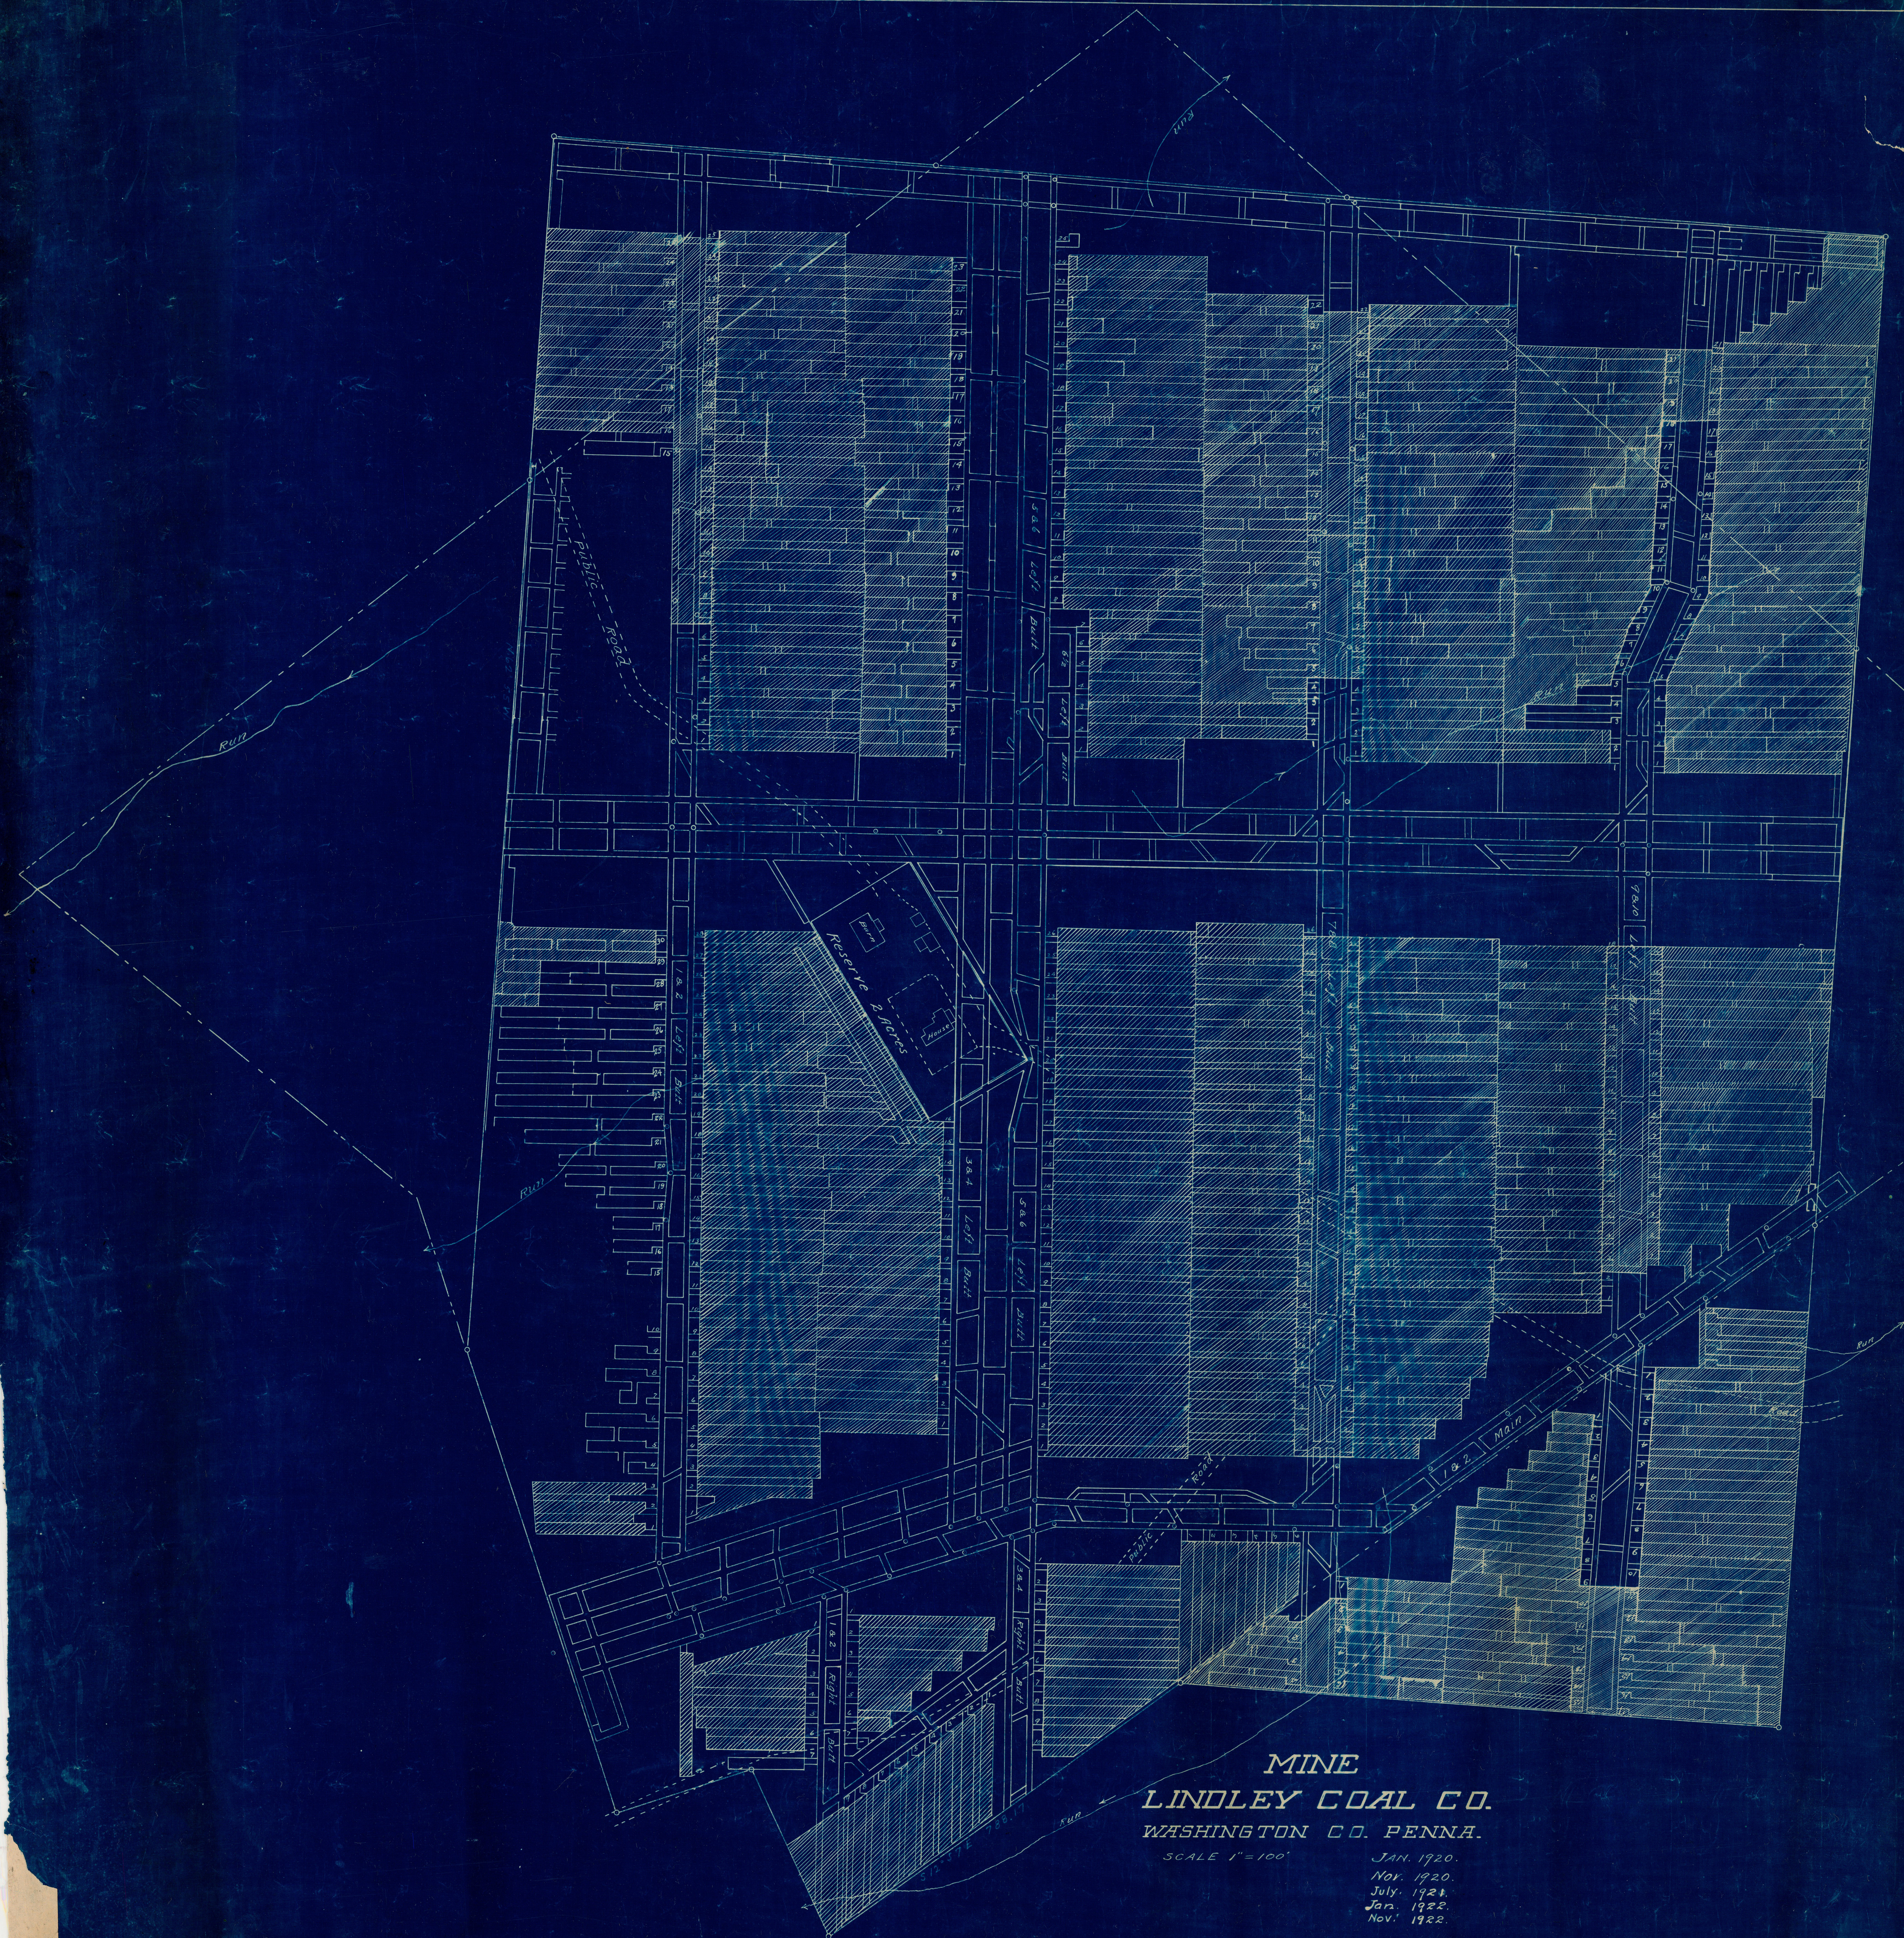

MINE
LINDLEY COAL CO.
WASHINGTON CO. PENNA.

SCALE 1"=100'

JAN. 1920.
Nov. 1920.
July. 1921.
Jan. 1922.
Nov. 1922.