


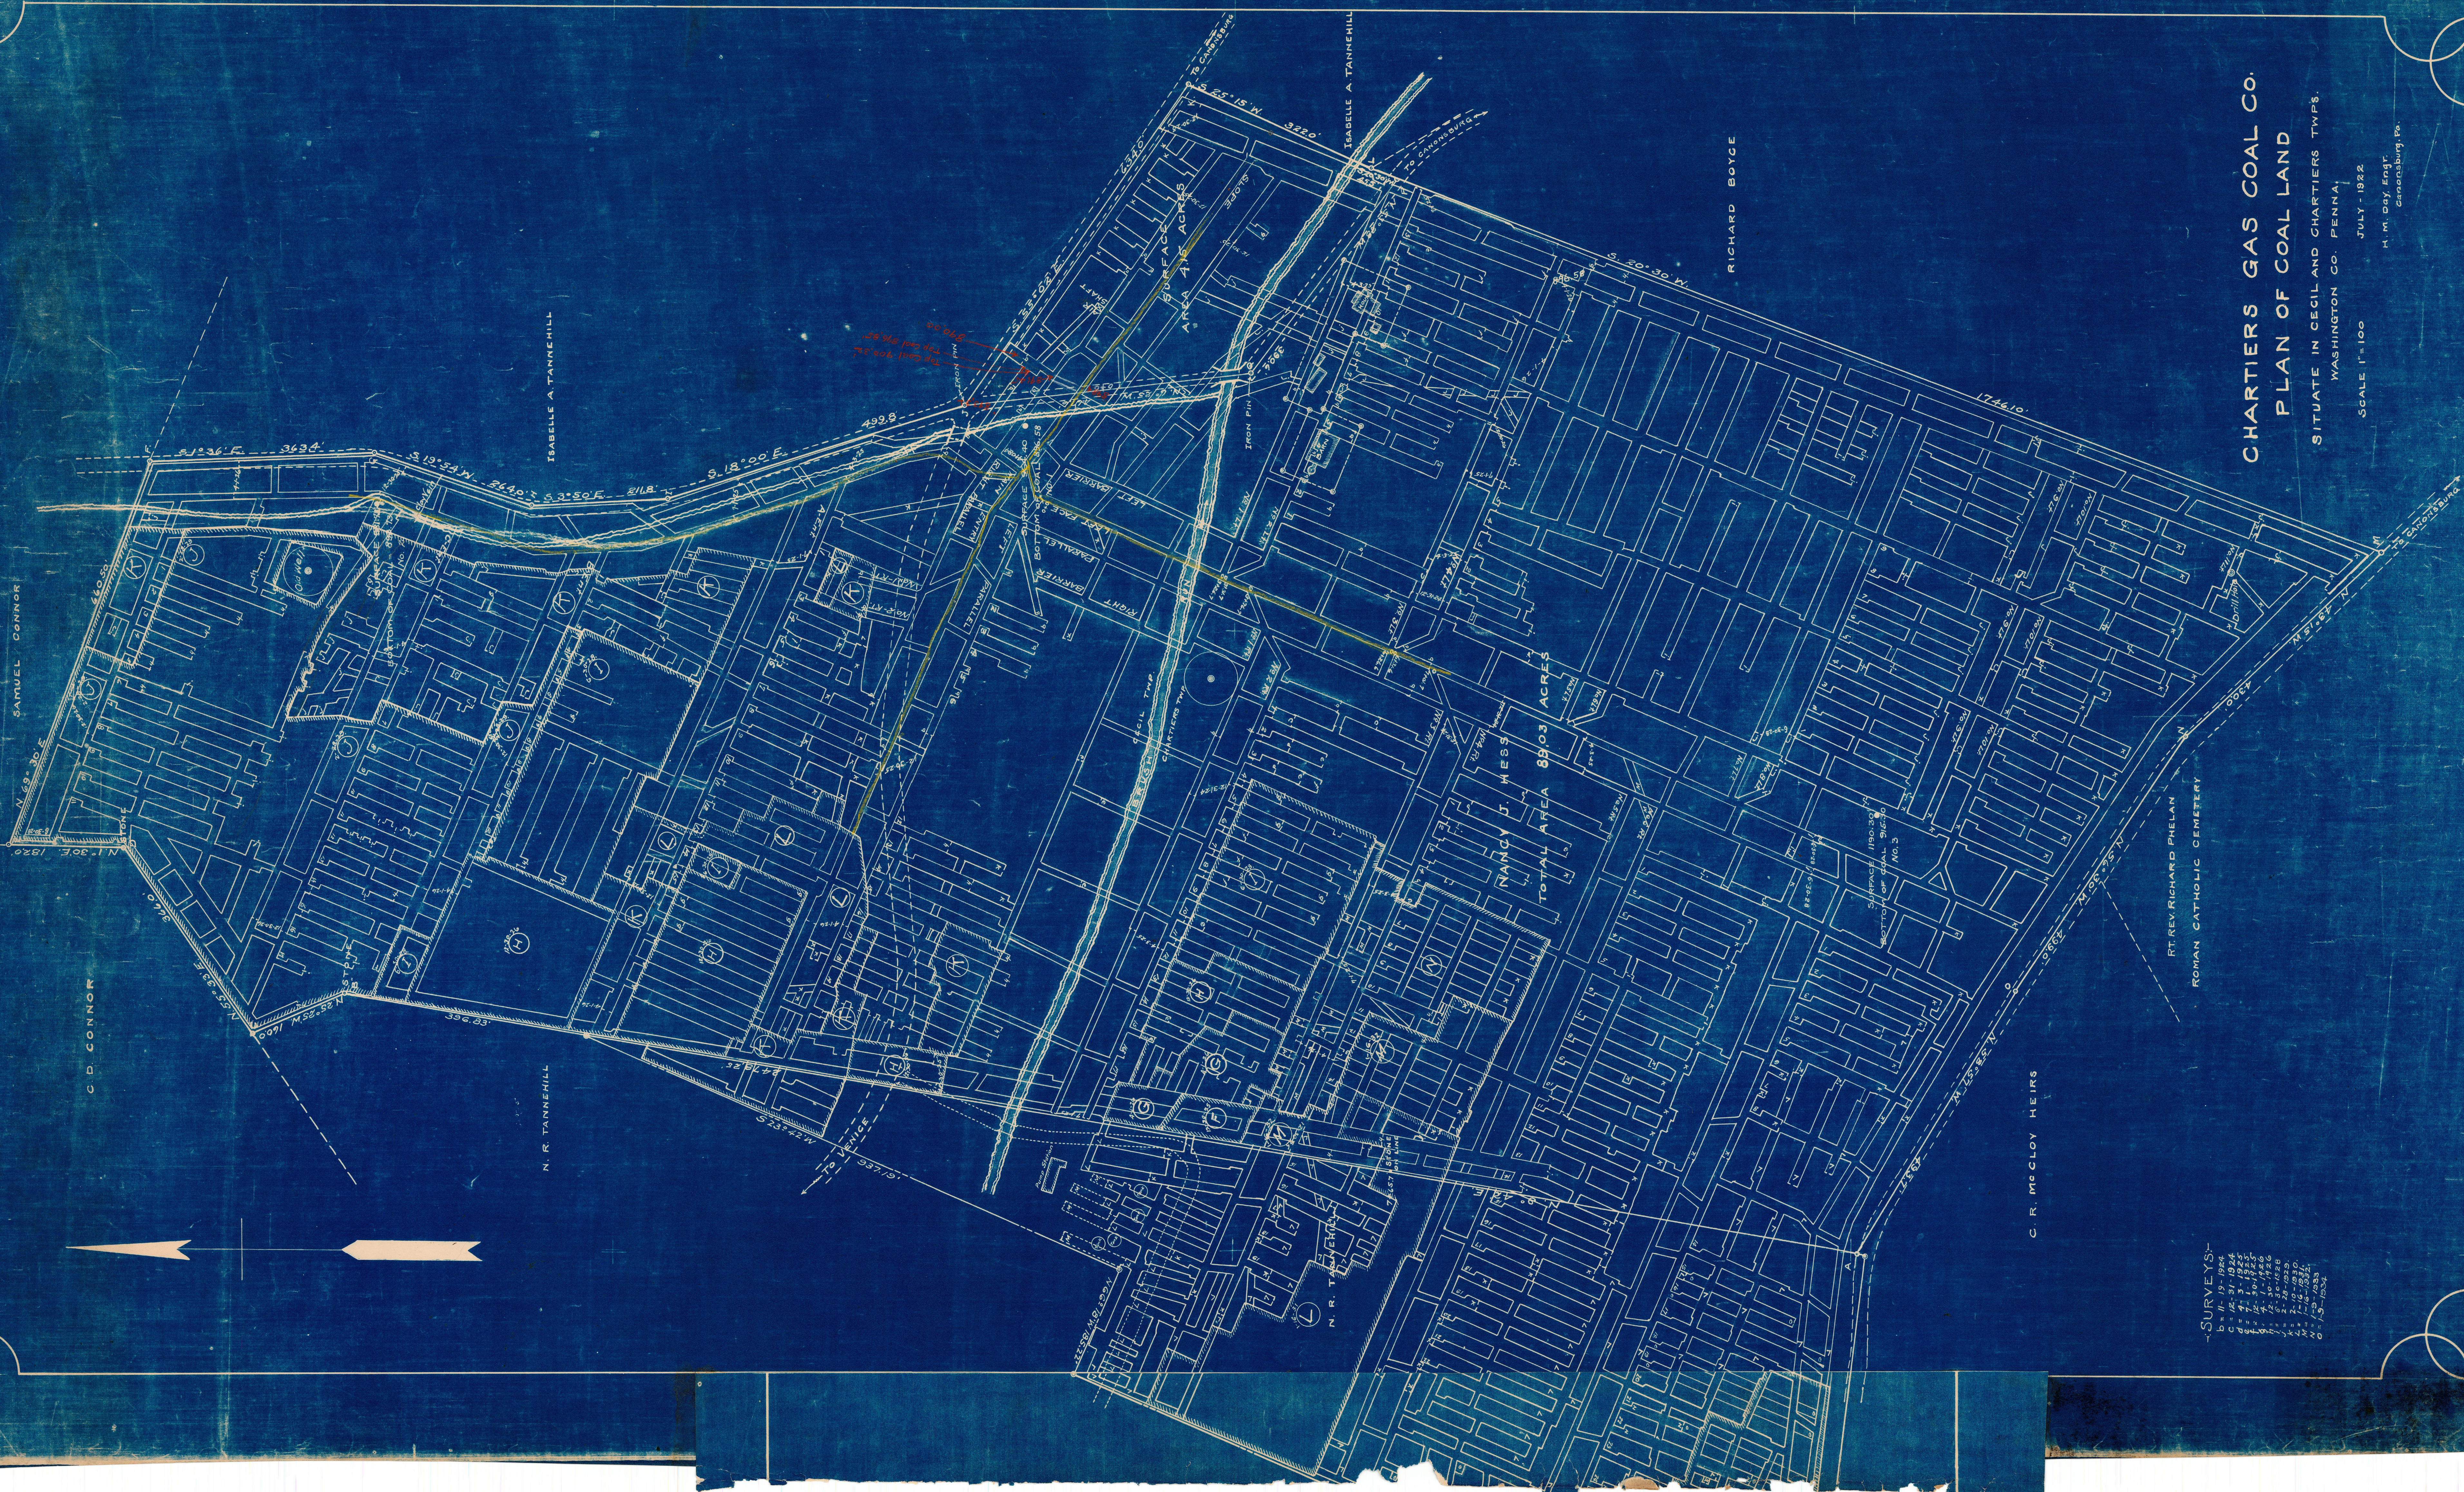

SURVEYS:-
A 12-91-1894
B 12-91-1894
C 12-91-1894
CHARTIERS GAS COAL CO. PLAN OF COAL LAND

SITUATE IN CECIL AND CHARTIERS TOWNSHIPS,
WASHINGTON CO., PENNA.

SCALE 1"=100

JULY - 1922

H. M. Day, Eng'r.
Greensburg, Pa.