


VB4

VB4

VERNER COAL & COKE CO.
OLIVER BLDG. PITTSBURGH PA.
MAP OF A PART OF
VERNER NO. 1 MINE
BULGER PA. SCALE 1"=100'

DATES OF SURVEYS	
T	Sept. 1917
U	Oct. 1917
V	Nov. 1917
W	Dec. 1917
X	Jan. 1918
Y	Feb. 1918
Z	Mar. 1918

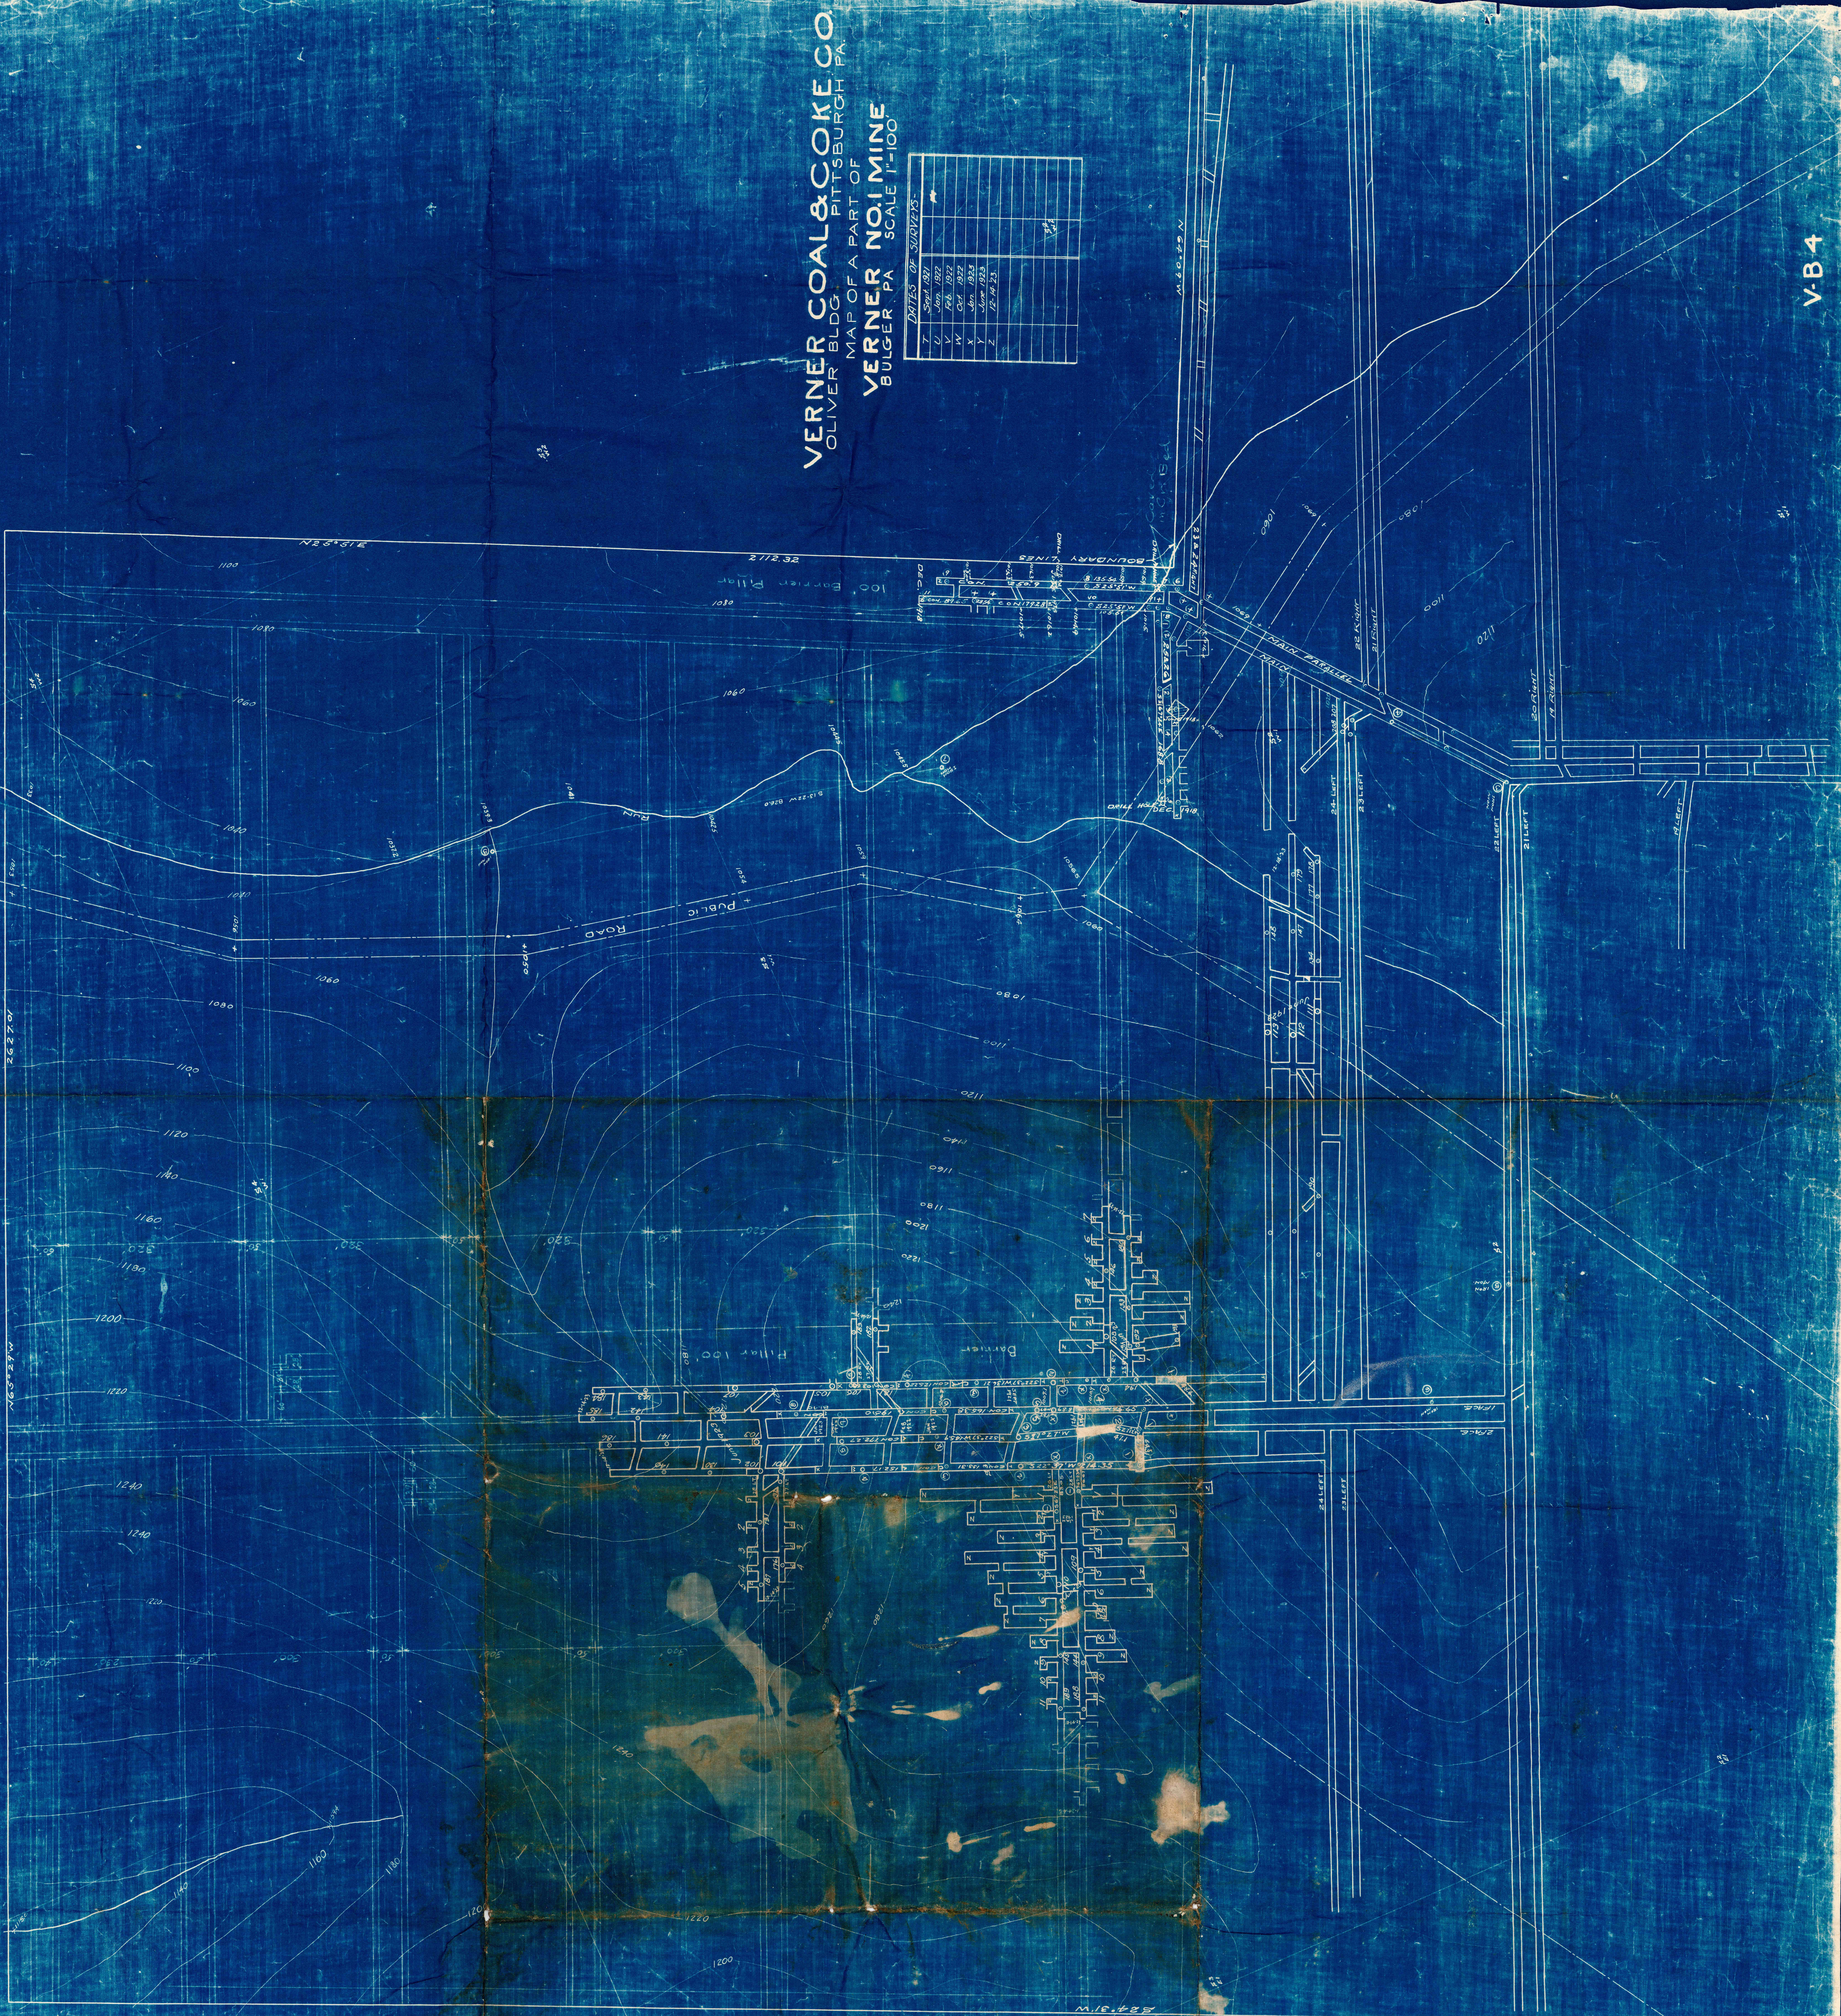

VB4

VB4