


SURVEYS
D - Feb. 1-1939.
E - Nov. 1-1940.
F - Jan. 1-1942.
G - Jan. 1-1943.

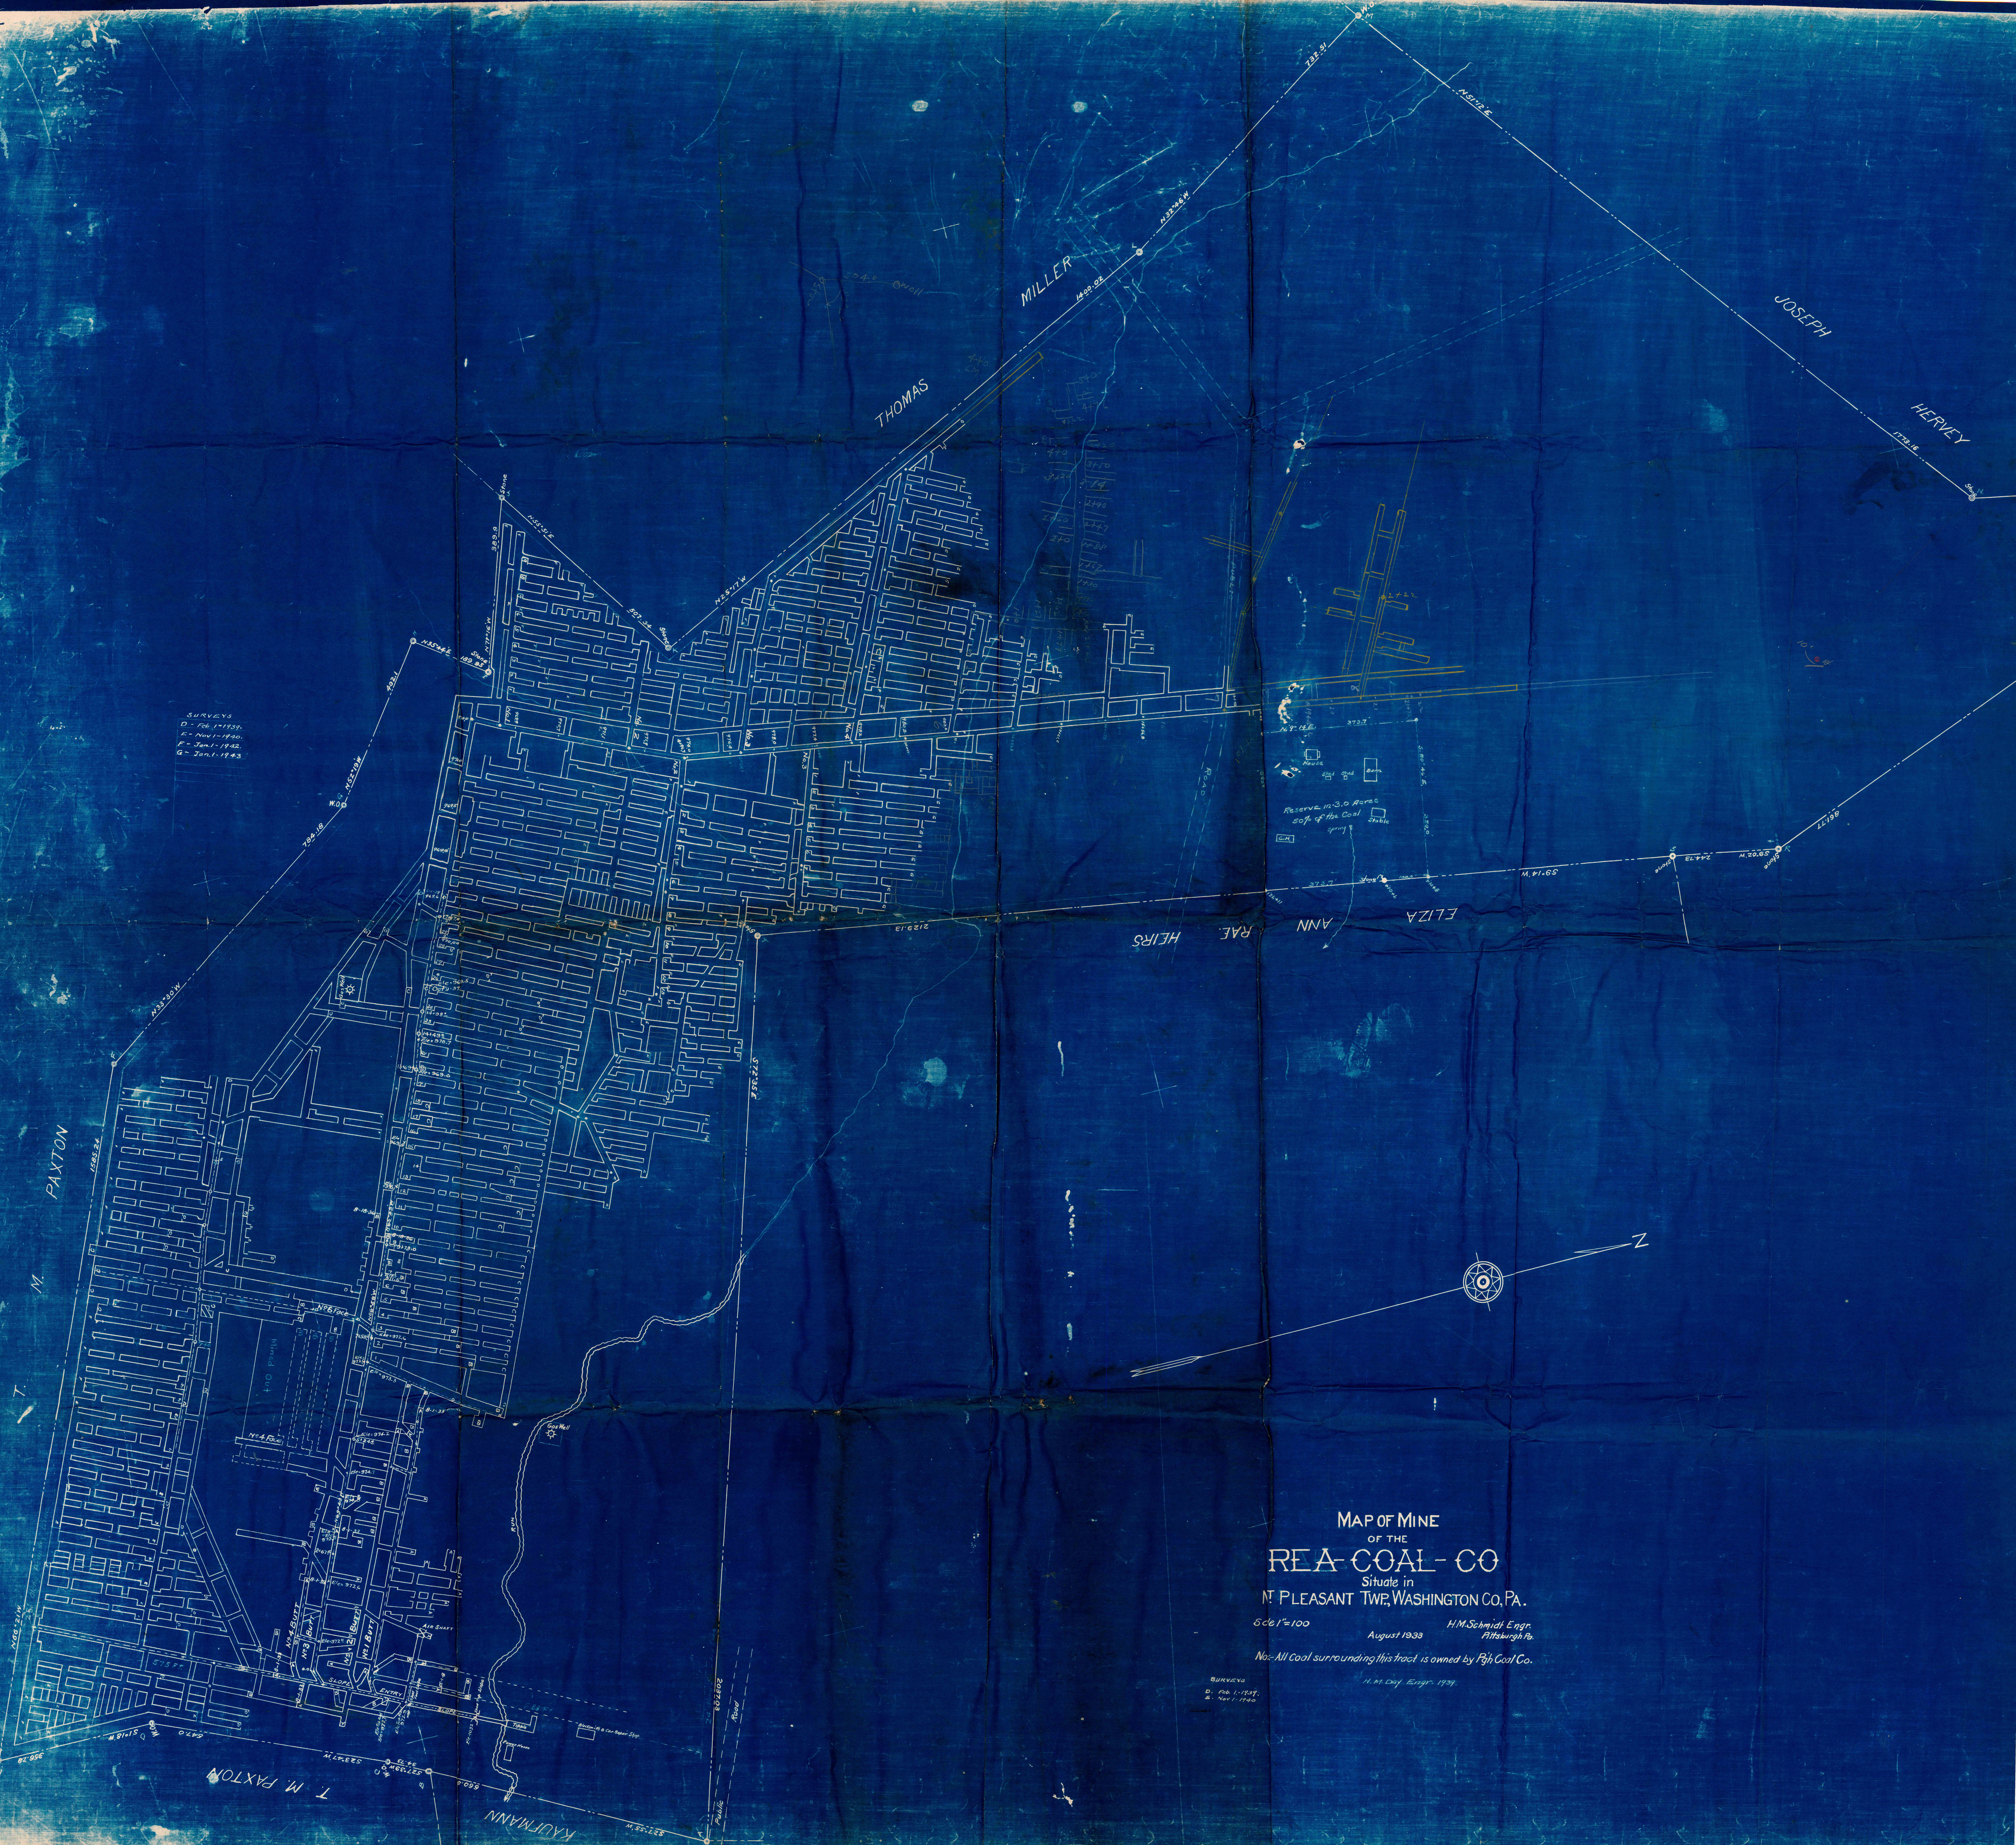

MAP OF MINE
OF THE
REA COAL CO
Situate in
N PLEASANT TWP, WASHINGTON CO, PA.

Scale 1"=100
August 1933
H.M. Schmidt, Engr.
Pittsburgh Pa.

Note: All Coal surrounding this tract is owned by Rgh Coal Co.
H.M. Day, Engr. 1939.

SURVEYS
D, Feb. 1-1939.
E, Nov. 1-1940.