


RAYBURN TWP      SITUATED IN      ARM. CO.      PA.

RAYBURN TWP      ARM. CO.      PA.

SCALE 1 INCH = 100 FT.

J. J. Thorne  
REG. ENGR. NO. 8055  
E. J. Weibel  
83-6572 9-62

I CERTIFY THAT THIS IS A TRUE  
AND CORRECT PRINT OF POWELL  
COAL CO. DECKER NO-2 MINE AS  
ABANDONED. - SEALED - SEPT. 1982

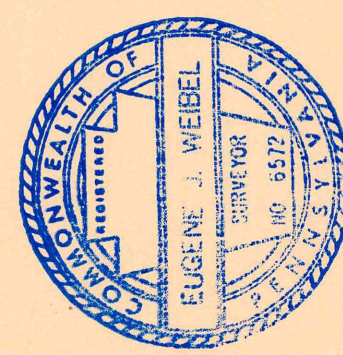

LANDS OF ARM. CO. INSTITUTION