


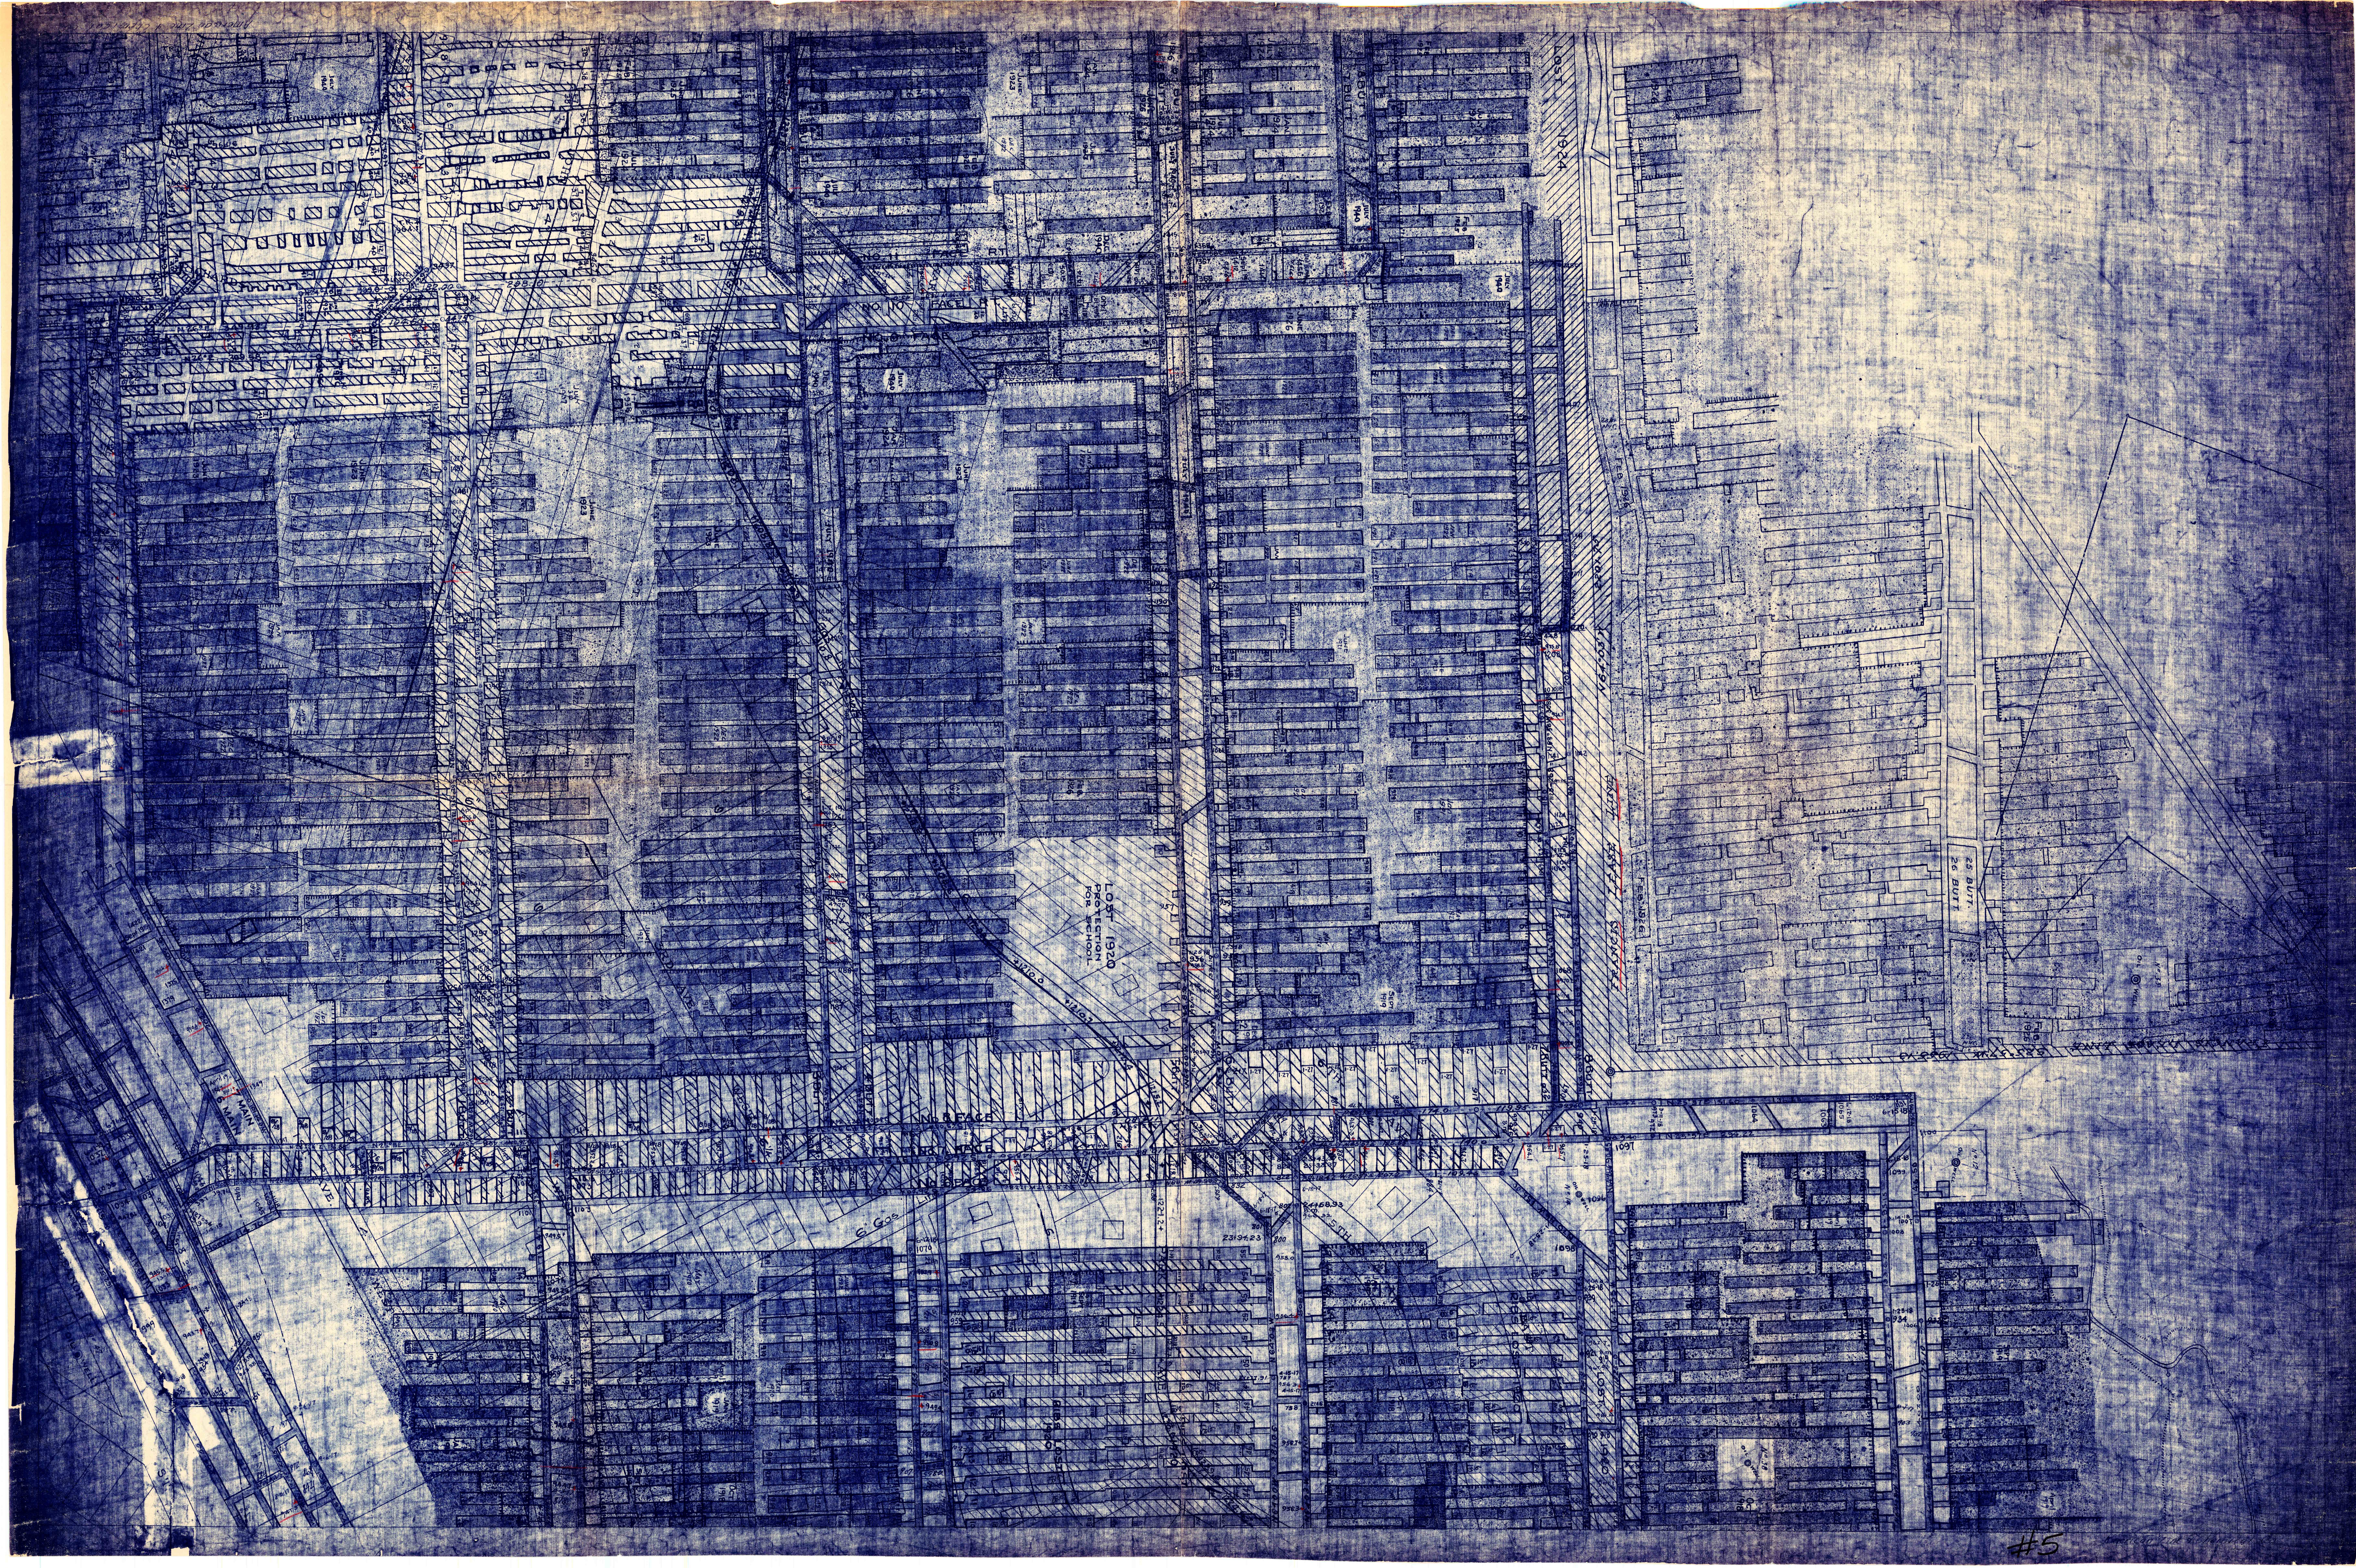

PROTECTION
FOR SCHOOL