


30 ACRES SURFACE CONVEYED TO AMERICAN ZINC & CHEMICAL CO. FOR RESERVOIR SITE

S. 61° 13' W.
2339.5'

(read) 1.5278
8271.57' S. 71° 53' W.

98.51'
1415.9' S. 20° 33' W.

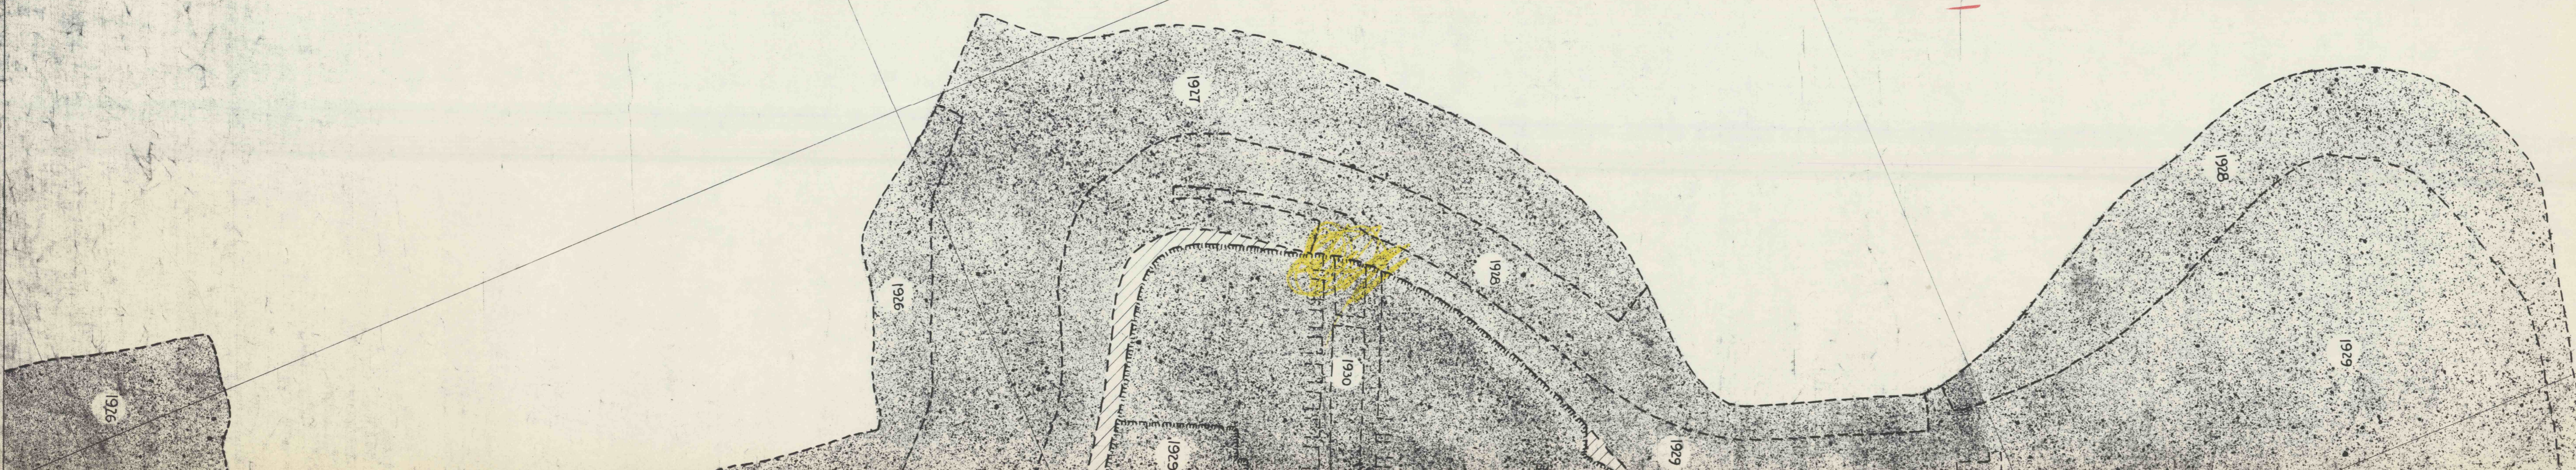

WM. DENMAN TRACT

SHEET 6
SCALE 1"=100'

FRANCIS MINE
GREENSBURG CONNELLSVILLE COAL & COKE CO.
BURGETTSTOWN PA.

Geo. S. BAYNE & Co.
ENGINEERS
PITTSBURGH, PA.
