


AVONMORE FIELD

DRILL HOLE LOCATION MAP

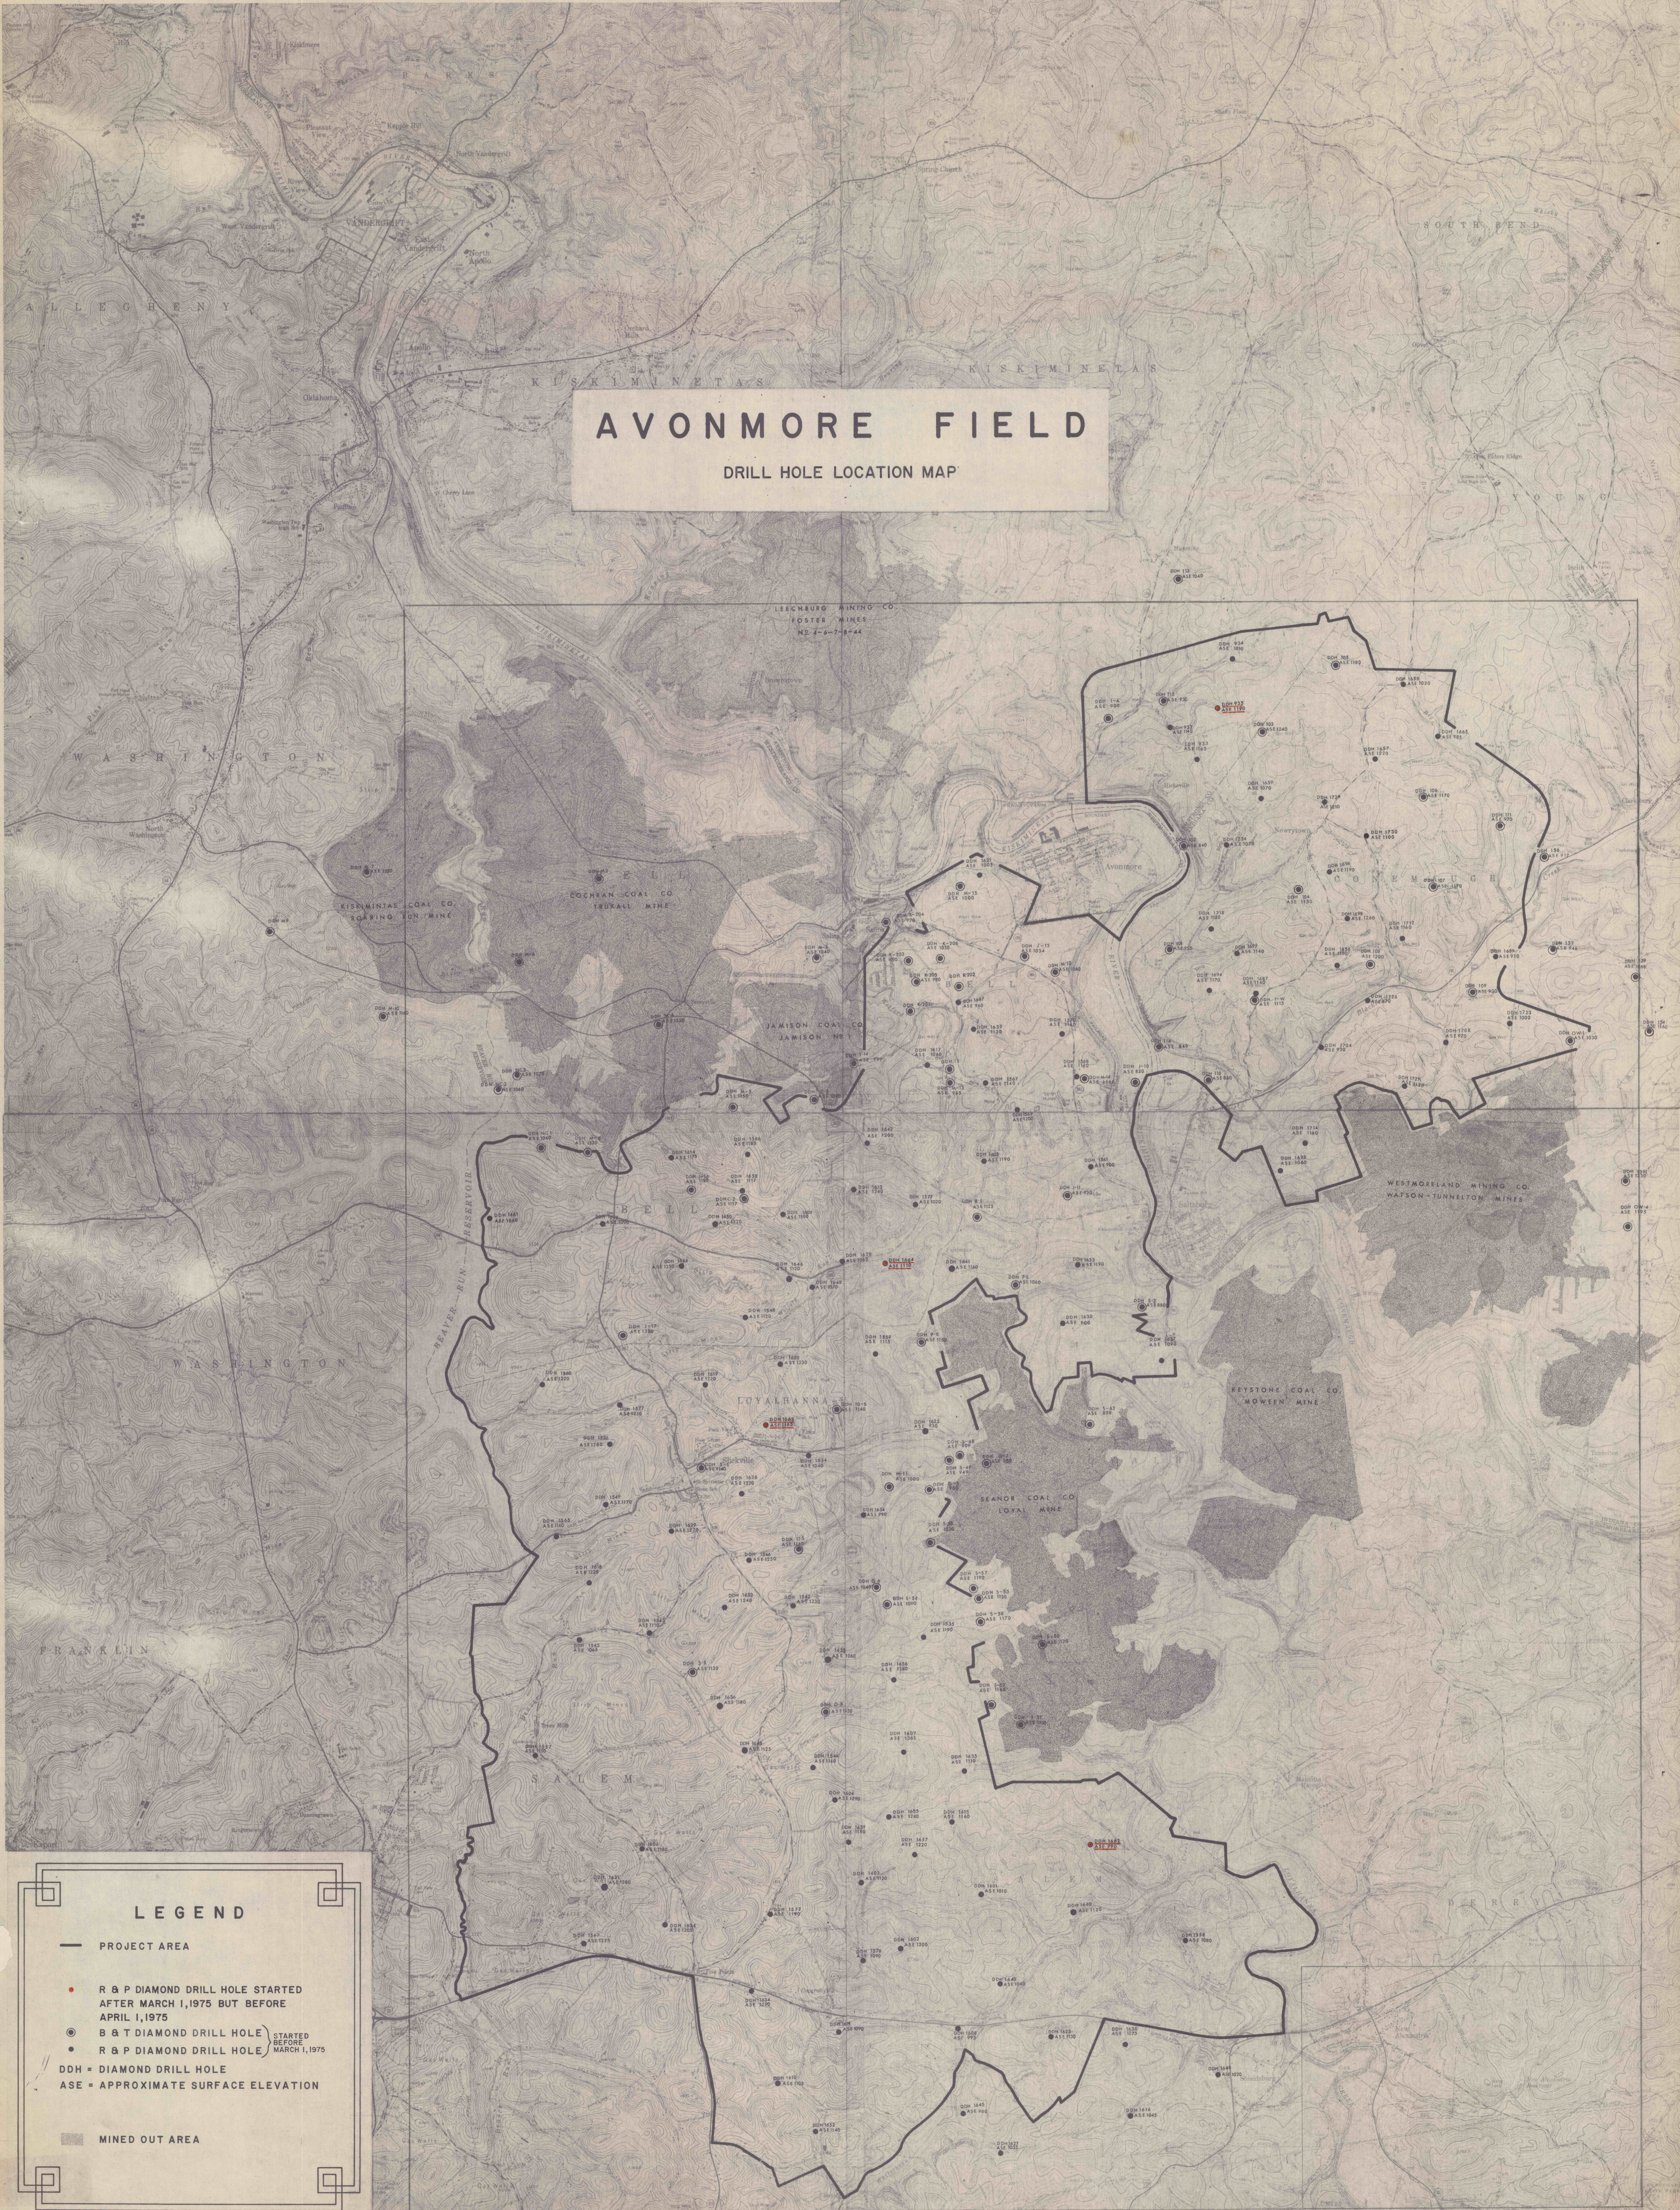

LEGEND

- PROJECT AREA
- R & P DIAMOND DRILL HOLE STARTED AFTER MARCH 1, 1975 BUT BEFORE APRIL 1, 1975
- ⊙ B & T DIAMOND DRILL HOLE STARTED BEFORE MARCH 1, 1975
- ⊕ R & P DIAMOND DRILL HOLE STARTED BEFORE MARCH 1, 1975
- DDH = DIAMOND DRILL HOLE
- ASE = APPROXIMATE SURFACE ELEVATION
- MINED OUT AREA