

**PLAT  
OF MINE  
THE ISLAND RUN COAL CO.**  
SITUATED IN BEAVER CO., PA.

Scale = 1 inch = 200 Feet.

J. A. George & Sons.  
Surveyors.

Oct. 1917.  
Jan. 18, 1917  
Aug. 25, 1917




-----  
Engineer

I the undersigned certify that I am a mine foreman at the mine represented by this map and to the best of my knowledge and belief the same correctly represents the excavations of the mine for the period ending 19

-----  
Mineforeman

----- this day ----- acknowledged before me, a ----- this day of ----- 19

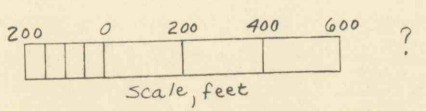

Beginning of description in deed from the Sheriff of Beaver County, Pa. to Louis J. Davidson as recorded in Sheriff's Deed Book 5, page 267, records of said County.