


BARTLEY & KELLY

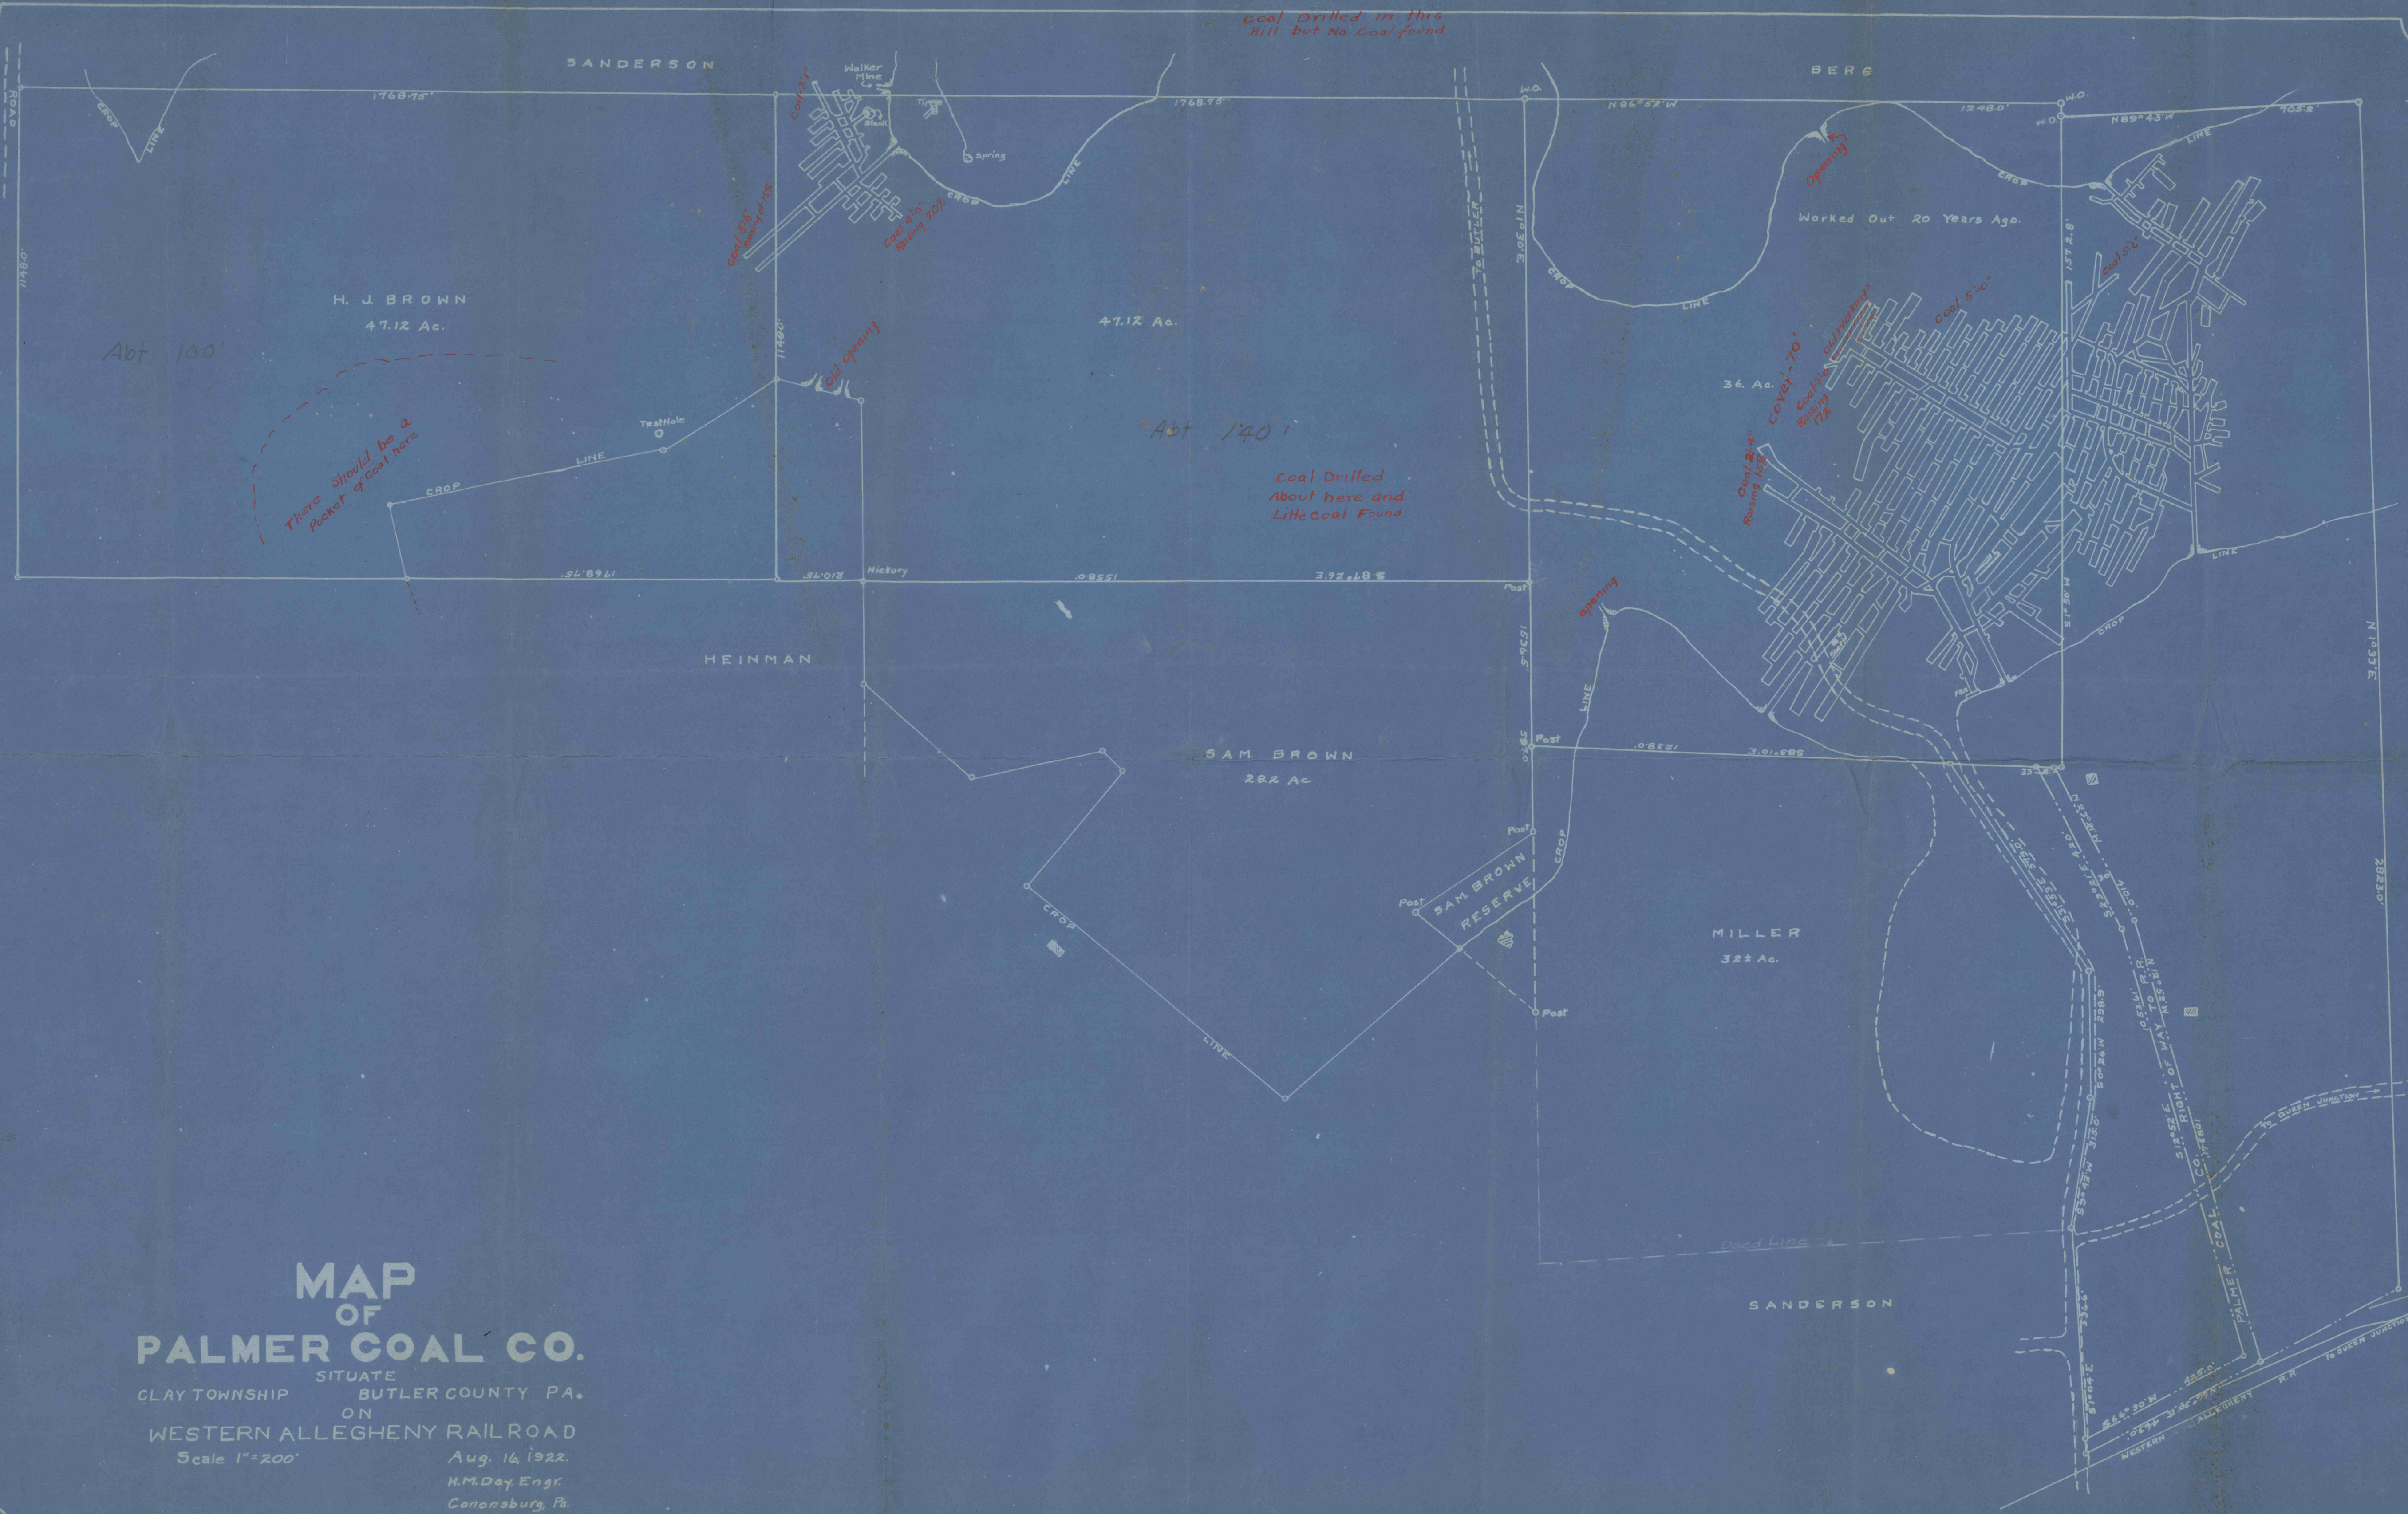

MAP OF PALMER COAL CO.
 SITUATE IN BUTLER COUNTY PA.
 ON WESTERN ALLEGHENY RAILROAD
 Scale 1"=200'
 Aug. 16, 1922.
 H.M. Day Engr.
 Canonsburg, Pa.