




LEGEND

- Underground Permit Area Boundary
- Subdivision Control Plan Boundary
- Surface Permit Boundary
- Six Month Projection Limit
- Mining projection
- Public Buildings 4-52
- Dwellings 4-51
- Dwellings 4-50
- Other Buildings 4-49
- Shed 4-48
- Garage 4-47
- Barn 4-46
- Dispersed Roadway of Environmental Protection 4-45
- Power Road 4-44
- Highway Waste Office 4-43
- Legislative Route 4-42
- State Route 4-41
- Township Route 4-40
- Beach Mark 4-39
- Tree Line 4-38
- Swamp 4-37
- Upper Kittanning Coal Contour 4-36
- Jennette B-Seam Mine Limits 4-35
- Grove No. 1 Mine Elevations 4-34
- Surface Property 100' and Over Within Six Month Mining Projection Area 4-33
- Coal Refuse Disposal Area 4-32
- Drain Mined 4-31
- Intermittent stream 4-30
- Potential Stream 4-29
- Pre-Grove Resources, Inc. Spade 4-28
- Grove Resources, Inc. Spade 4-27

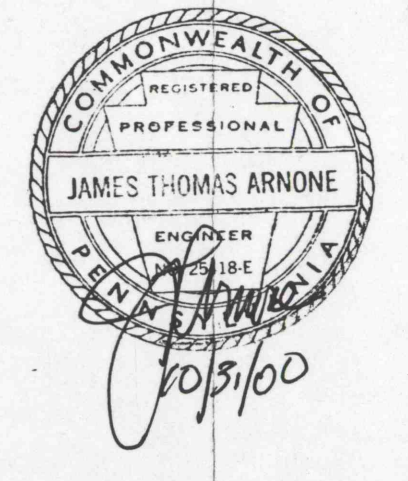

SEAL

SHEET INDEX

GROVE No. 1 MINE
UPPER KITTANNING COAL SEAM
 Junior and Co. and Commonwealth Township, Somerset County, PA
 MESA ID # 9-22299 Permit # 56841306
 SCALE 1" = 200' SURVEY DATE: as of 10/23/00
SIX MONTH PROJECTIONS
MINING PERIOD: 11/01/04 TO 04/30/01

Mine Address: 1701 Lion Road, Boswell, PA 15531
 Permitting: Lion Mining Company, P.O. Box 209, Jenessville, PA 15547, Permit # 56841306
 Control Operator: Grove Resources, Inc., P.O. Box 270, Jenessville, PA 15547, Attn: John T. Strivie, Mine Foreman

Note: Property lines taken from Somerset County Tax Maps, and do not represent actual surveys.