


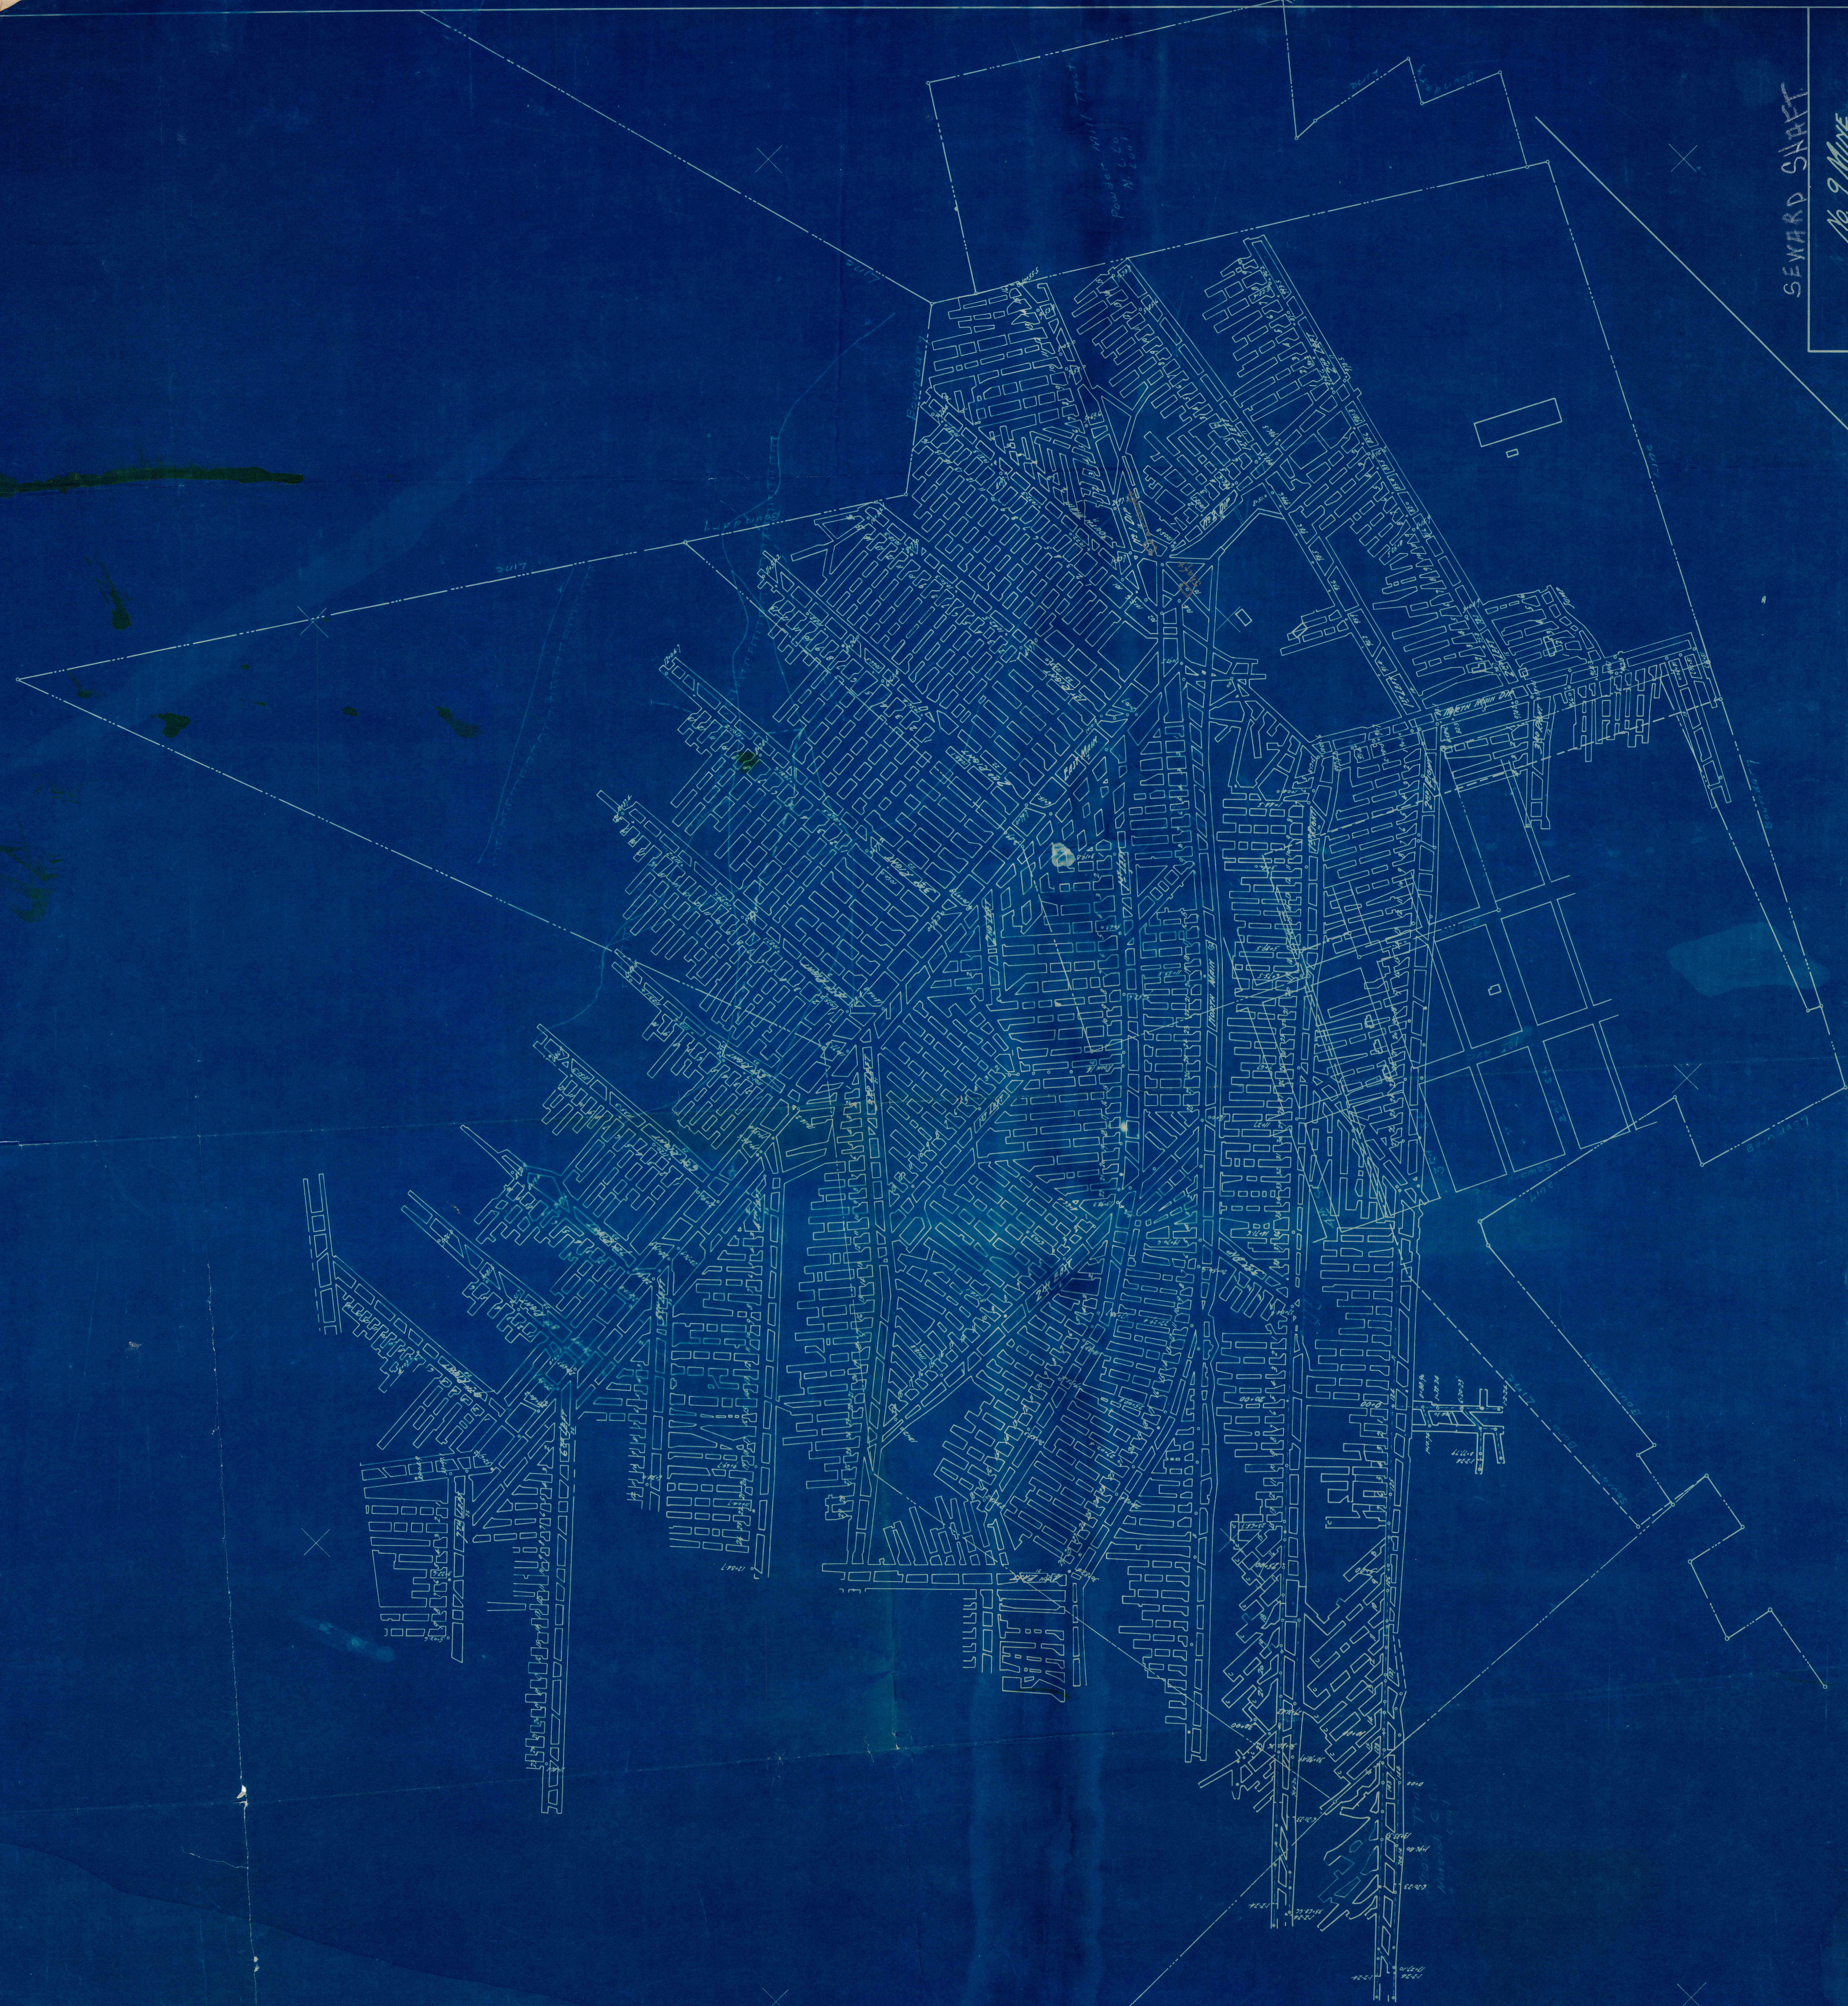

SEWARD SHAFT

No. 9 MINE





