


Mined Out

5 Acre Line

3 Acre Line

1½ Acre Line

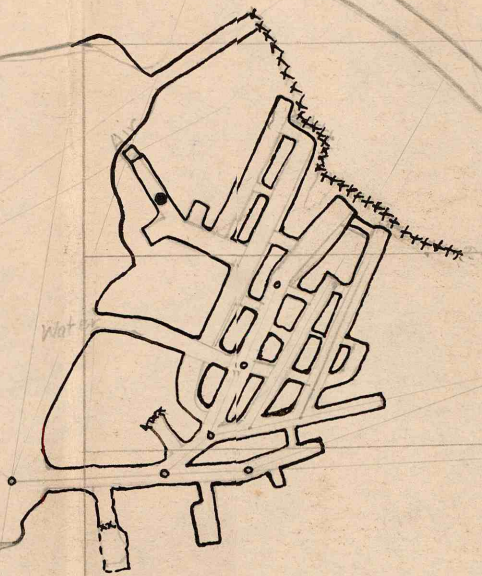

Road

Possible 3.0 Acres

5
4
3
2
1
0