


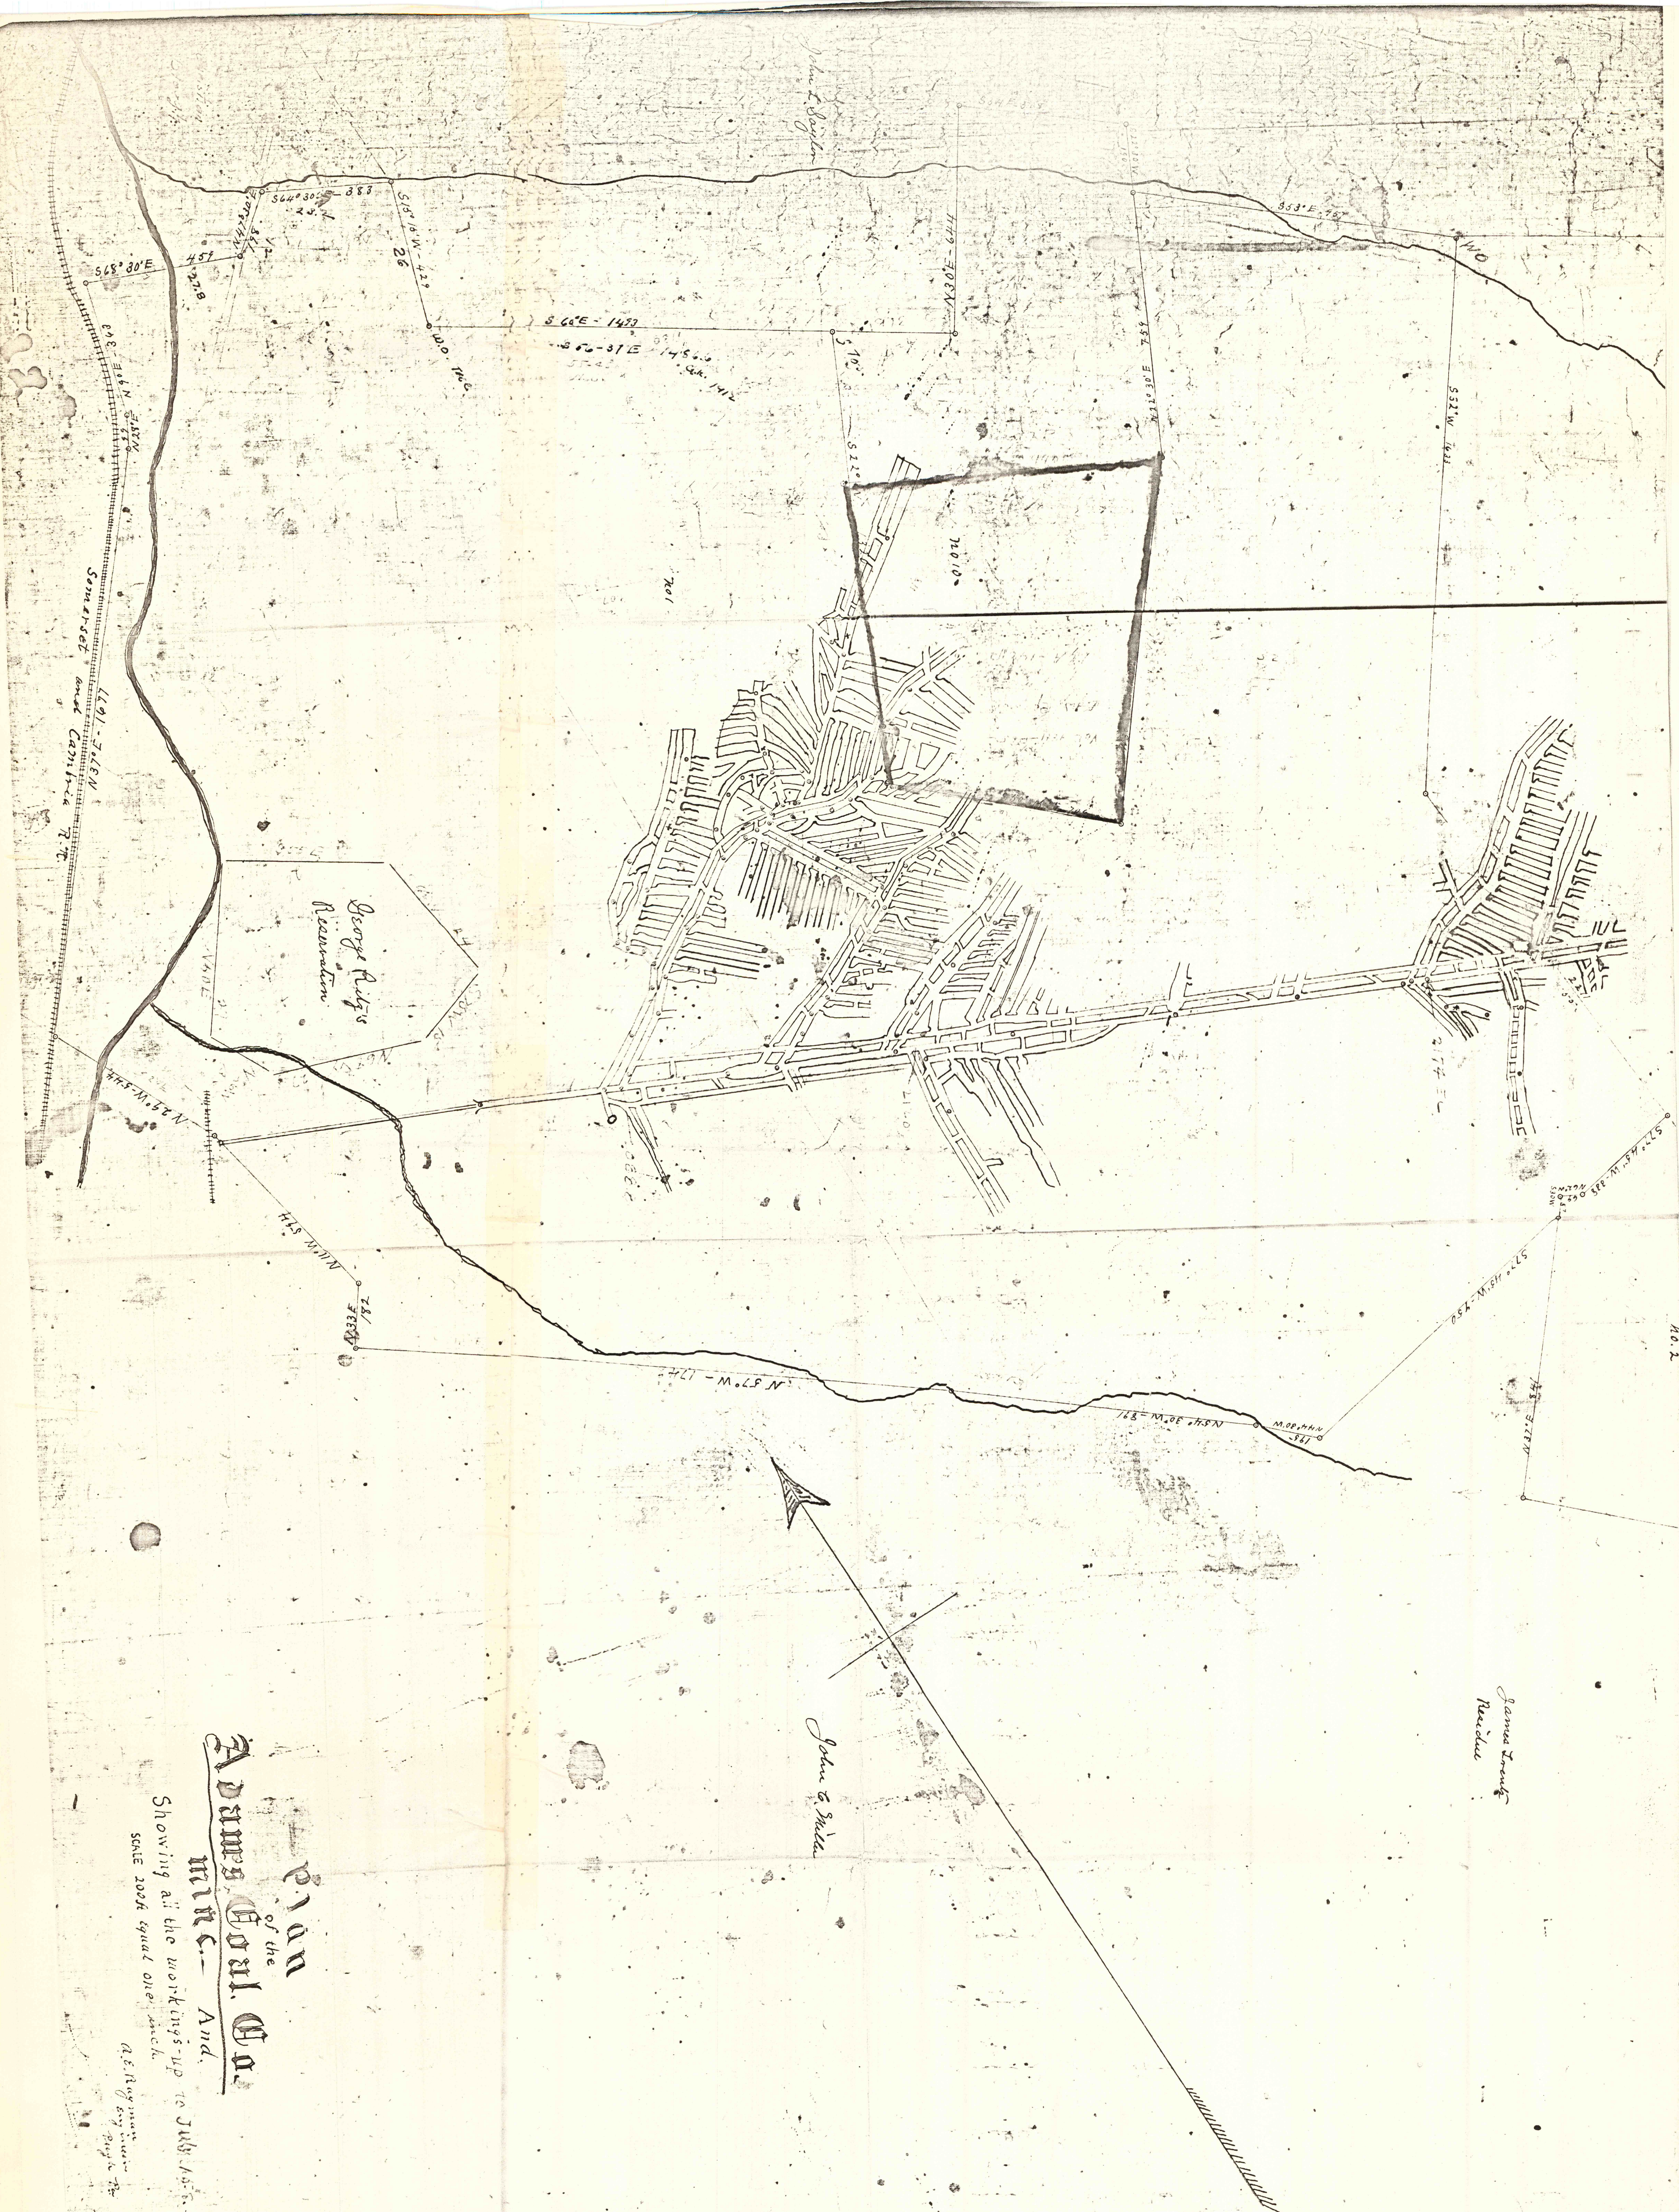

Pian
 of the
 James Fort. Wa.
 mite. And.

Showing all the workings up to July 19th 1902
SCALE 200ft equal one inch
A.E. Ryman
of Englewood

James French
Residue :

John C. Miller