


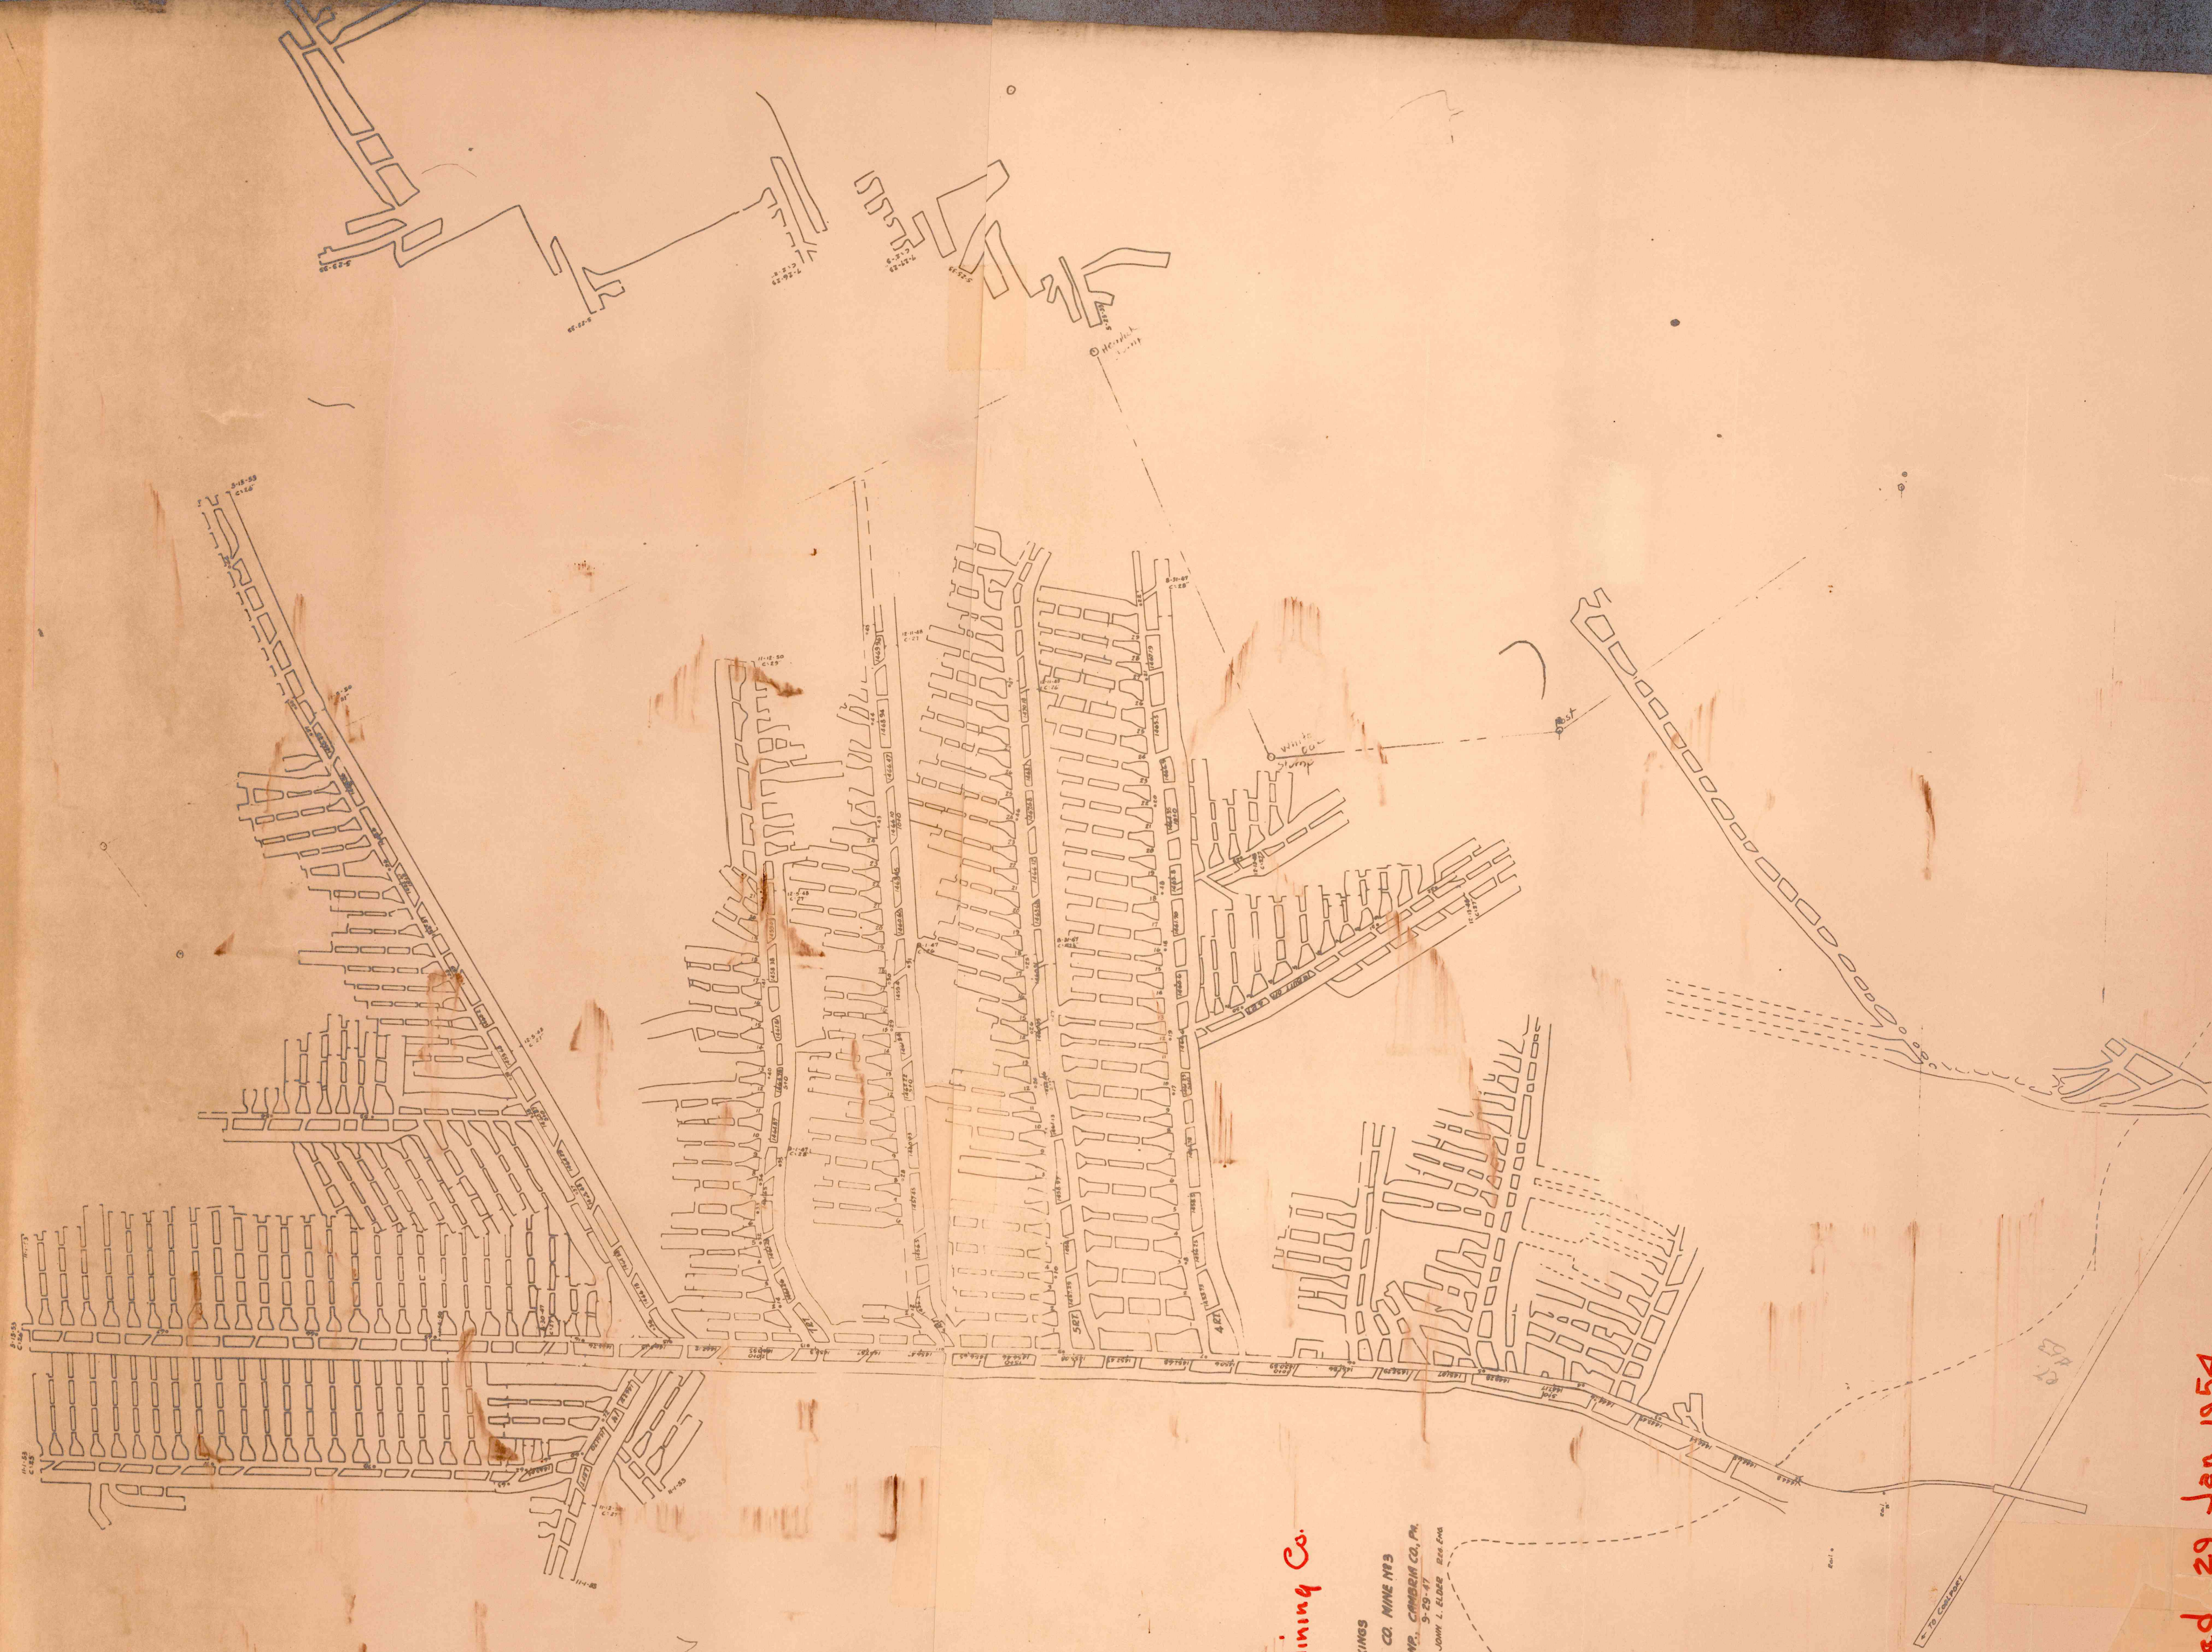

Apple Coal Mining Co.

MAP
Showing
2" - 25' WORKINGS
CARBON MILLS COAL CO. MINE NO. 3
SCALE: 1" = 200'

Filed 29 Jan. 1954

1" = 200'

Filed
Cab. - "F"
Drawer #5