


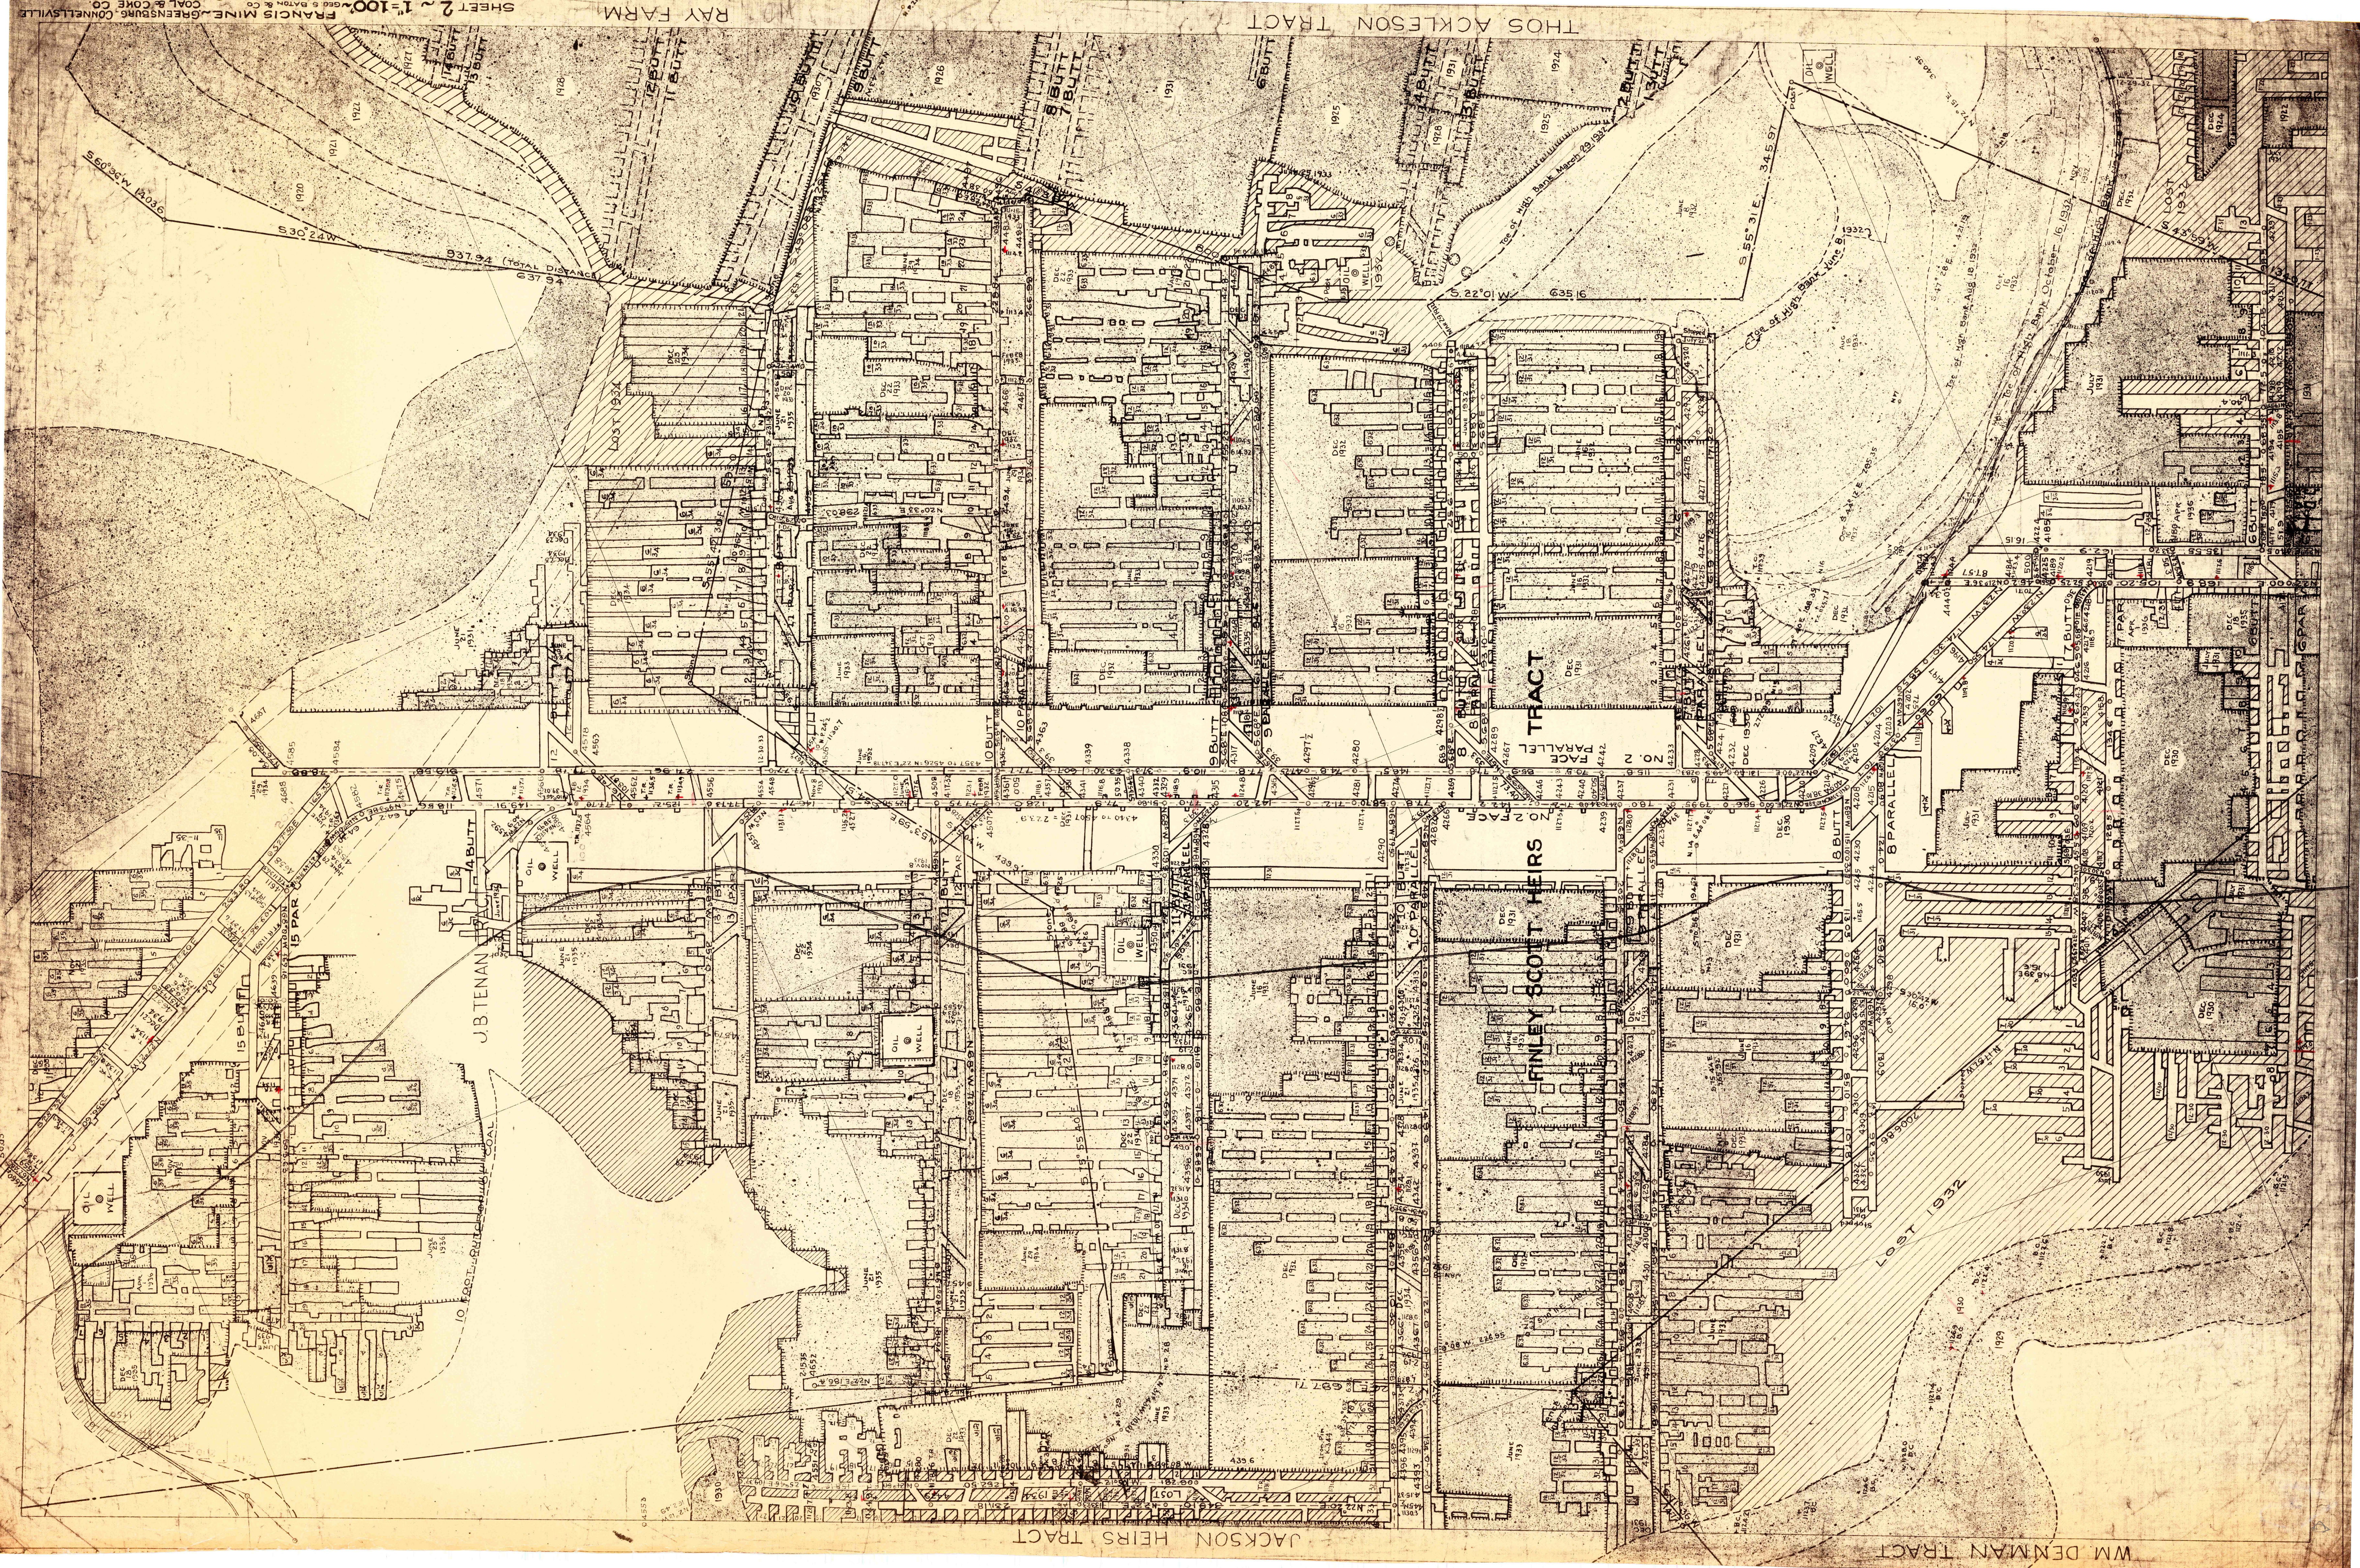

RAY FARM

THOS ACKLESSEN TRACT

JACKSON HEIRS TRACT

WM DENMAN TRACT

FINLEY SCOTT HEIRS

TRACT

10 FOOT LANE

15 FOOT LANE

LOST 1932

LOST 1933

1931

1932

