


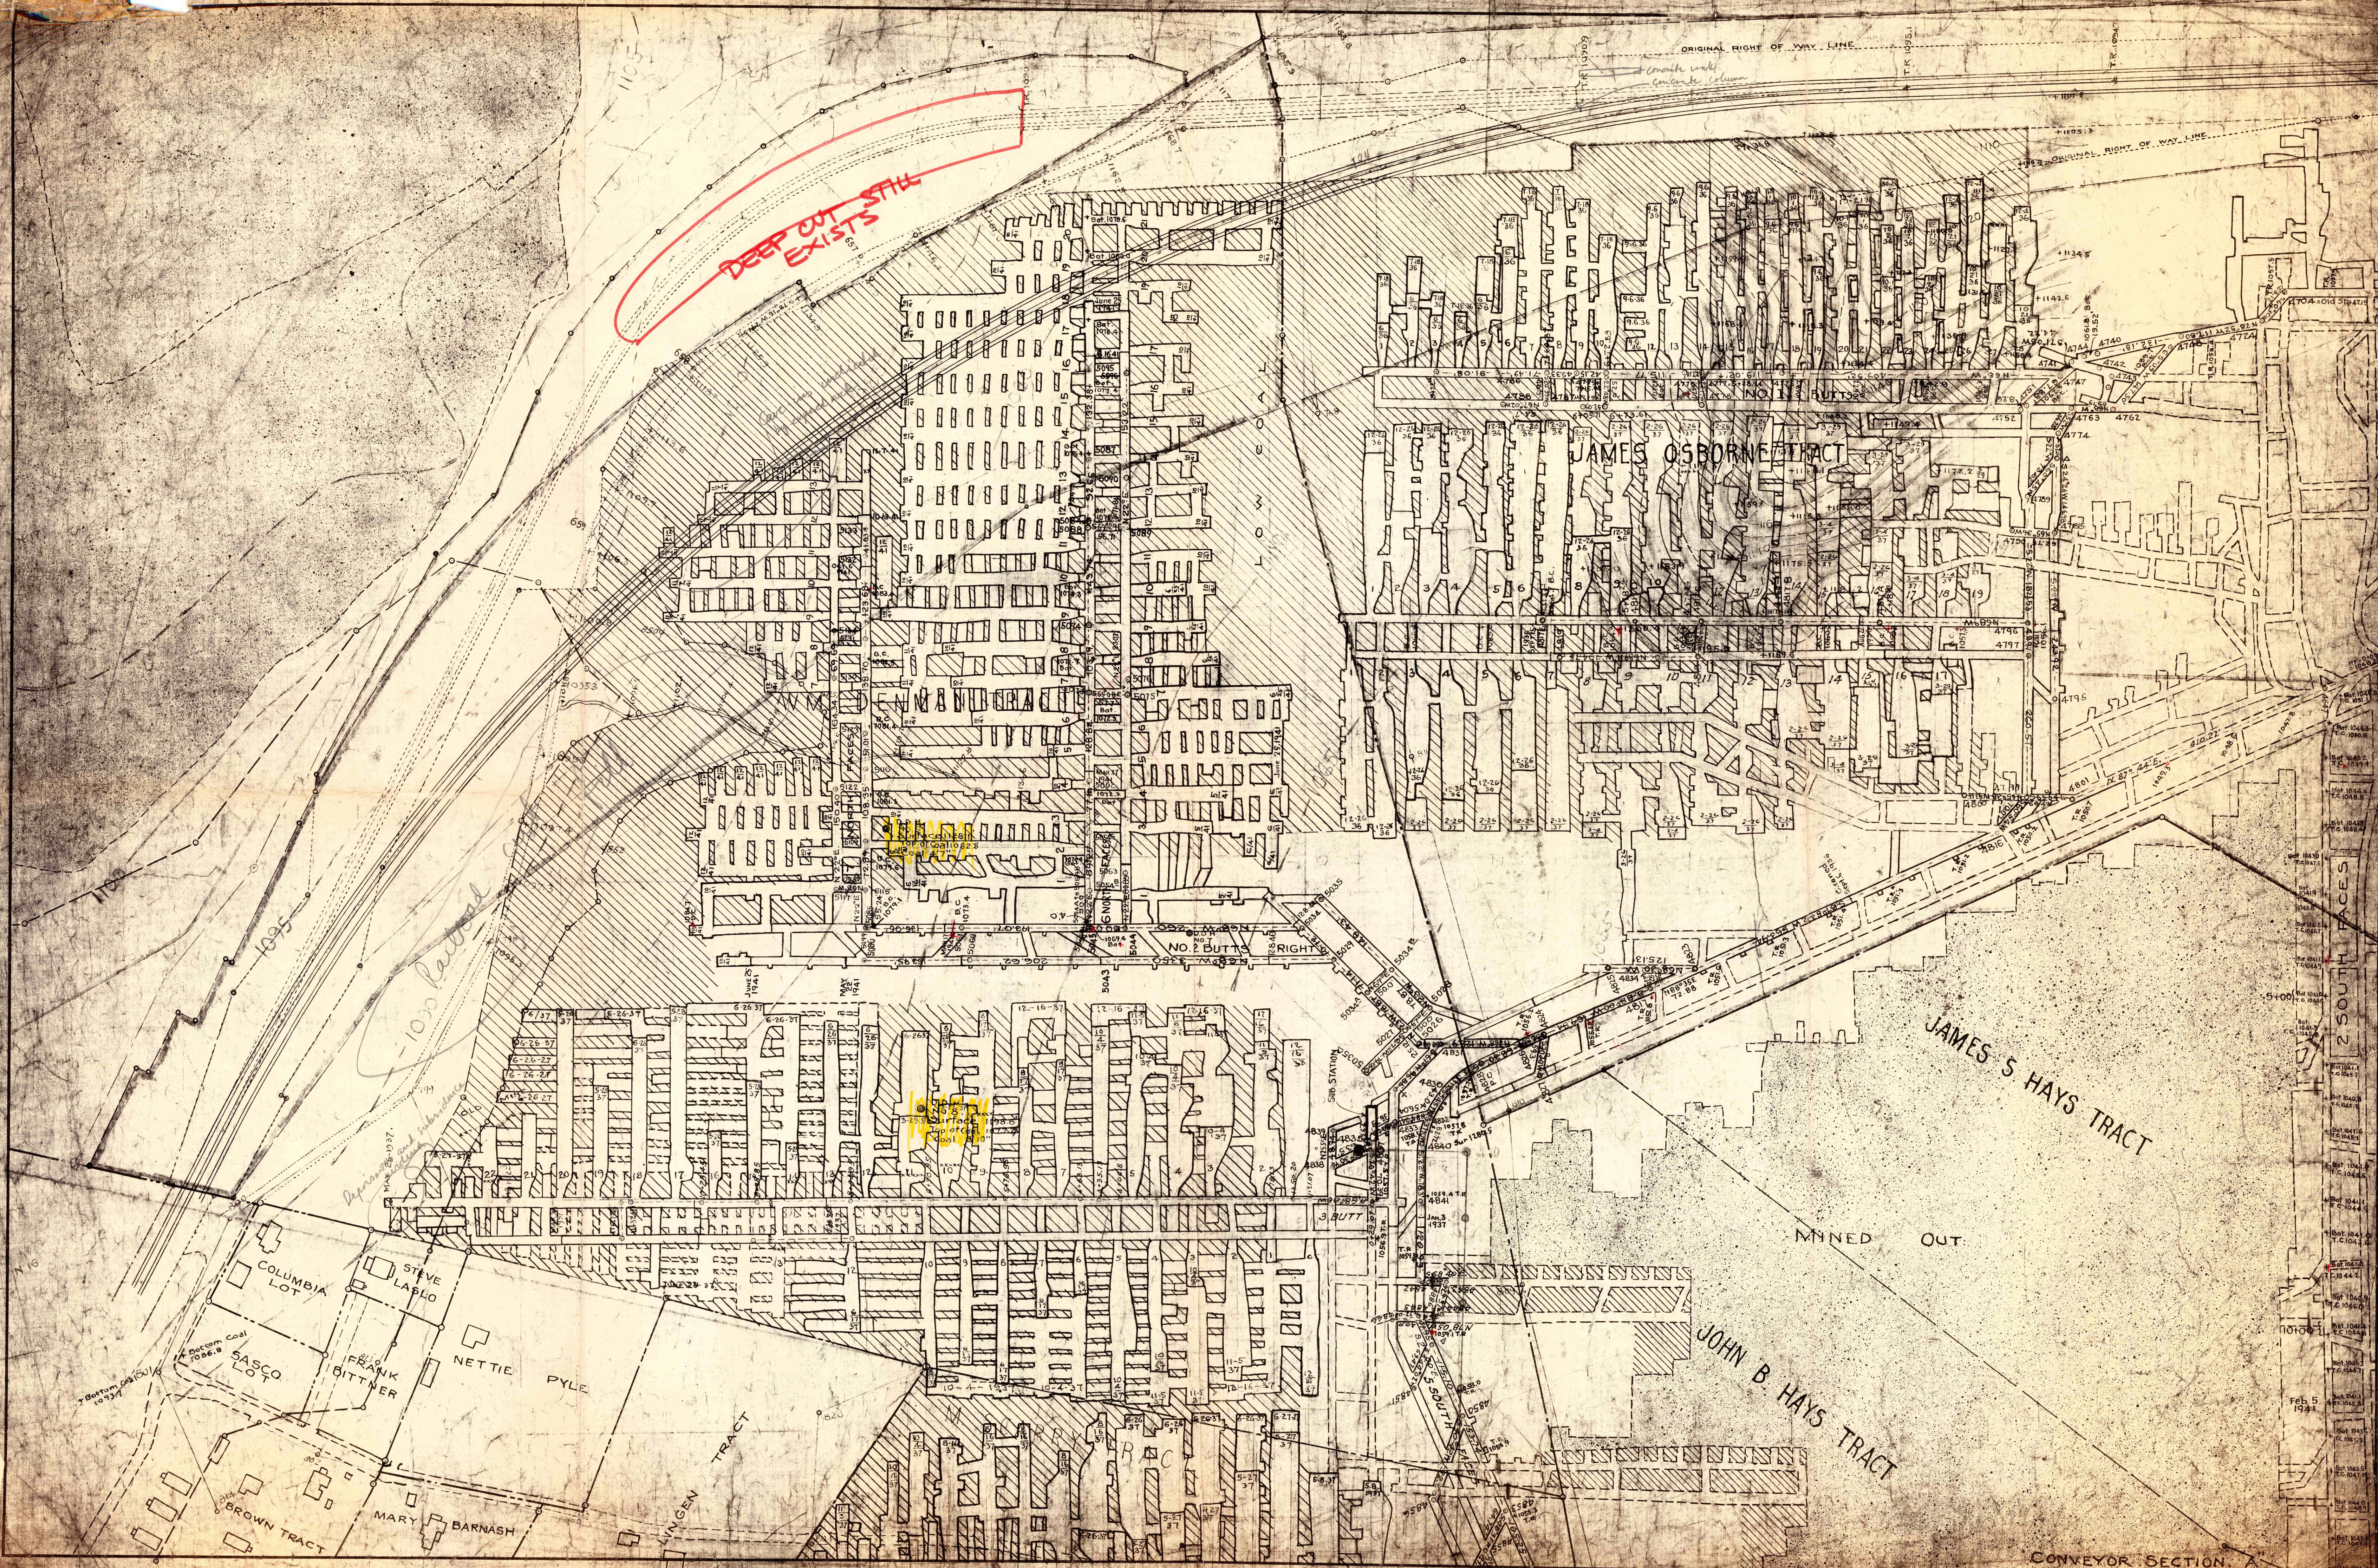

DEEP CUT STILL EXISTS

JAMES OSBORNE TRACT

JAMES S. HAYS TRACT

JOHN B. HAYS TRACT

COLUMBIA LOT

SASCO LOT

STEVE LAPLO

FRANK BITTNER

NETTIE PYLE

BROWN TRACT

MARY BARNASH

LINGEN TRACT

CONVEYOR SECTION A

