





- LEGEND**
- 50% Mining Area
 - Next 6 Mo. Mining Area
 - Support Areas
 - Mining Complete
 - Boundary Line
 - 1-1-70 to 7-1-70
 - No Mining

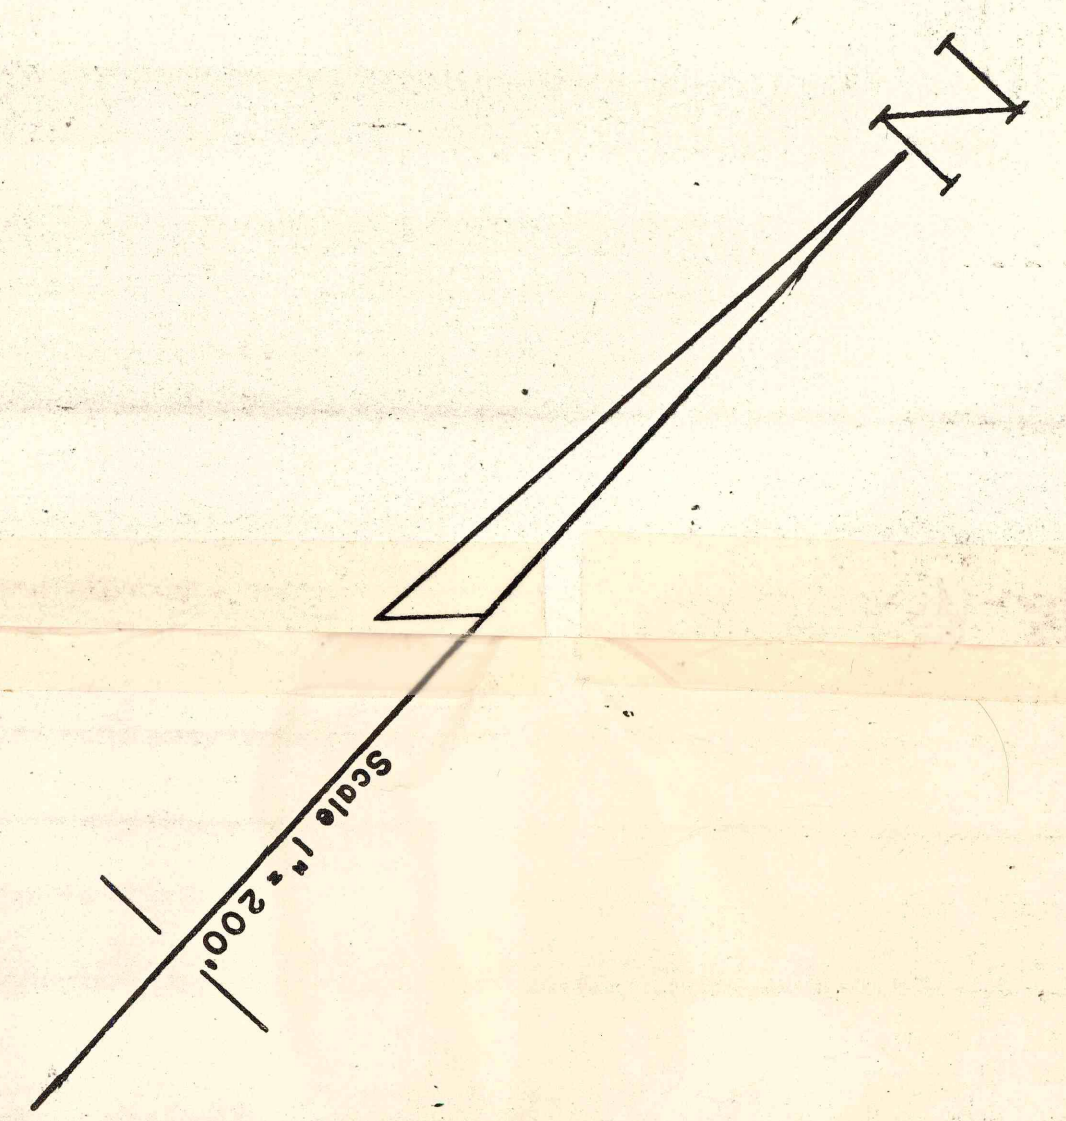

TRENT COAL COMPANY
TRENT MINE
Upper Kittanning seam "Cpr."
Somerset & Stonycreek Twp.
Somerset, County Pa.
Dec. 12, 1966 SCALE 1"=200'

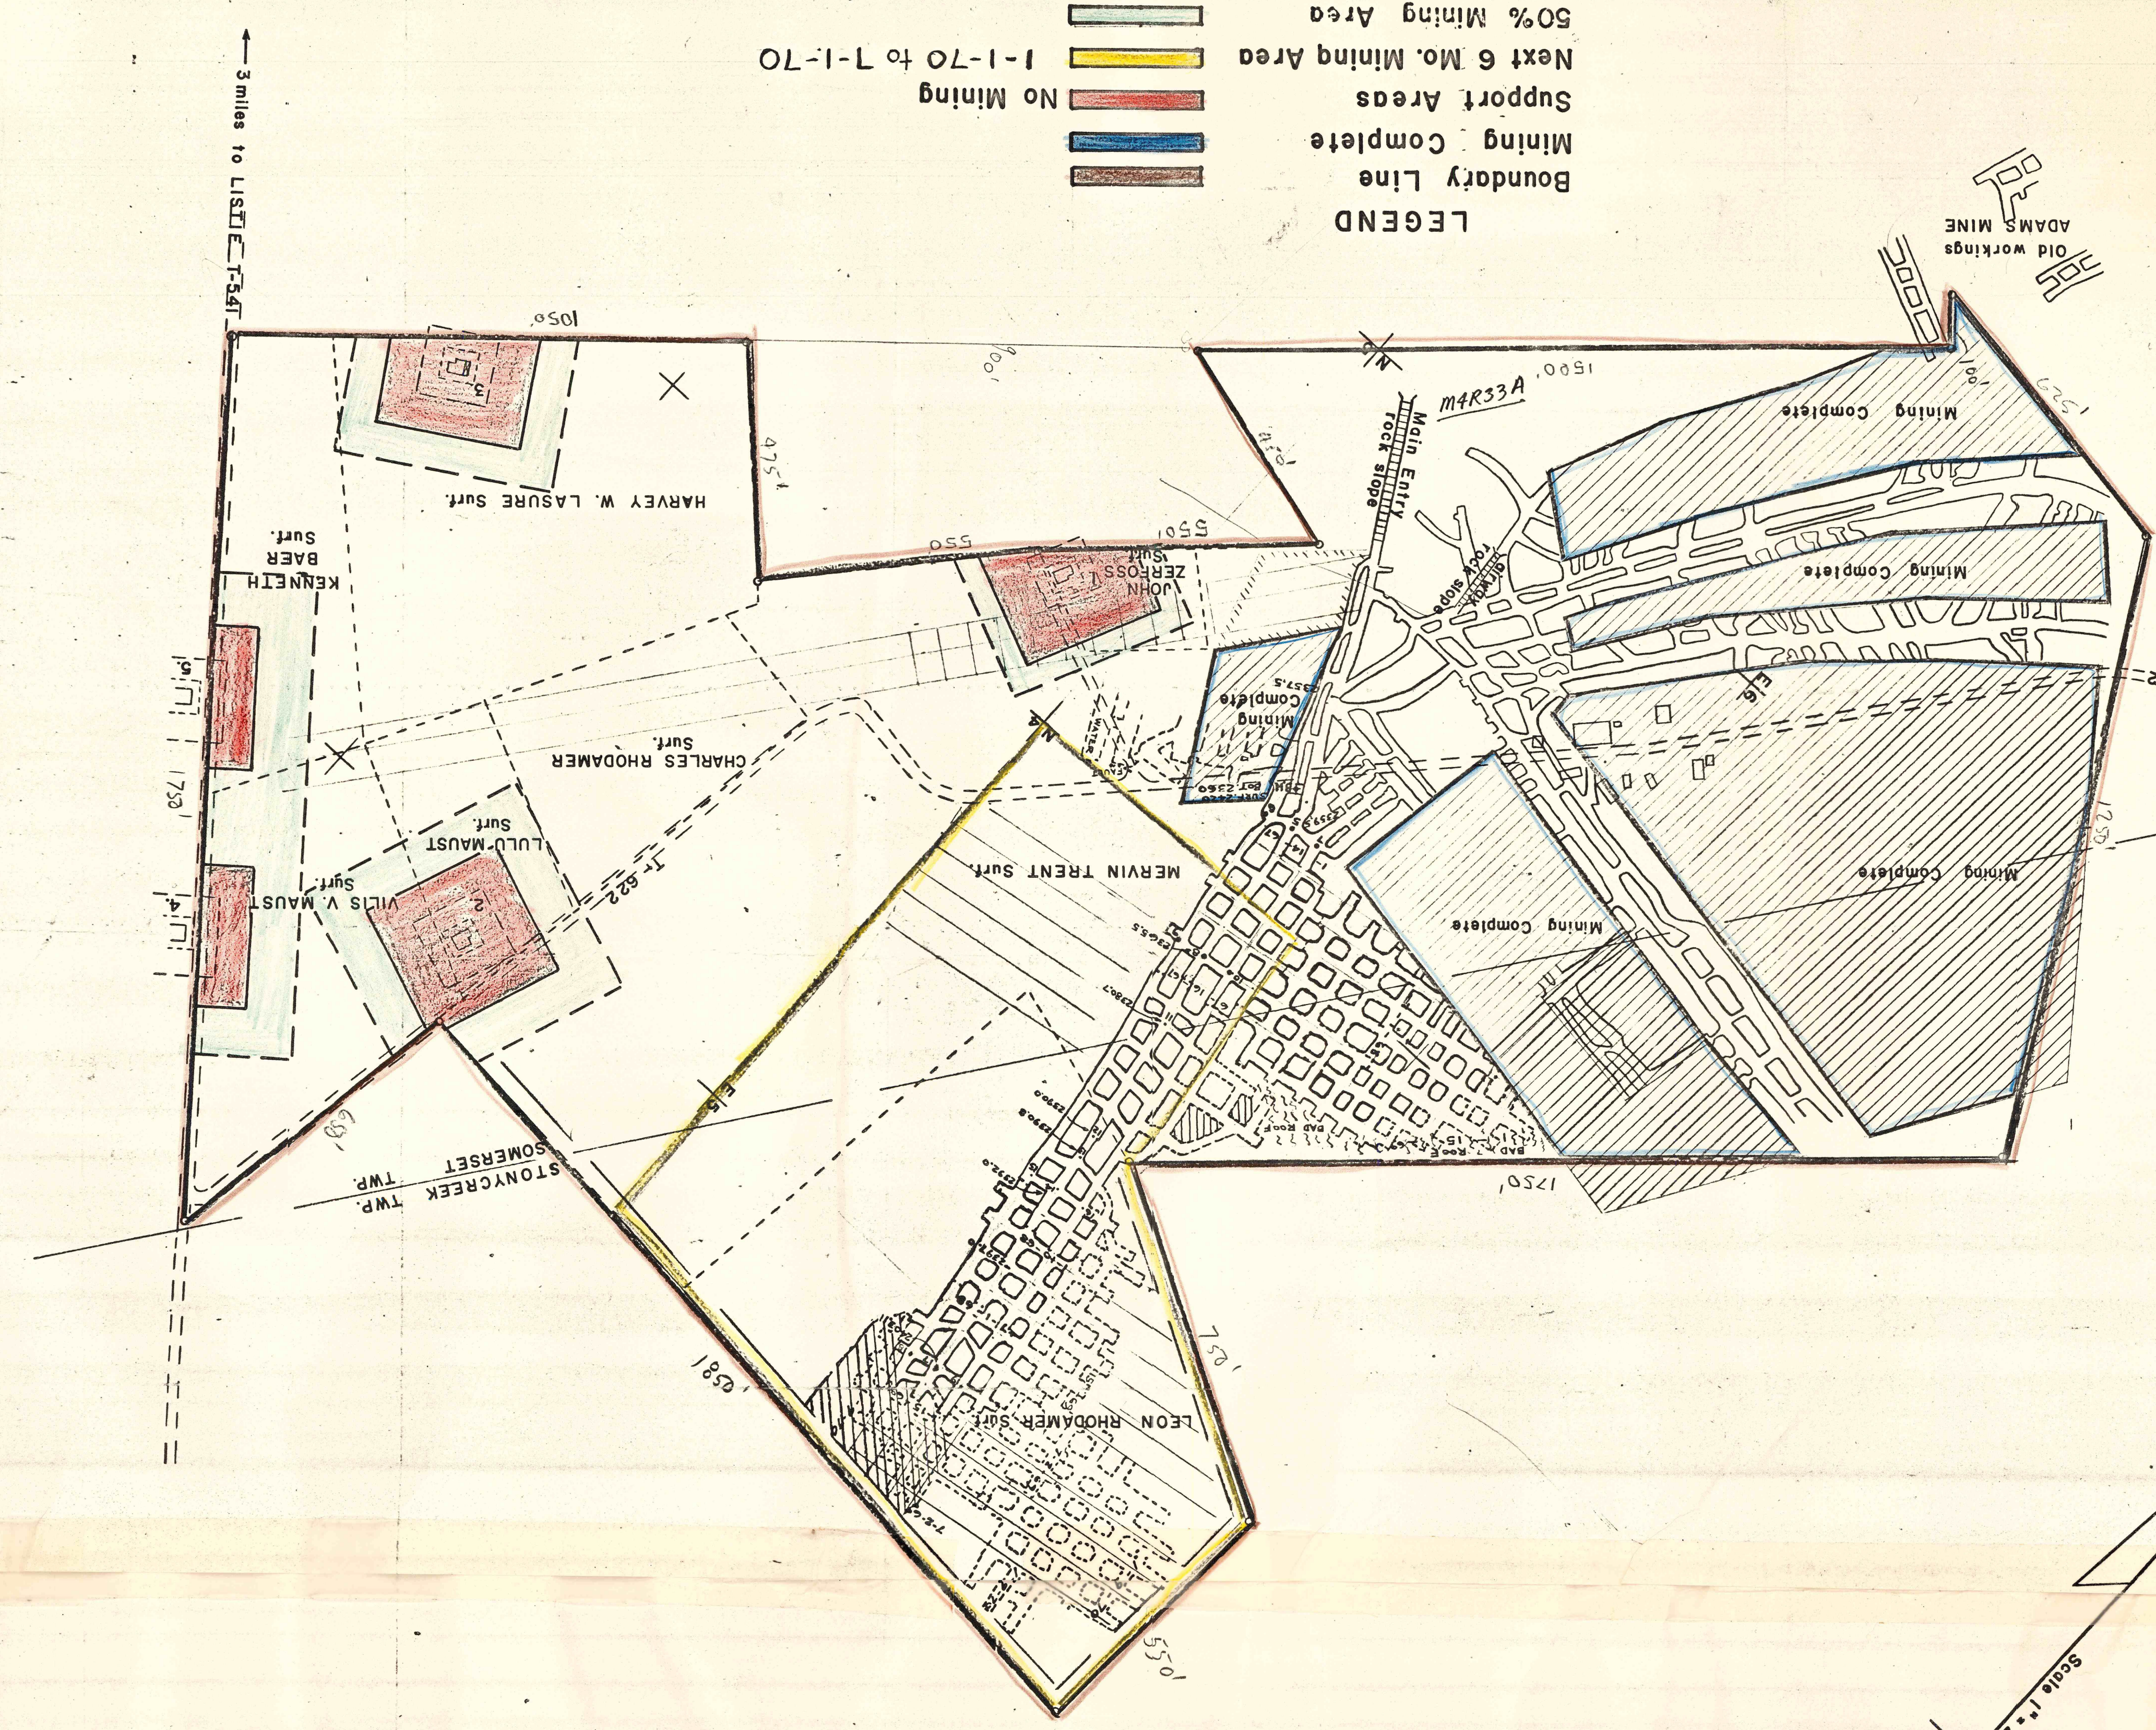

12000
13000
12000
35000
15
49000 130000

TRENT COAL CO
JAN 1970