


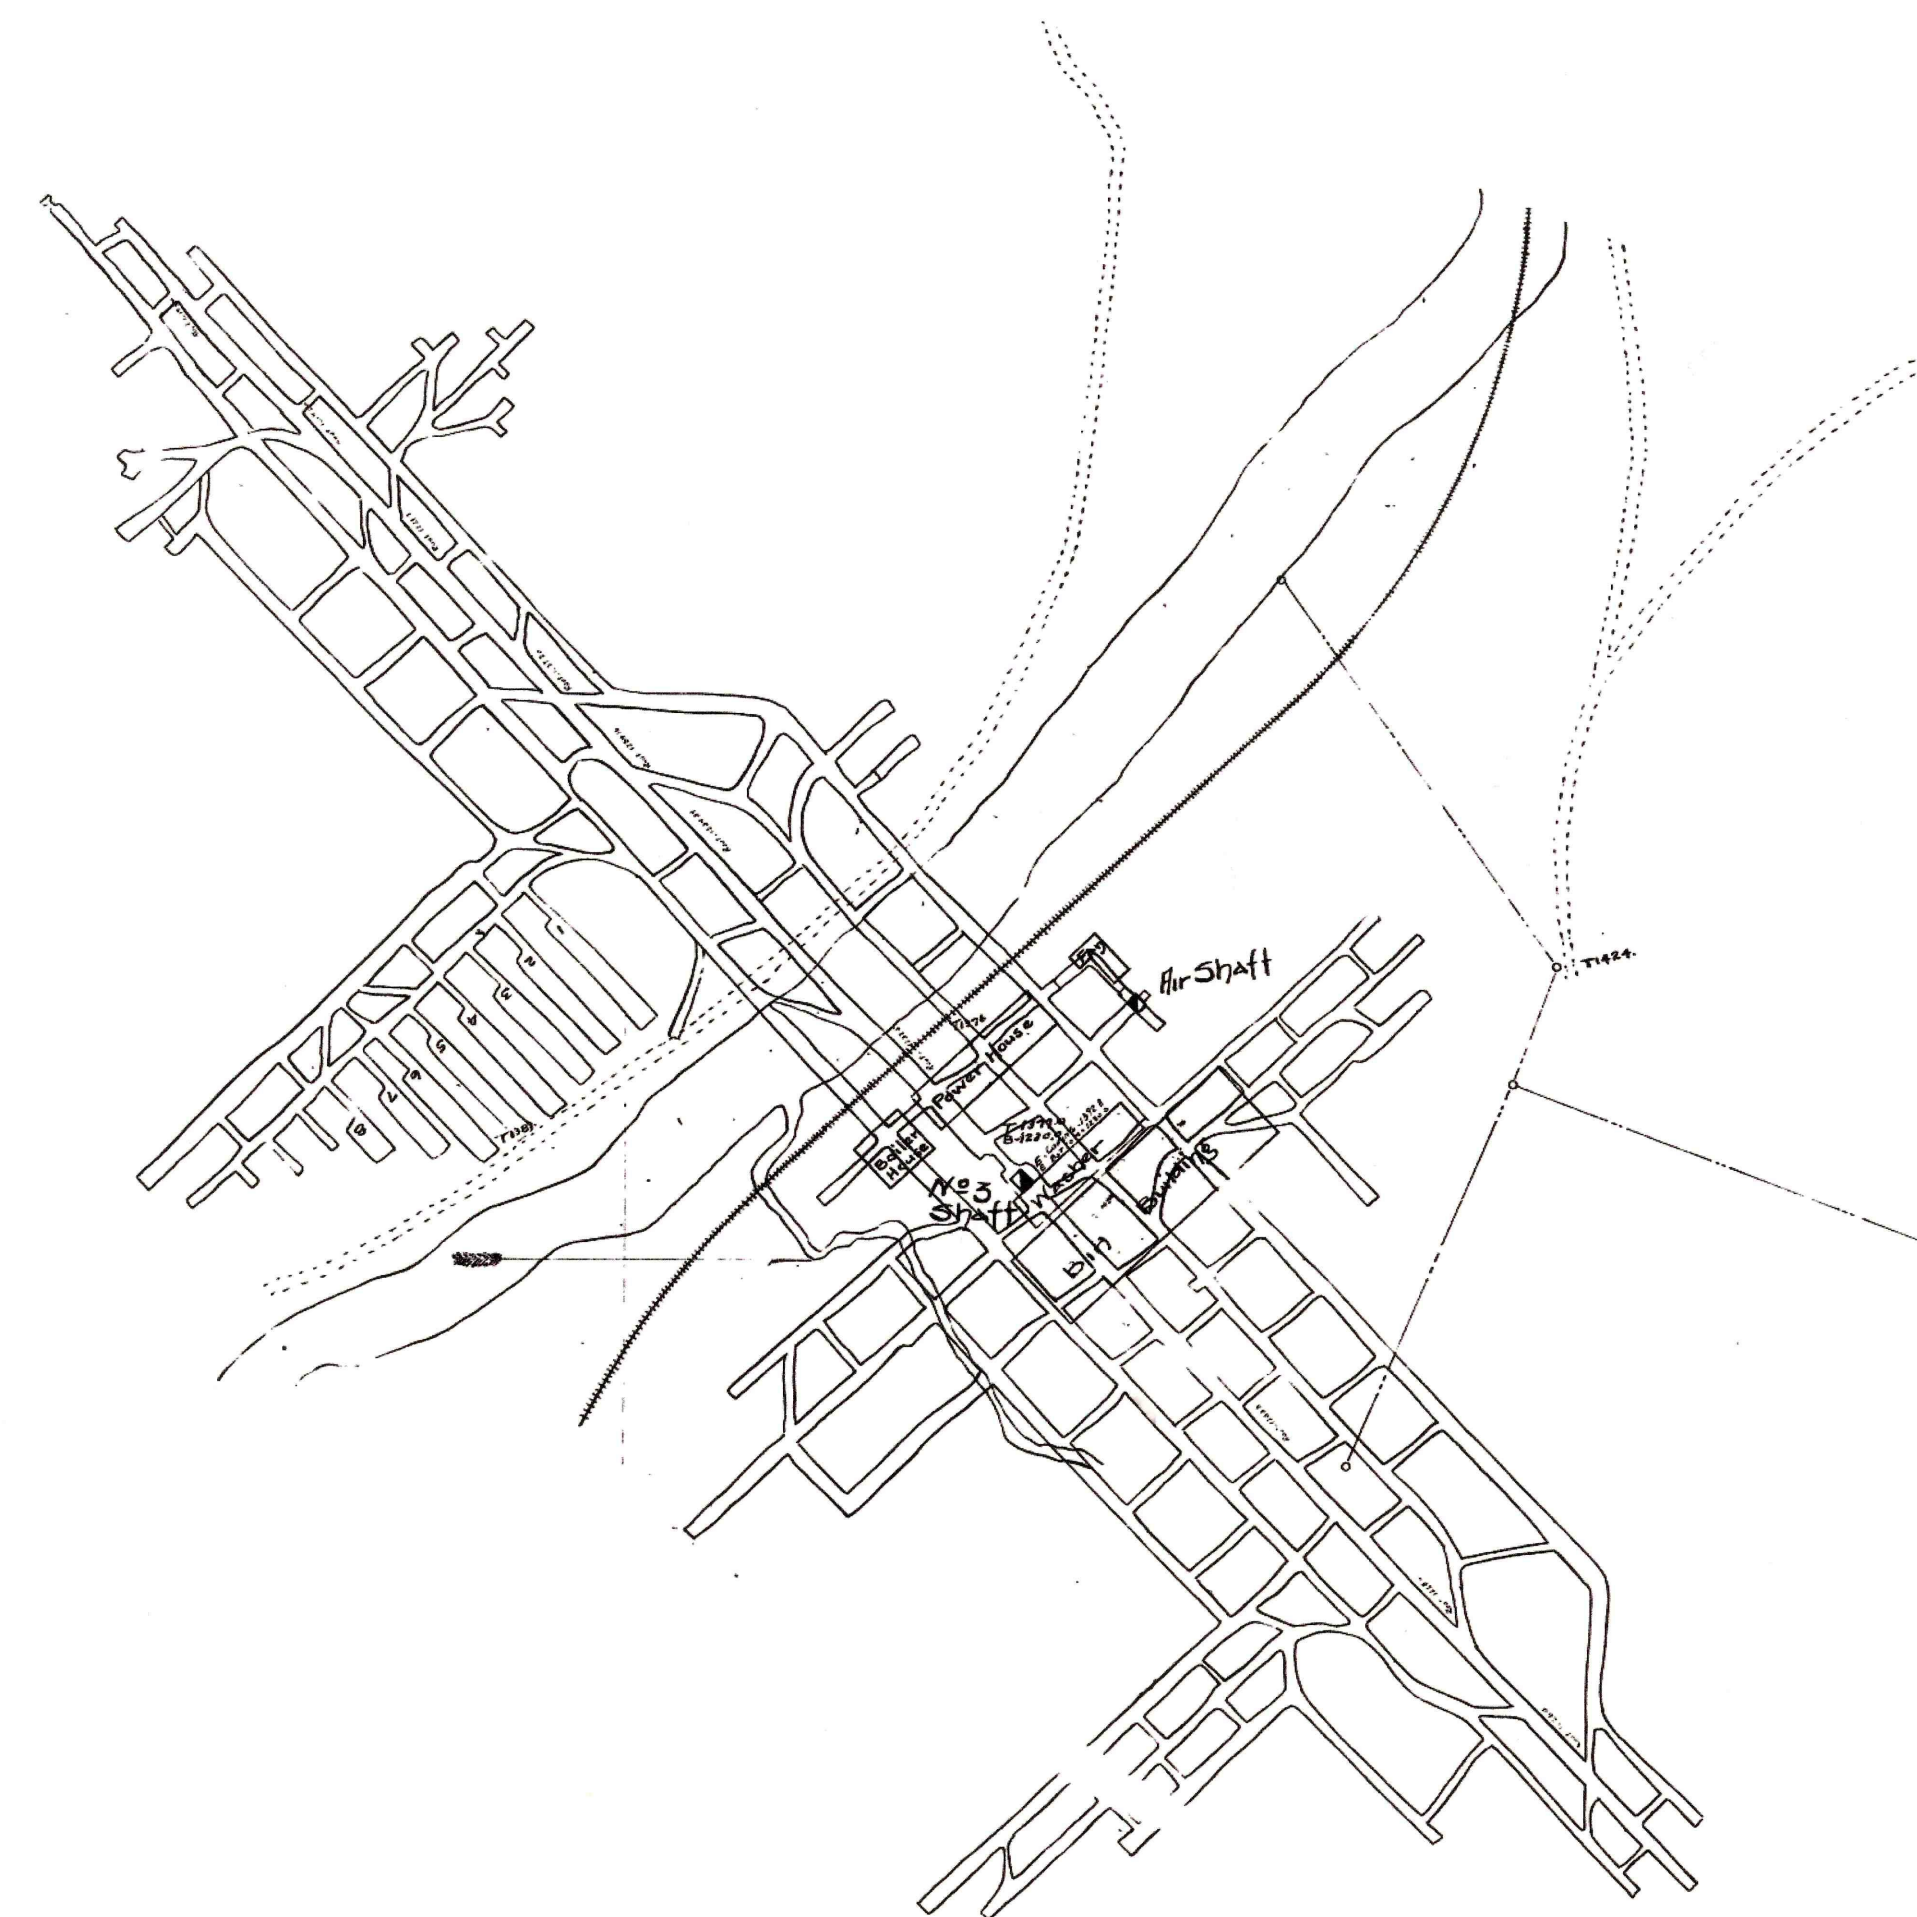

W12C - M1115 1982

Lacawanna #3 mine #1535.tif