


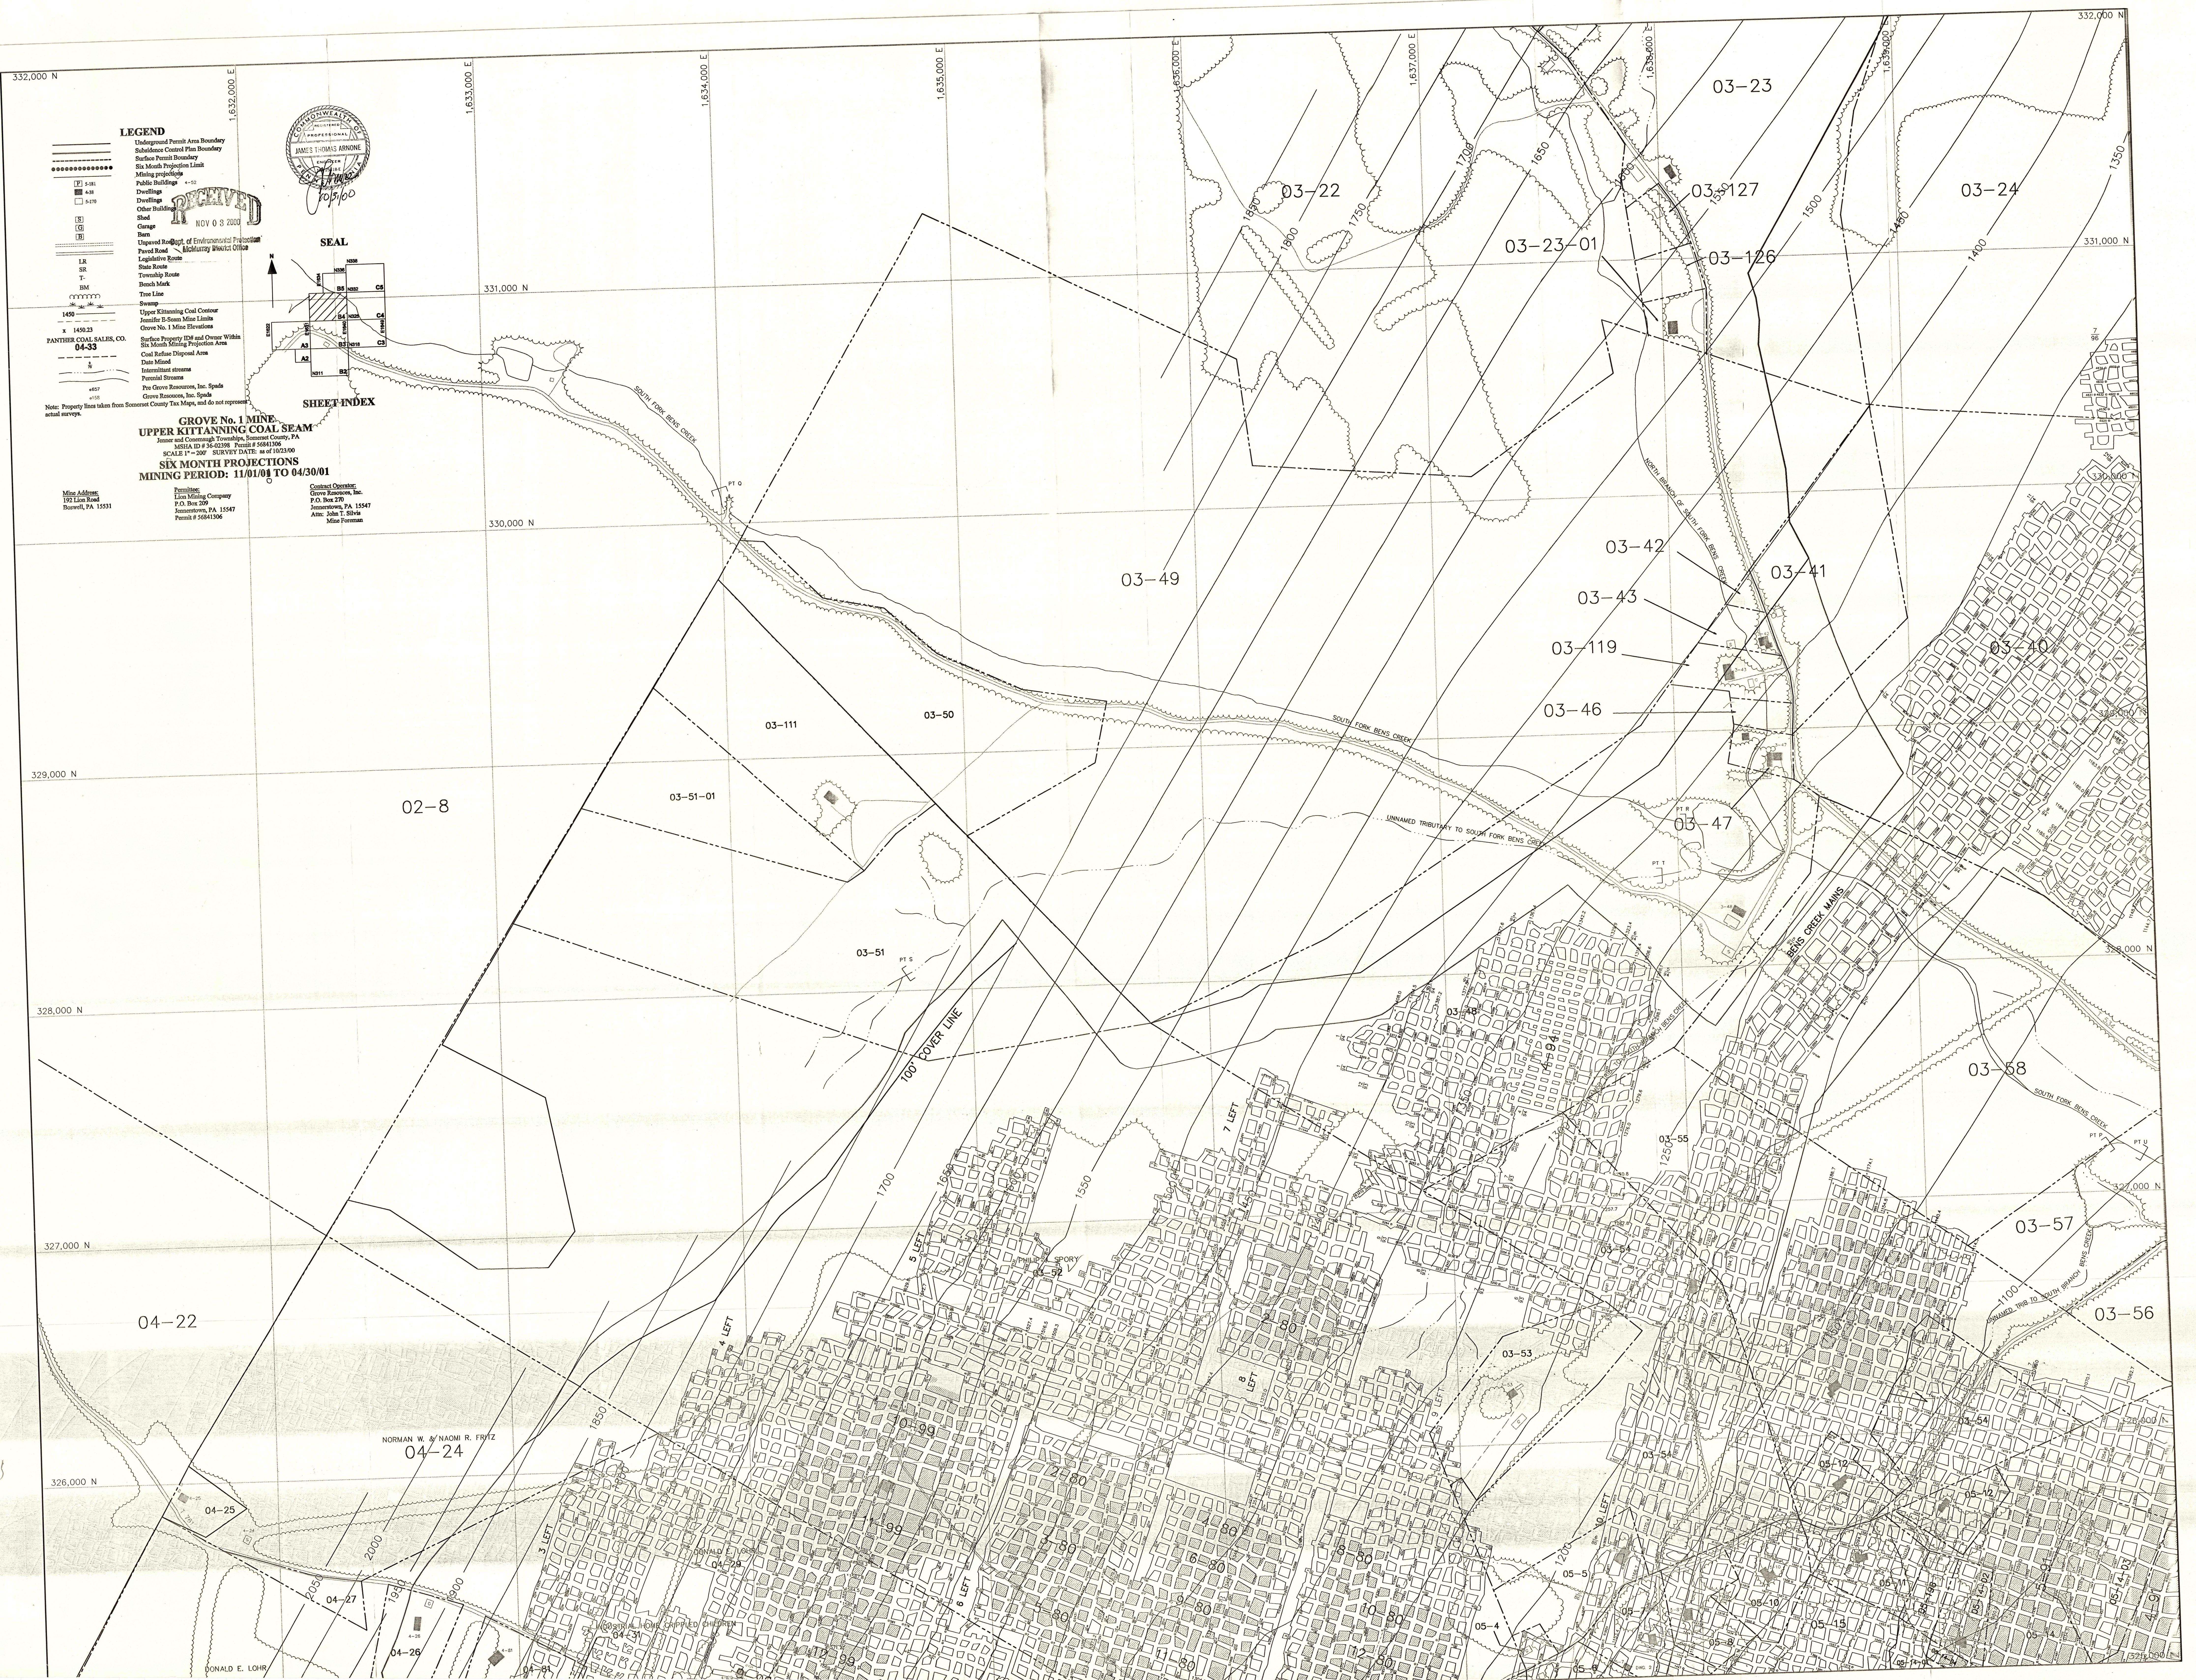

LEGEND

- Underground Permit Area Boundary
- Subsidence Control Plan Boundary
- Surface Permit Boundary
- Six Month Projection Limit
- Mining projection
- Public Buildings
- Dwellings
- Other Buildings
- Shed
- Garage
- Burn
- Unpaved Roadway of Environmental Protection
- Paved Road
- Legislative Route
- State Route
- Township Route
- Bench Mark
- Tree Line
- Swamp
- Upper Kittanning Coal Contour
- Jennifer S-Seam Mine Limits
- Surface Property ID# and Owner Within Six Month Mining Projection Area
- Coal Refuse Disposal Area
- Intermittent stream
- Perennial Stream
- Panther Coal Sales, Inc. Spade
- Grove Resources, Inc. Spade

SEAL

SHEET INDEX

GROVE No. 1 MINE
UPPER KITTANNING COAL SEAM
MSEA ID # 36-02398 Permit # 56841306
SIX MONTH PROJECTIONS
MINING PERIOD: 11/01/01 TO 04/30/01

Miner Address:
192 Lion Road

Permittee:
Lion Mining Company
P.O. Box 209
Mine Foreman

Contract Operator:
Grove Resources, Inc.
P.O. Box 170
Mine Foreman