


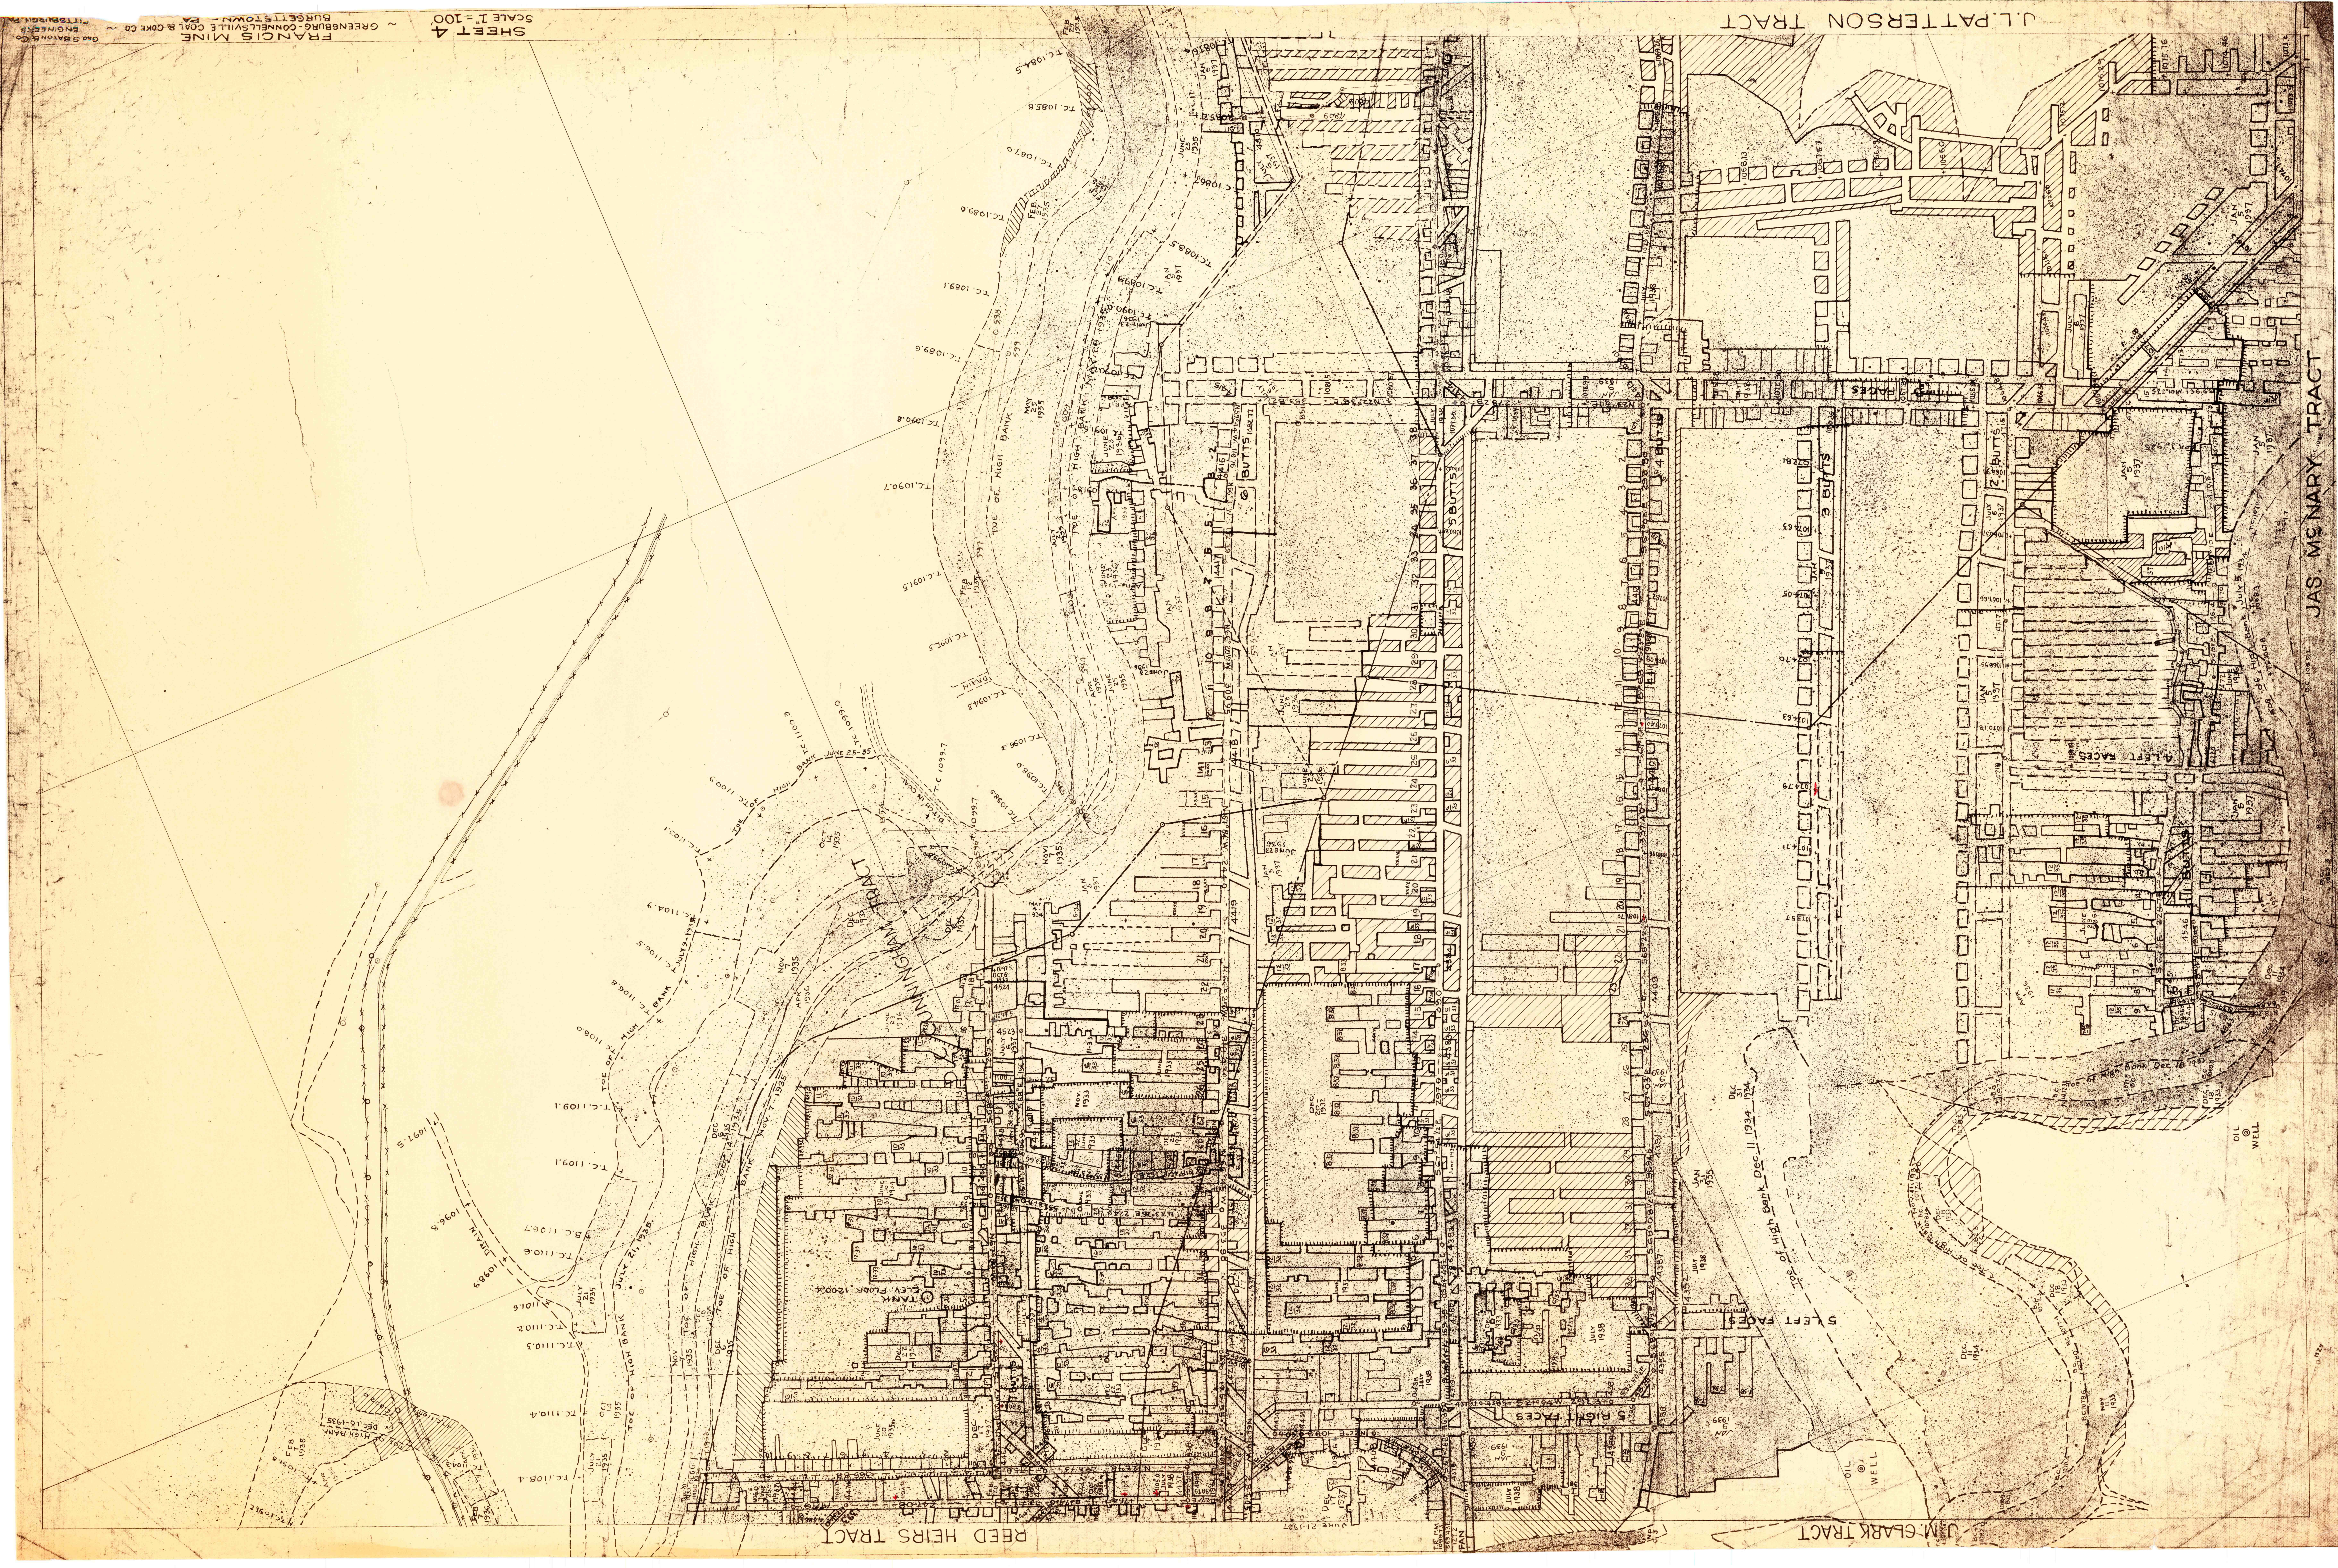

J.L. PATTERSON TRACT

JAS. McNARY TRACT

SHEET 4
SCALE 1" = 100
GREENSBURG, CONNELLVILLE COAL & COKE CO.
BURGETTSTOWN, PA.
FRANCIS MINE
