


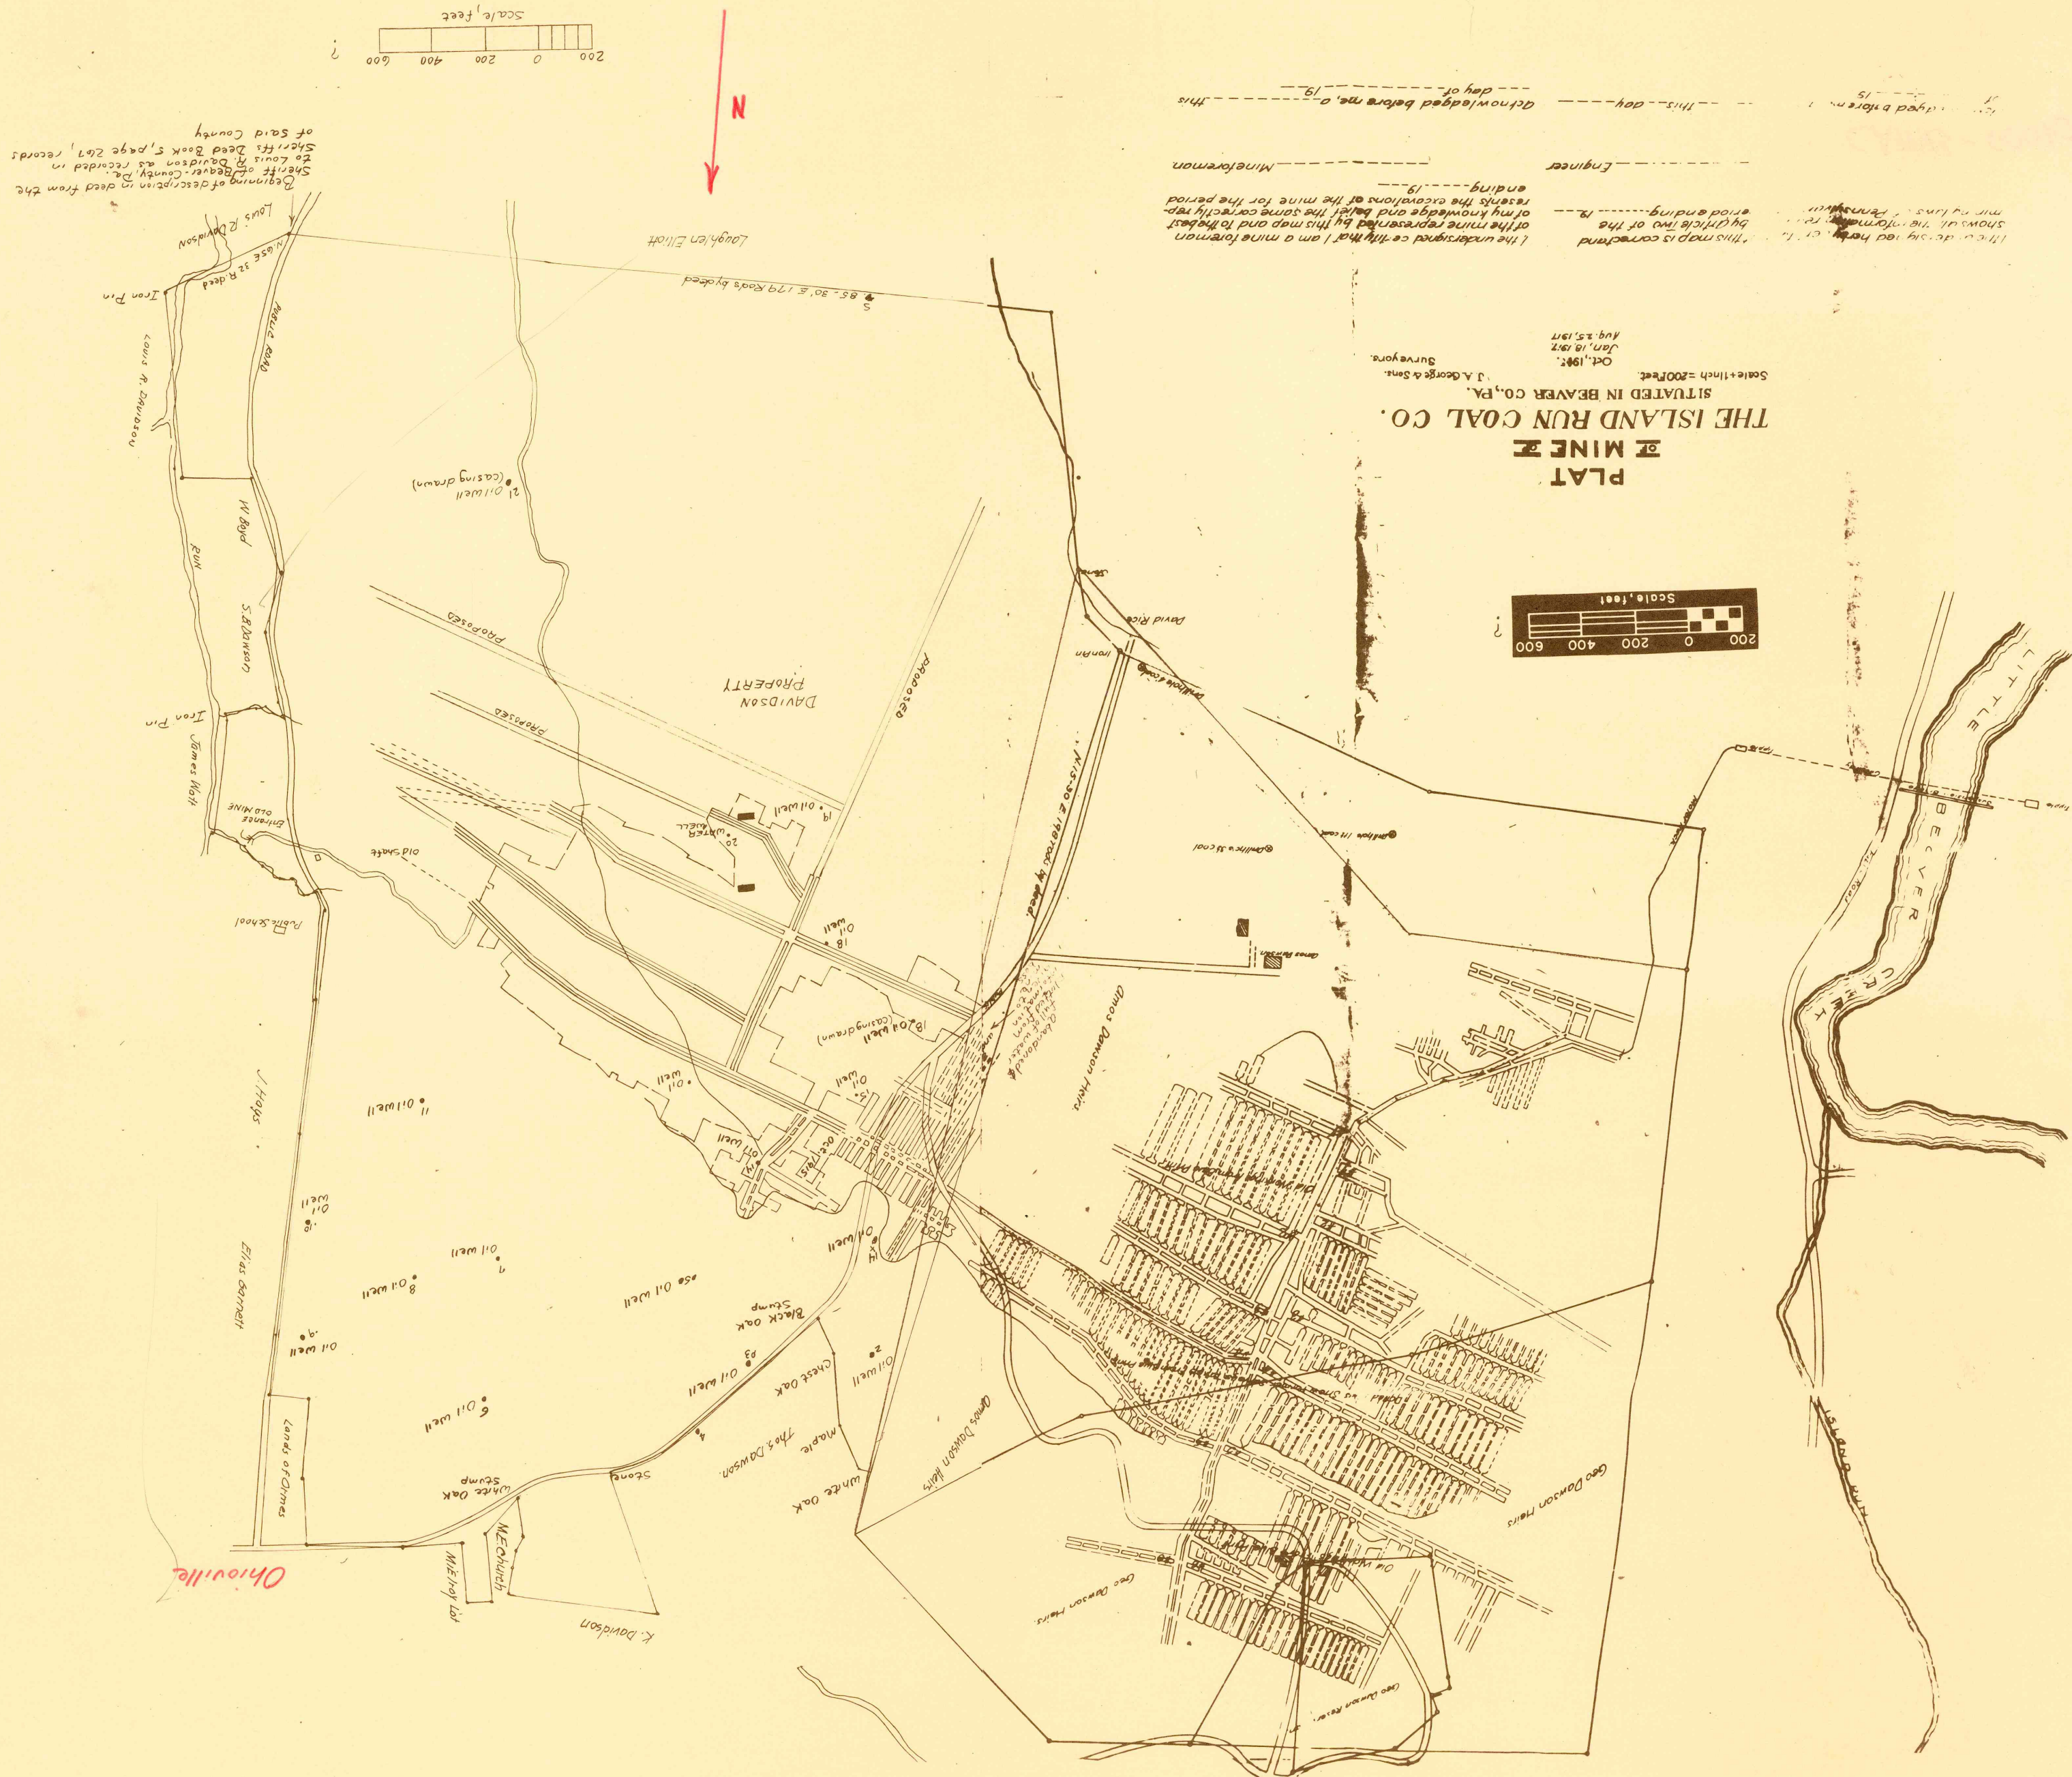

Beginning of description in deed from the
Sheriff of Beaver County, Pa.
to Louis H. Davidson as recorded in
Sheriff's Deed Book 5, page 267, records
of said County