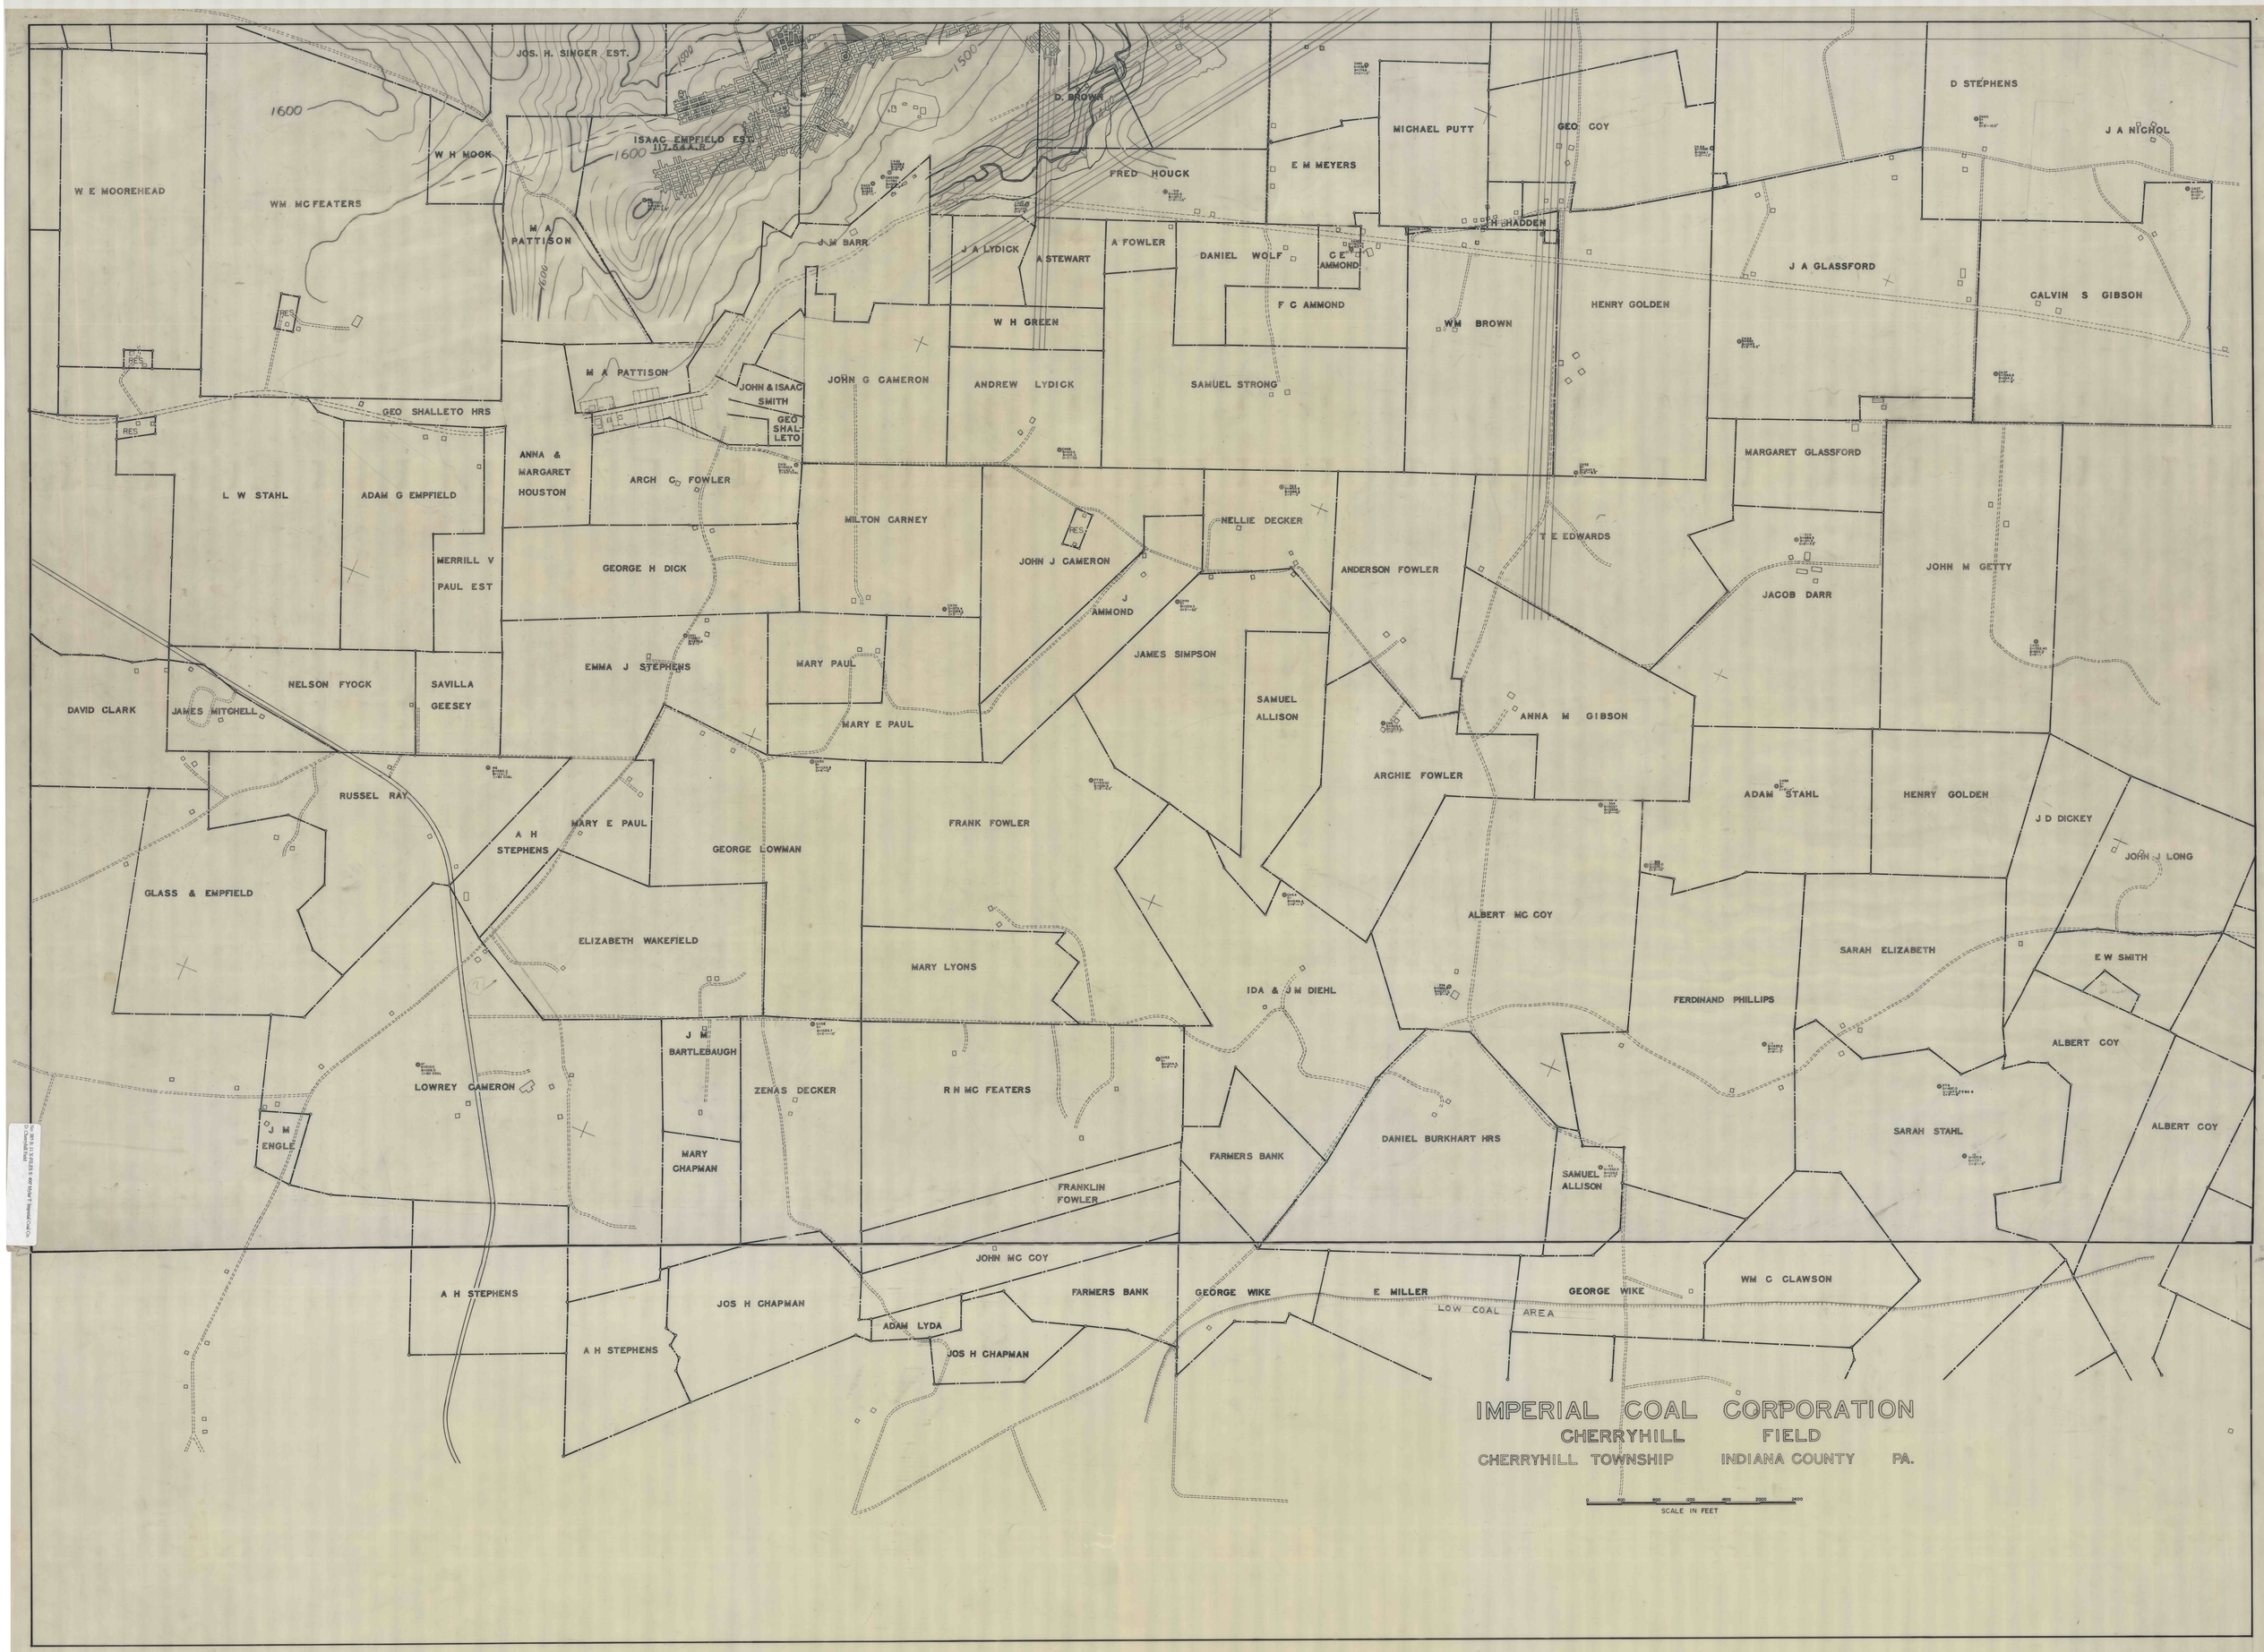
IMPERIAL COAL CORPORATION
CHERRYHILL FIELD
CHERRYHILL TOWNSHIP INDIANA COUNTY PA.
SCALE IN FEET
LOW COAL AREA
JOS. H. SINGER EST.
ISAAC EMPFIELD EST.
117.5 A.A.R
D. BROWN
W E MOOREHEAD
WM MC FEATERS
W H MOOK
M A PATTISON
J M BARR
FRED HOUCK
E M MEYERS
MICHAEL PUTT
GEO. COY
H SHADDEN
D STEPHENS
J A NICHOL
J A LYDICK
A STEWART
A FOWLER
DANIEL WOLF
C E AMMOND
F C AMMOND
W H GREEN
WM BROWN
HENRY GOLDEN
J A GLASSFORD
CALVIN S GIBSON
M A PATTISON
JOHN & ISAAC SMITH
GEO SHALLETO
JOHN G CAMERON
ANDREW LYDICK
SAMUEL STRONG
GEO SHALLETO HRS
ANNA & MARGARET HOUSTON
ARCH C. FOWLER
L W STAHL
ADAM G EMPFIELD
MILTON CARNEY
NELLIE DECKER
T E EDWARDS
MARGARET GLASSFORD
JOHN M GETTY
MERRILL V PAUL EST
GEORGE H DICK
JOHN J CAMERON
J AMMOND
ANDERSON FOWLER
JACOB DARR
EMMA J STEPHENS
MARY PAUL
JAMES SIMPSON
DAVID CLARK
NELSON FYOCK
SAVILLA GEESEY
JAMES MITCHELL
MARY E PAUL
SAMUEL ALLISON
ANNA M GIBSON
RUSSEL RAY
ARCHIE FOWLER
ADAM STAHL
HENRY GOLDEN
J D DICKEY
A H STEPHENS
MARY E PAUL
GEORGE LOWMAN
FRANK FOWLER
JOHN J LONG
GLASS & EMPFIELD
ALBERT MC COY
ELIZABETH WAKEFIELD
SARAH ELIZABETH
E W SMITH
MARY LYONS
IDA & J M DIEHL
FERDINAND PHILLIPS
J M BARTLEBAUGH
ALBERT COY
LOWREY CAMERON
ZENAS DECKER
R N MC FEATERS
SARAH STAHL
J M ENGLE
MARY CHAPMAN
FARMERS BANK
DANIEL BURKHART HRS
ALBERT COY
FRANKLIN FOWLER
SAMUEL ALLISON
JOHN MC COY
A H STEPHENS
JOS H CHAPMAN
FARMERS BANK
GEORGE WIKE
E MILLER
GEORGE WIKE
WM C CLAWSON
ADAM LYDA
A H STEPHENS
JOS H CHAPMAN