


500ft scale

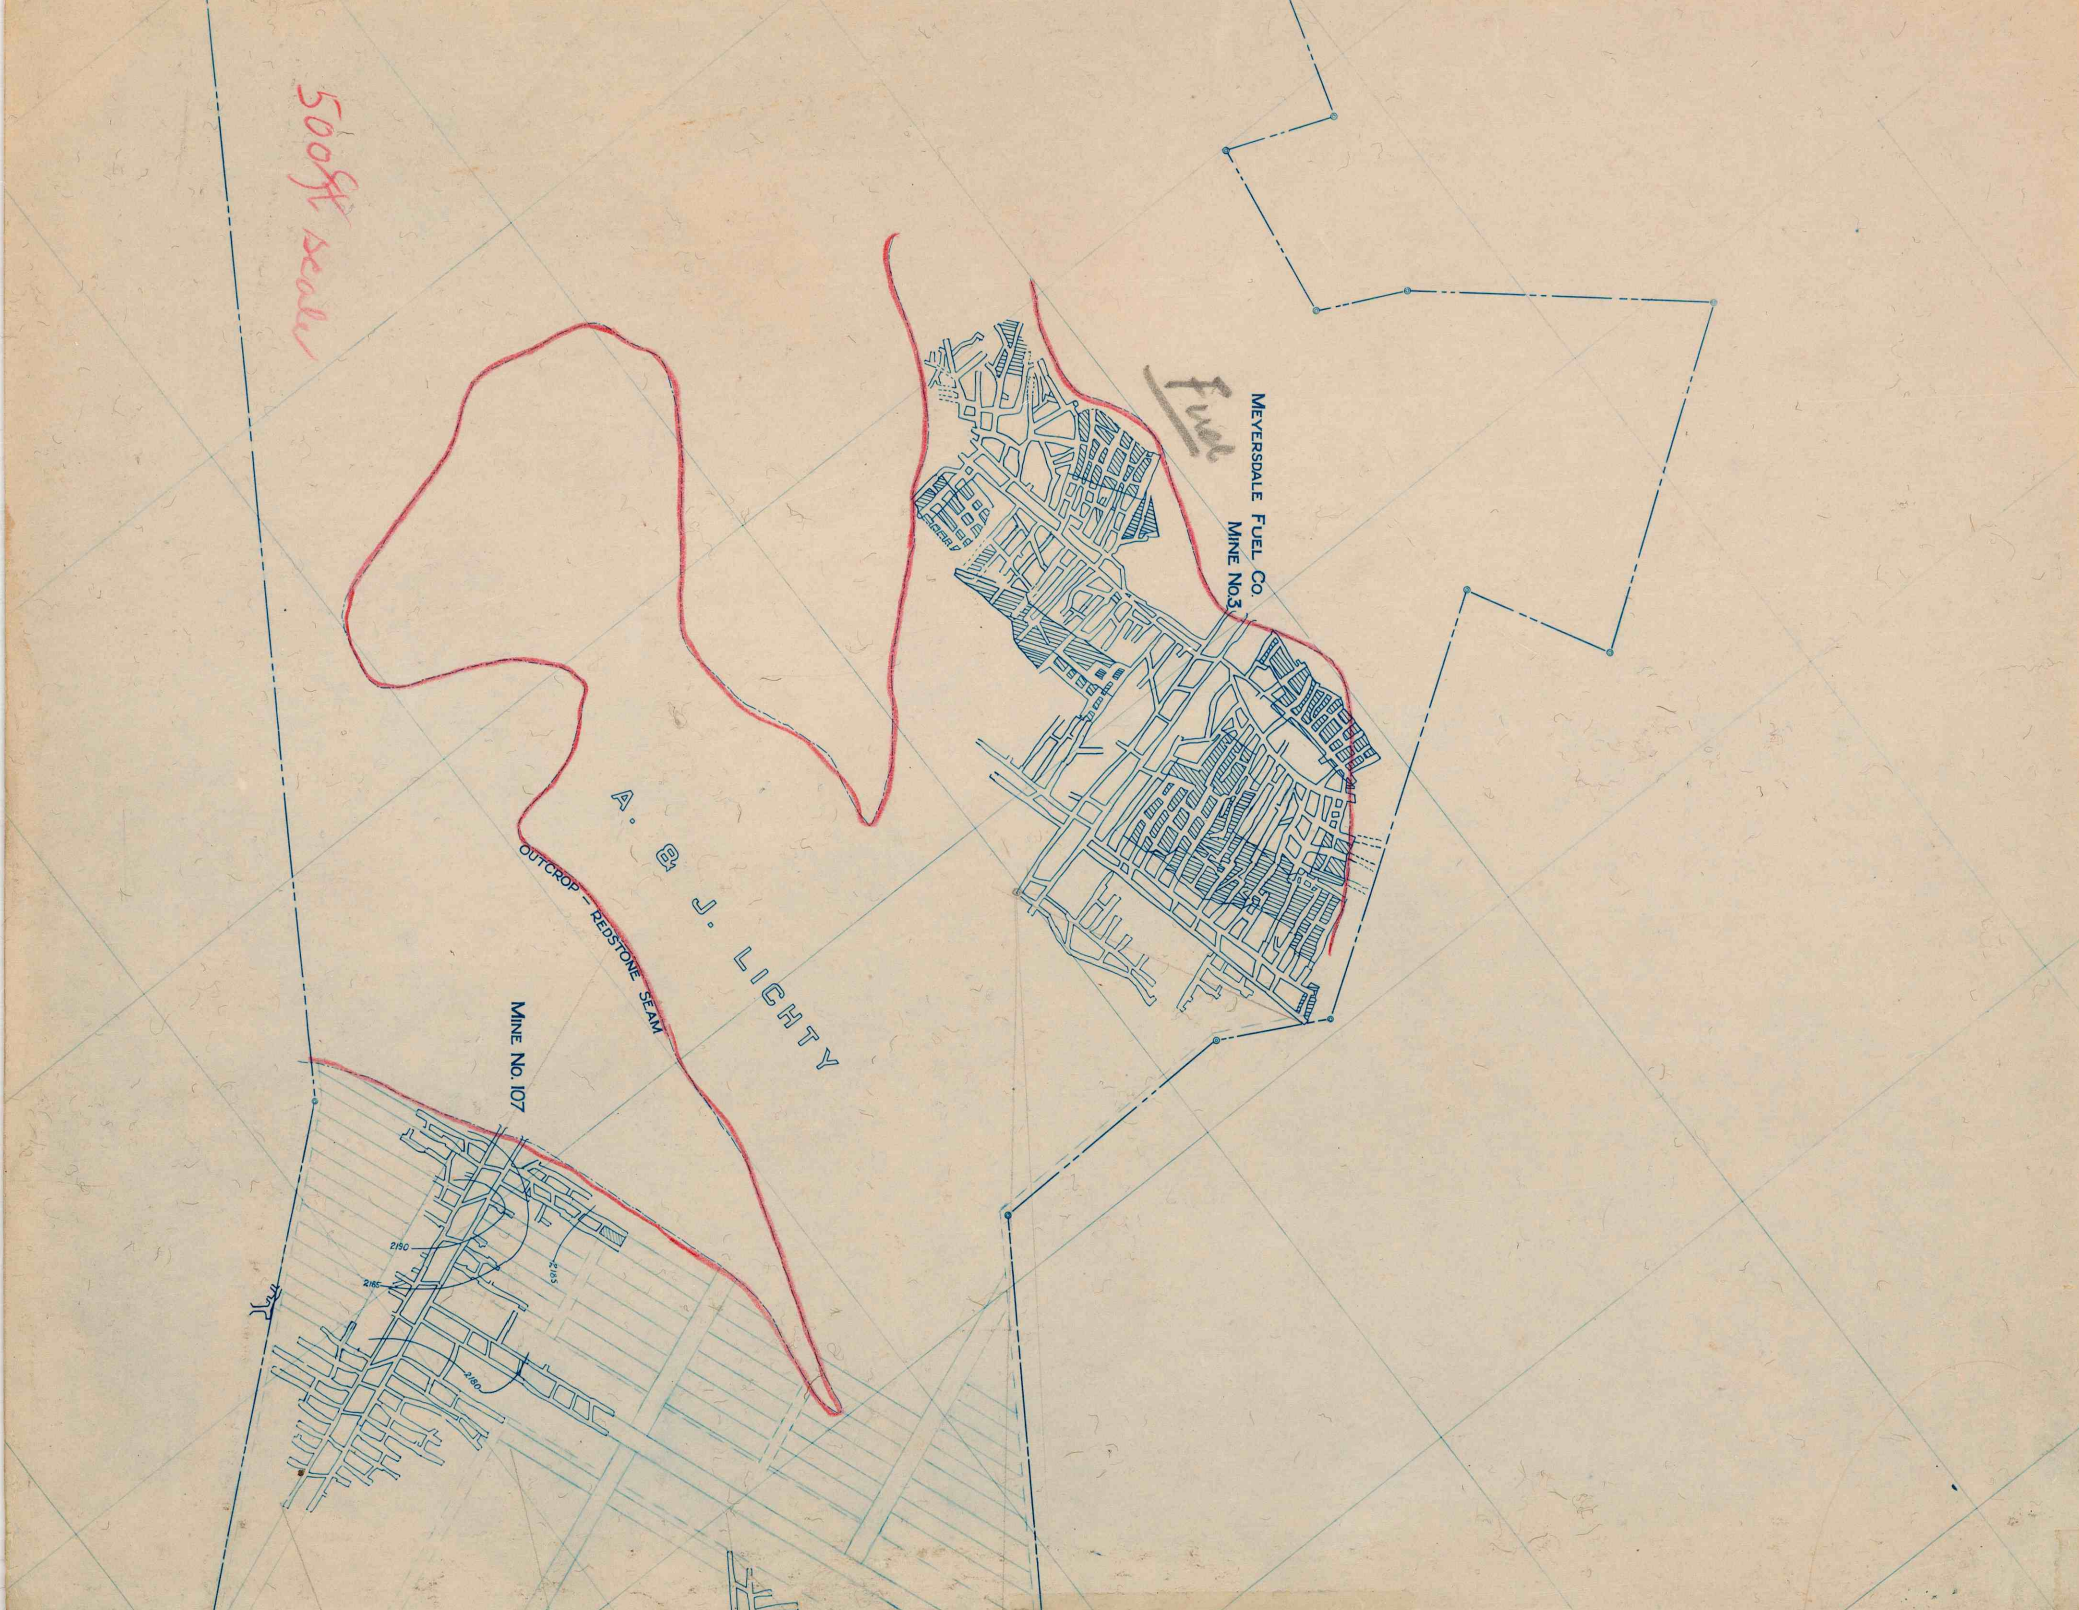

ELK LICK NO. 4
SOMERSET COAL CO.
SCALE OF FEET
100 200 300 400 500 600 700 800 900 1000



SUMMIT NO. 2 MINE
SOMERSET COAL CO. CONSOL. #102
SCALE OF FEET
100 200 300 400 500 600 700 800 900 1000

