


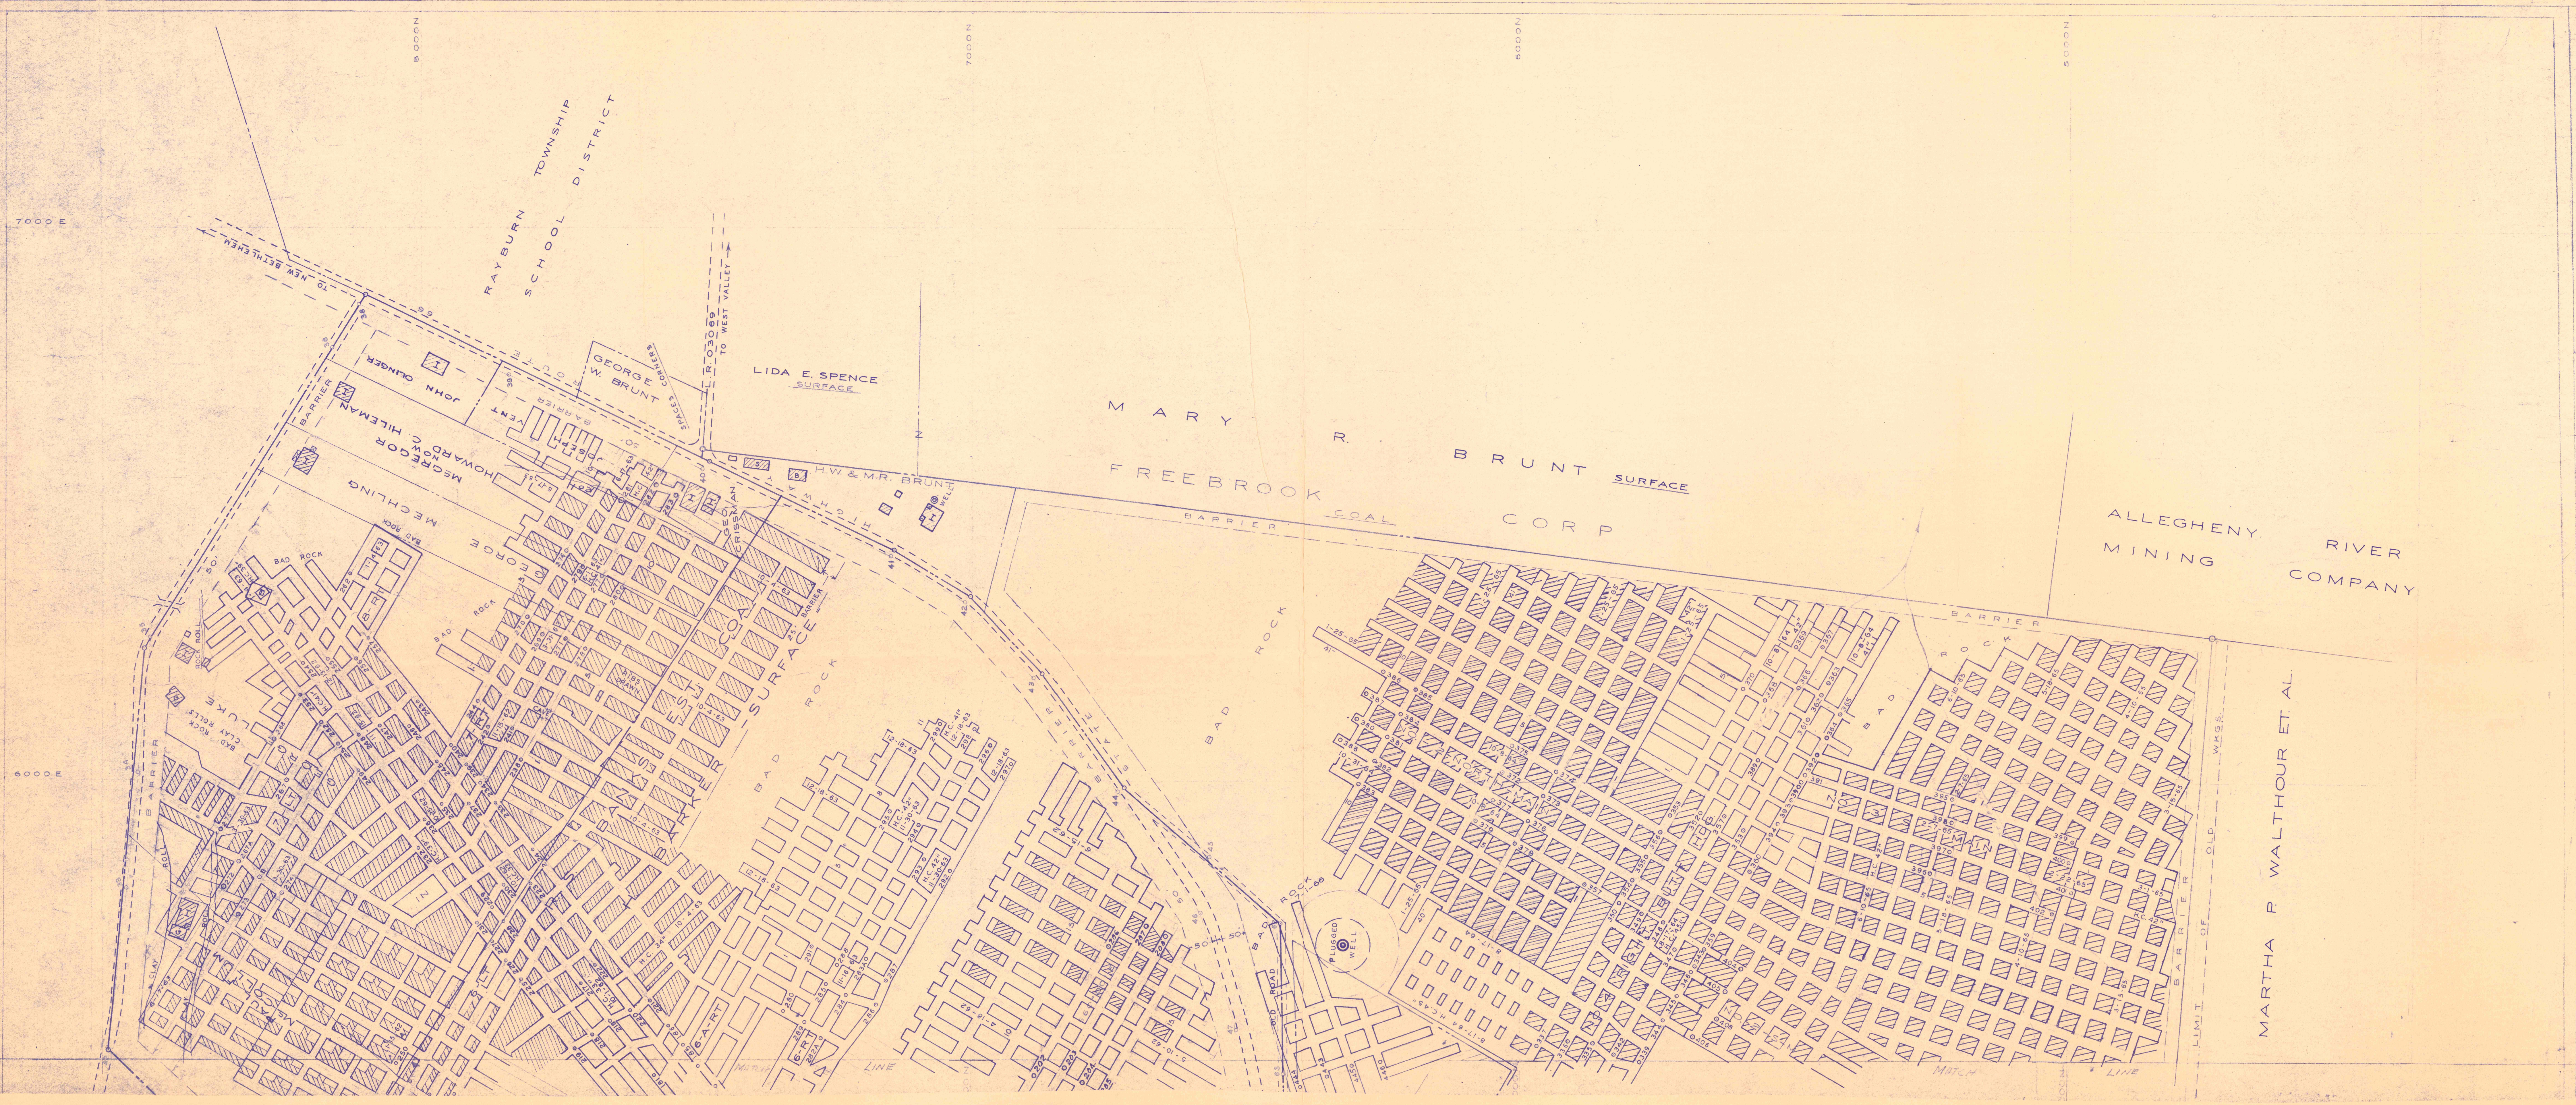

7000 E

8000 N

7000 N

6000 N

5000 N

6000 E

RAYBURN
TOWNSHIP
SCHOOL
DISTRICT

TO WEST VALLEY

TO NEW BETHLEHEM

JOHN OHLINGER

GEORGE
W. BRUNT

LIDA E. SPENCE
SURFACE

MARY
R.

BRUNT SURFACE

FREEBROOK
CORP

ALLEGHENY
MINING
RIVER
COMPANY

MECHLING

HOWARD C. HILMAN

BARRIER

ROCK

BAD ROCK

COAL

SURFACE

ROCK

BAD

ROCK

BAD

ROCK

BAD

ROCK

BAD

ROCK

BAD

ROCK

BAD

ROCK

BAD

ROCK

BAD

ROCK

BAD

ROCK

BAD

ROCK

BAD

PLUGGED
WELL

MATCH

LIMIT OF OLD WORKS

MARTHA P. WALTHOUR ET AL