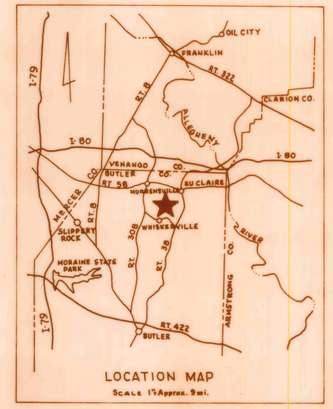

NO.	DATE	REVISION	APPR.
	9-8-83	As Drilled	

SUBMITTED: John W. Foreman

APPROVED: Andrew E. Friedrich, CHIEF - DIVISION OF ABANDONED MINE RECLAMATION

APPROVED: John E. McKernan P.E., DIRECTOR - BUREAU OF RESOURCES PROGRAMMING

COMMONWEALTH OF PENNSYLVANIA
DEPARTMENT OF ENVIRONMENTAL RESOURCES
OFFICE OF RESOURCES MANAGEMENT

SUBSURFACE EXPLORATION
HAMILTON NO. 3 MINE
WASHINGTON TOWNSHIP
BUTLER COUNTY

PROJECT NO. 110-7-101.5

GENERAL LOCATION MAP

GWIN, DOBSON & FOREMAN, INC.
CONSULTING ENGINEERS
ALTOONA PENNSYLVANIA

DRAWN BY	DATE	DRAWING NO.
L.B.B.	JULY 1, 1980	2
CHECKED BY	SCALE	
M.V.G.	AS SHOWN	

CMMB-00012