
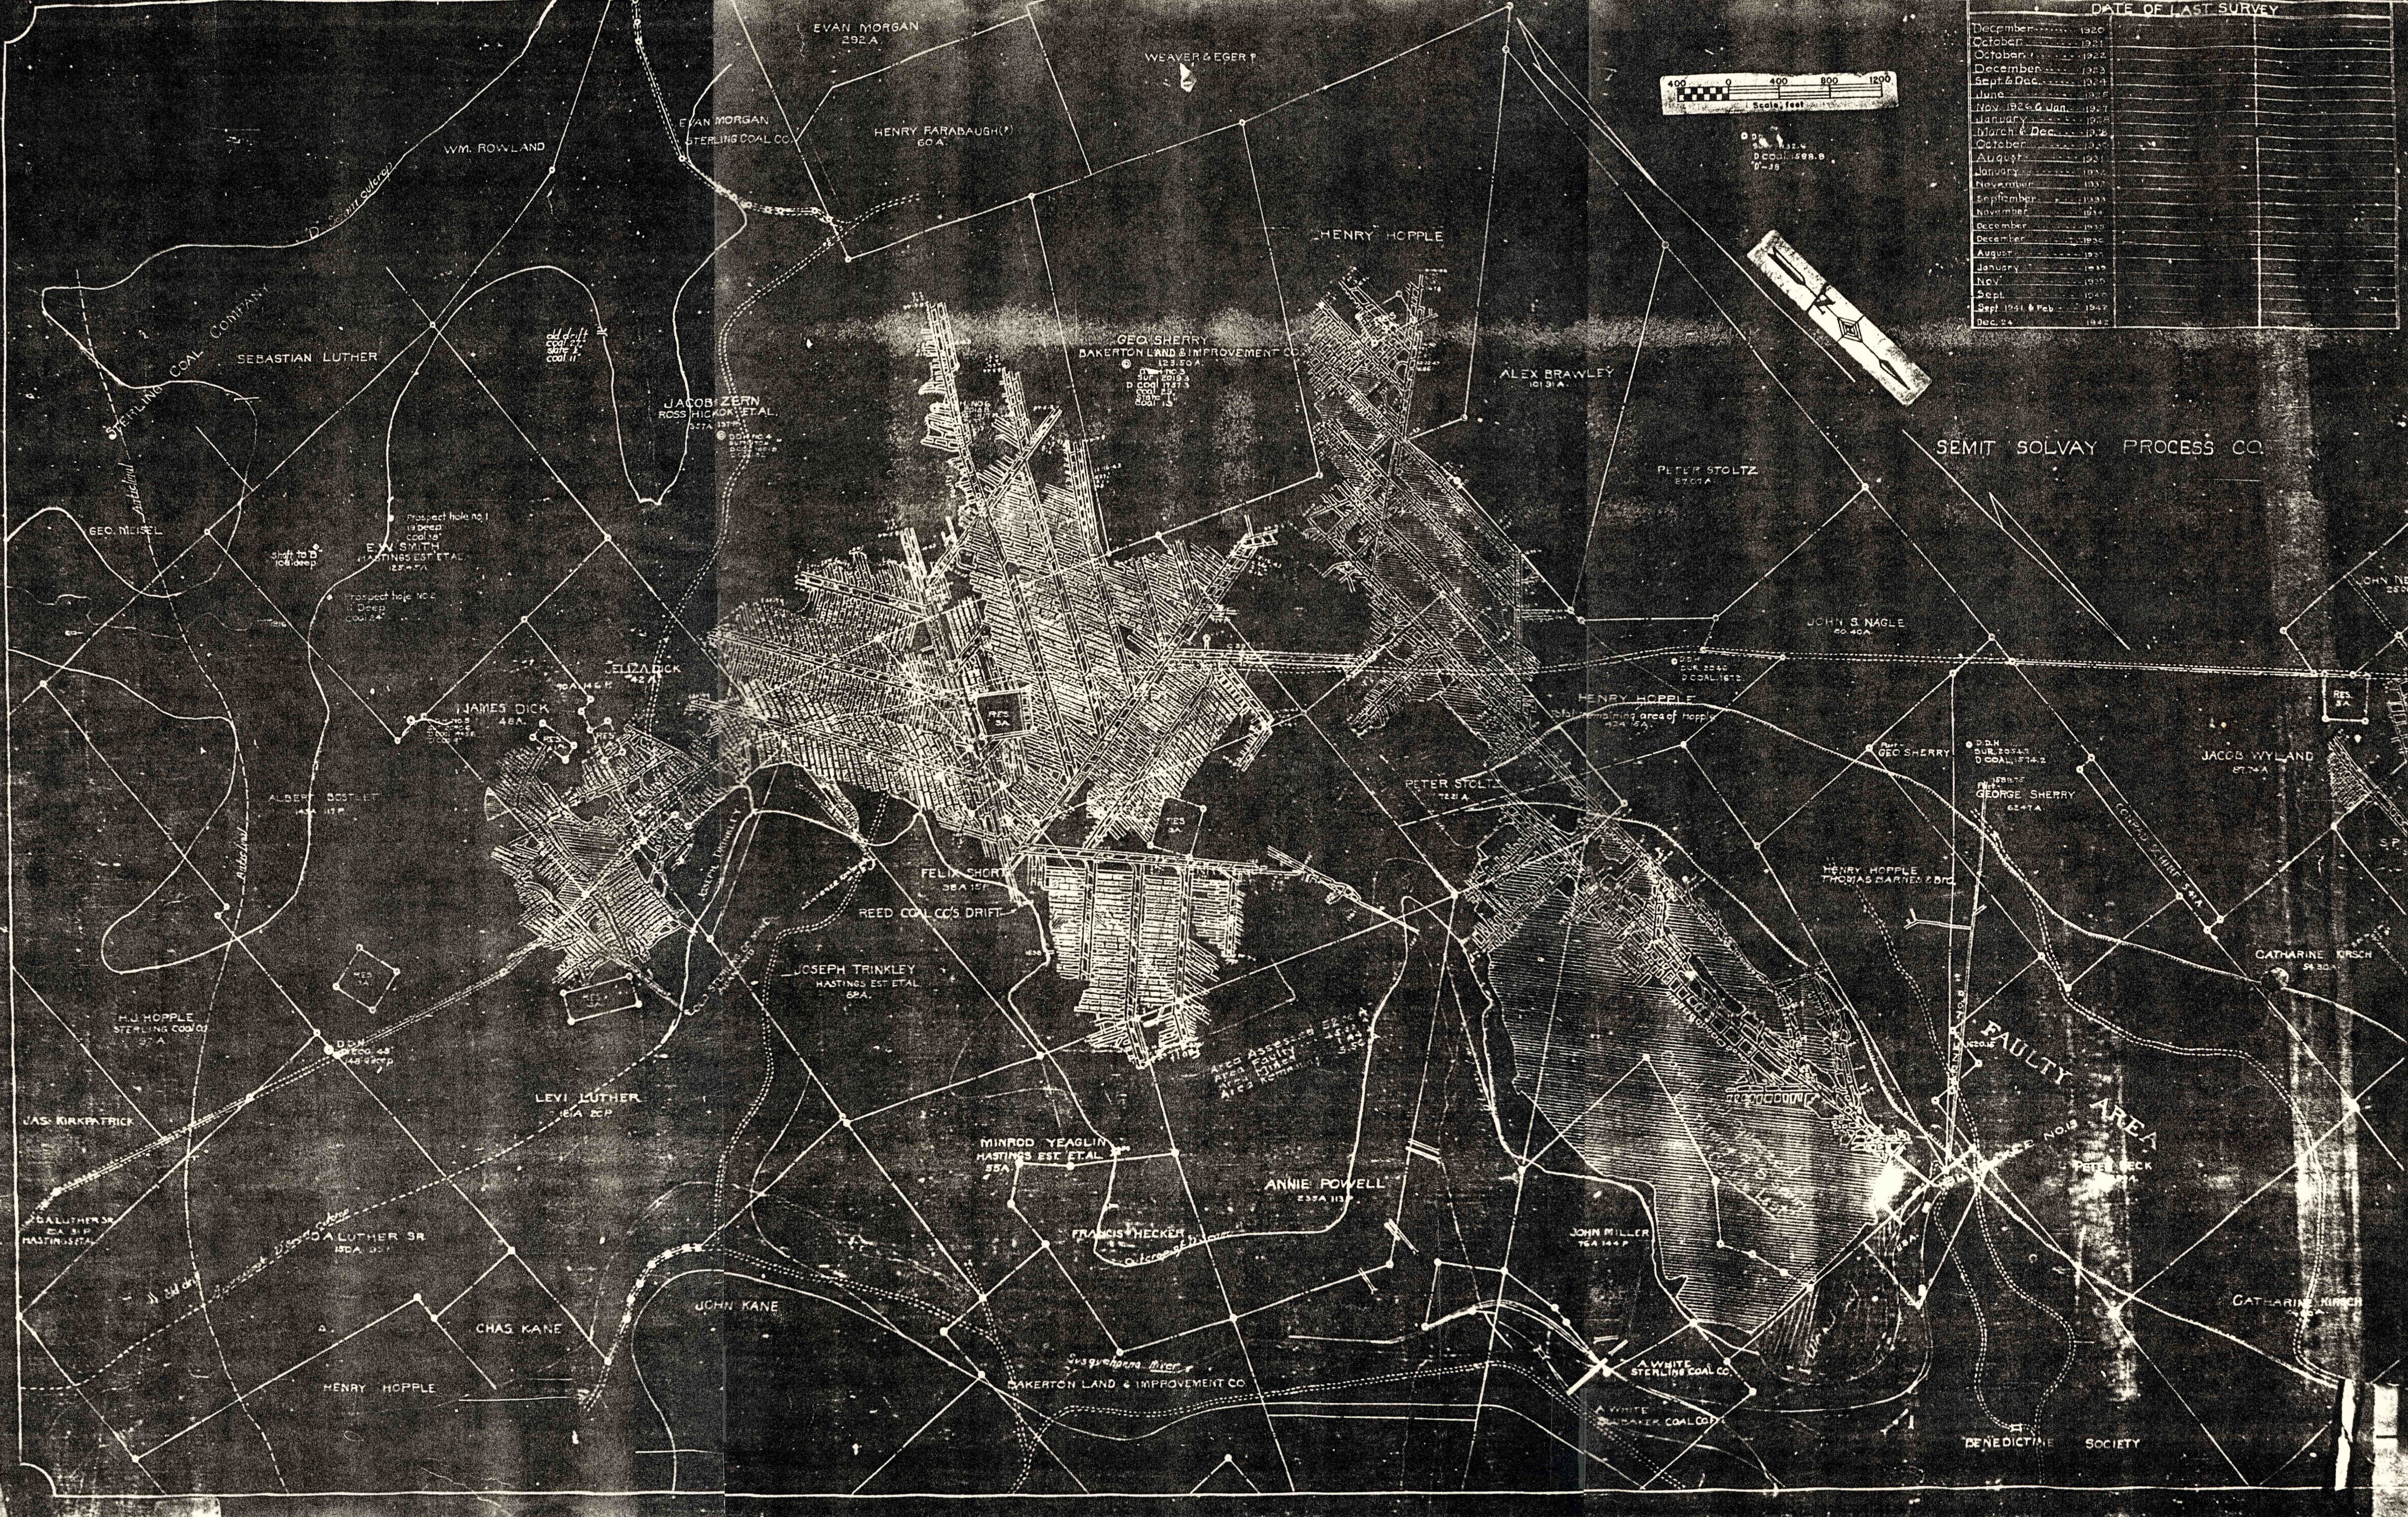


DATE OF LAST SURVEY	
December	1920
October	1921
October	1922
December	1923
Sept & Dec	1924
June	1925
Nov 1925 & Jan	1927
January	1928
March & Dec	1929
October	1930
August	1931
January	1932
November	1933
September	1934
November	1935
December	1936
December	1937
August	1938
January	1939
Nov	1940
Sept	1941
Sept 1941 & Feb	1942
Dec 24	1942

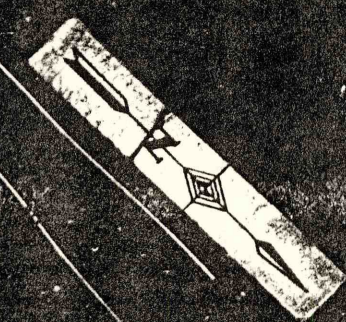

FAULTY AREA

BENEDICTINE SOCIETY