


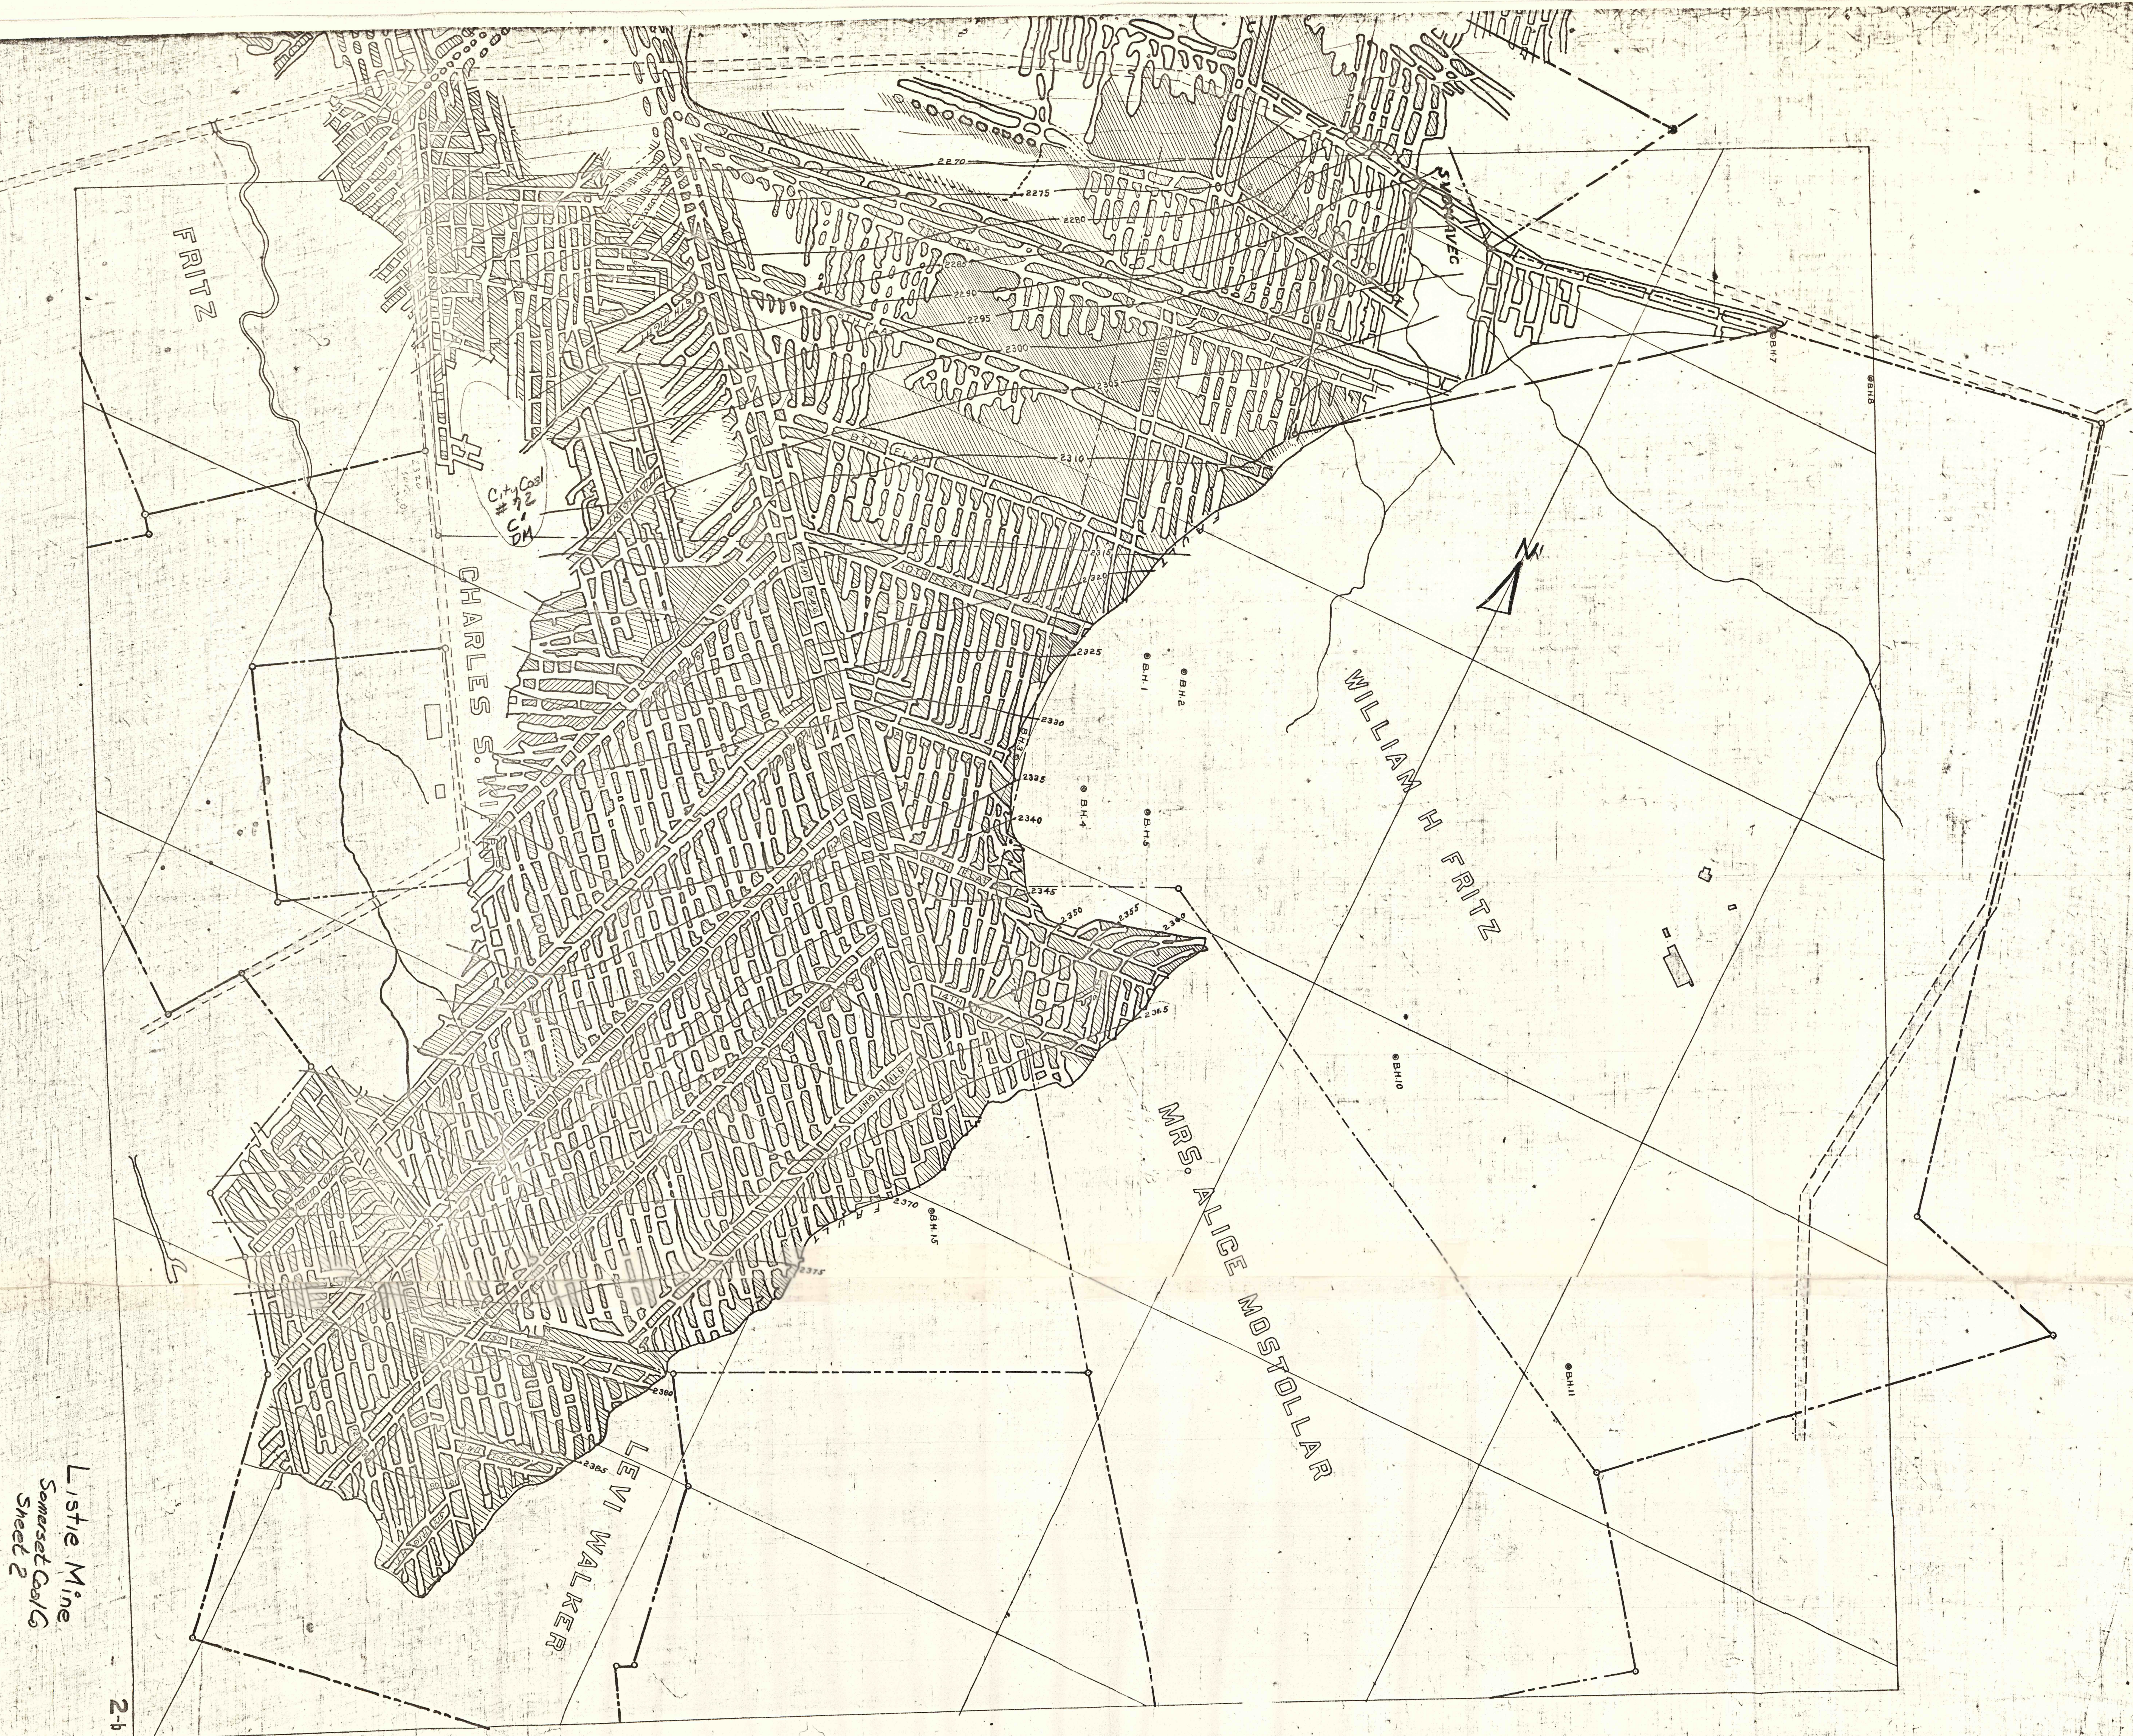

Listie Mine
Somerset Coal Co
Sheet 2

2-b