


1:100000
1:50000

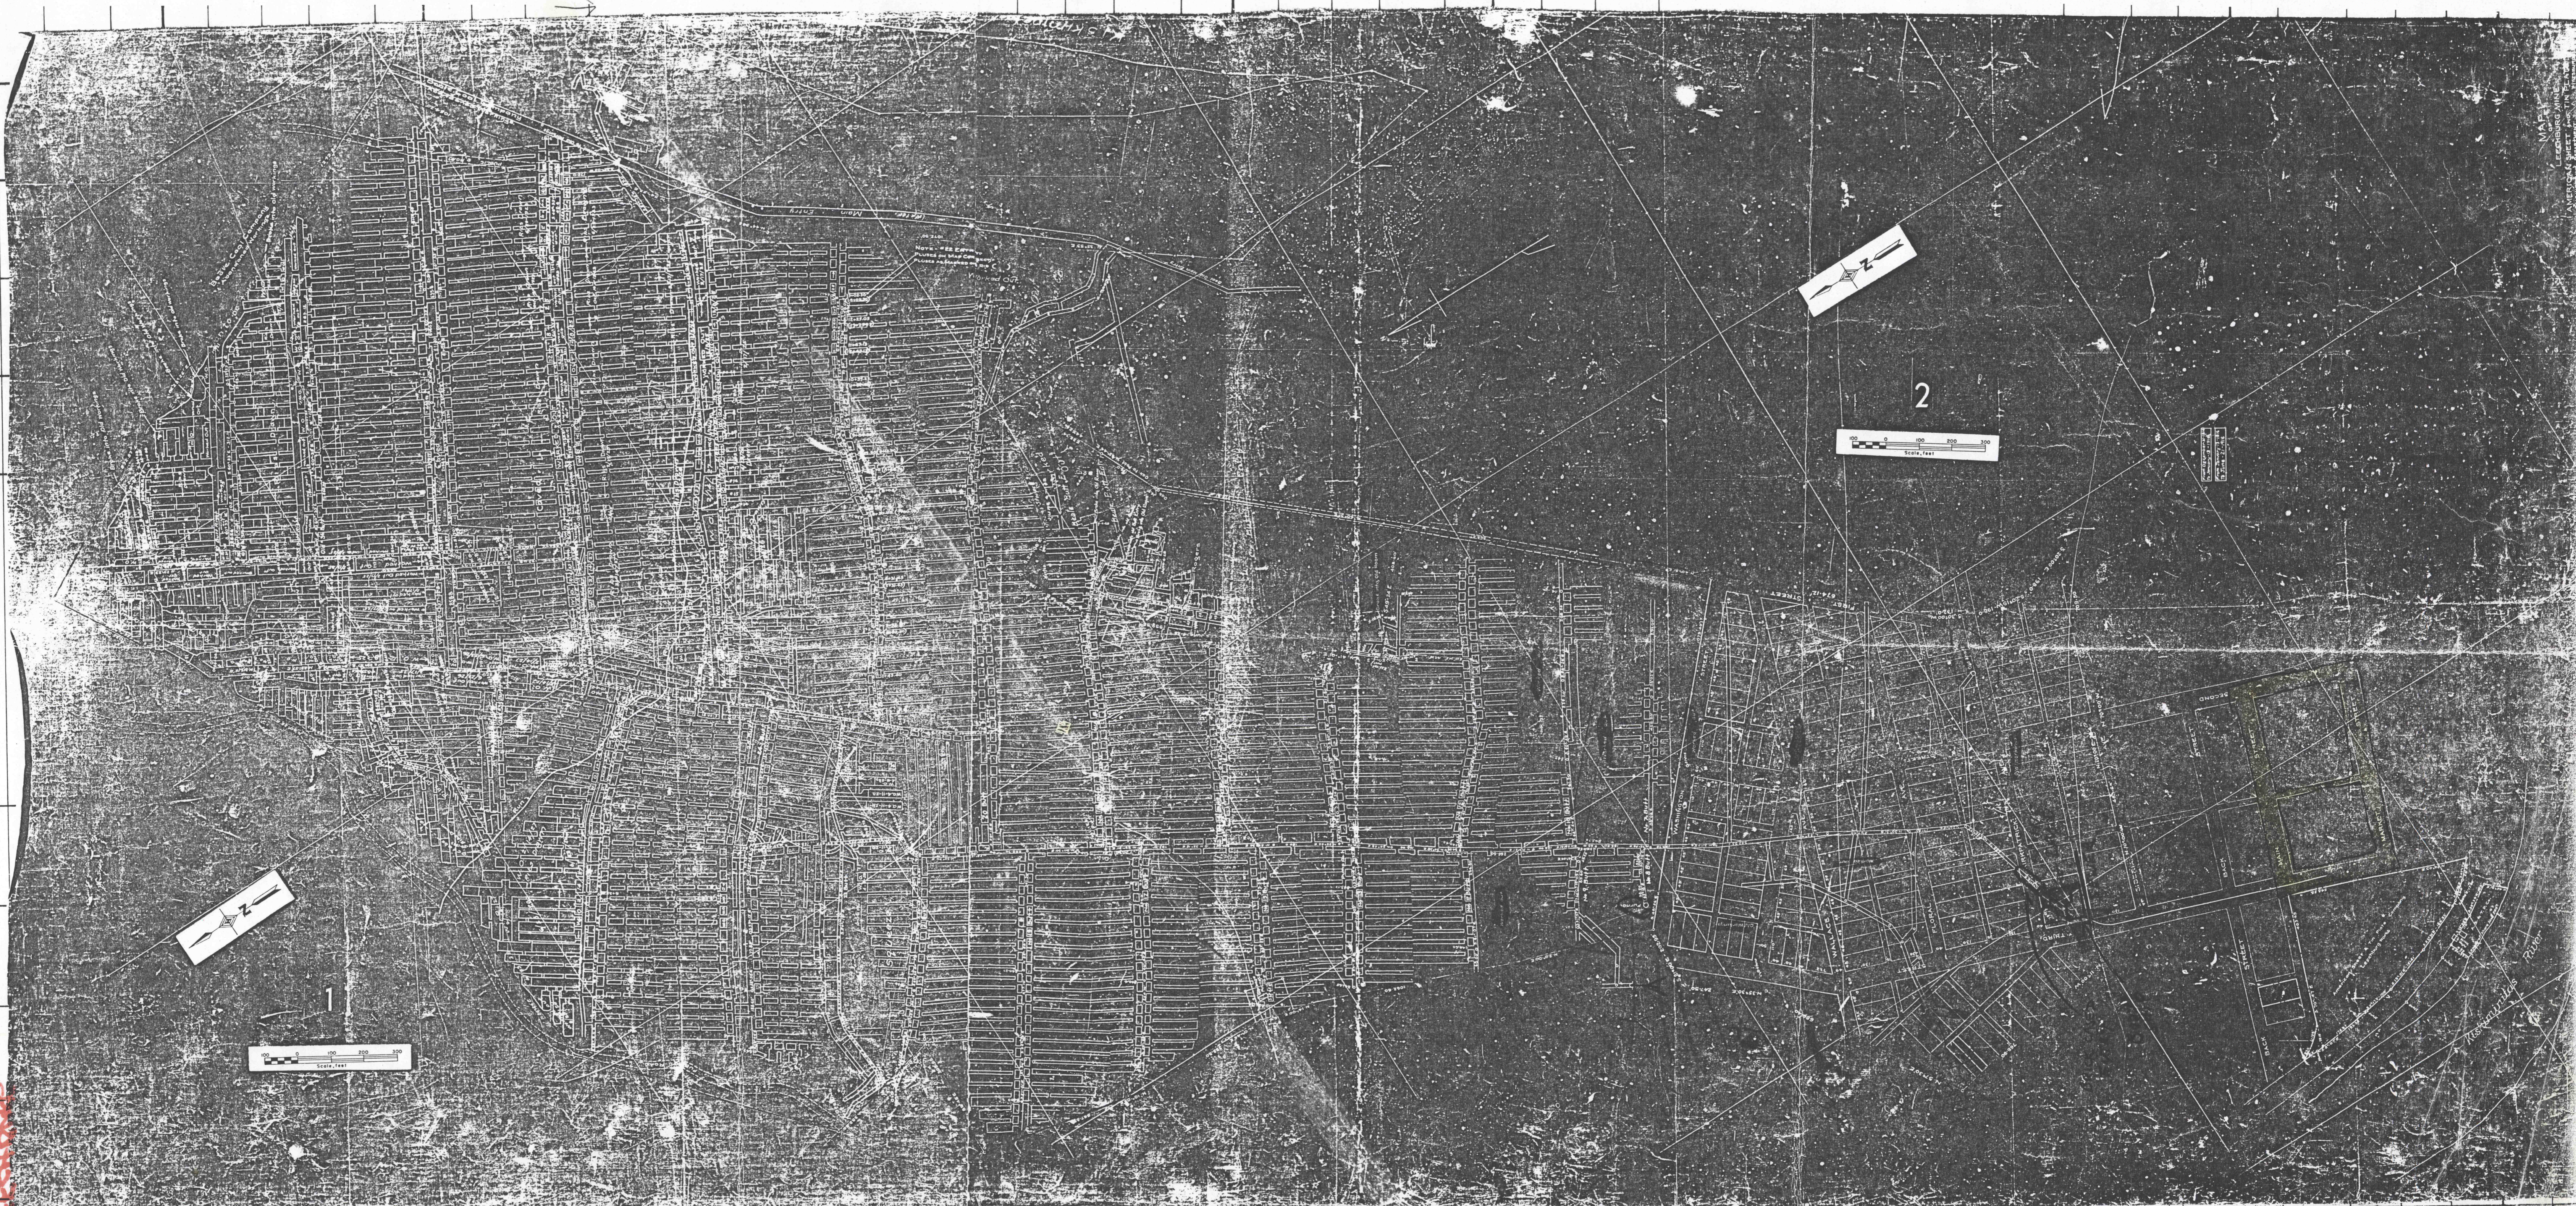

PDVMS 03044 80 32X 316

PDVMS 03044 81 32X 316094