
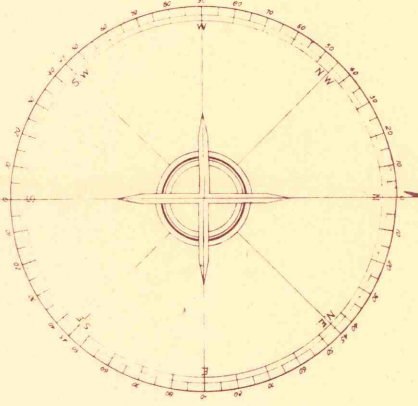


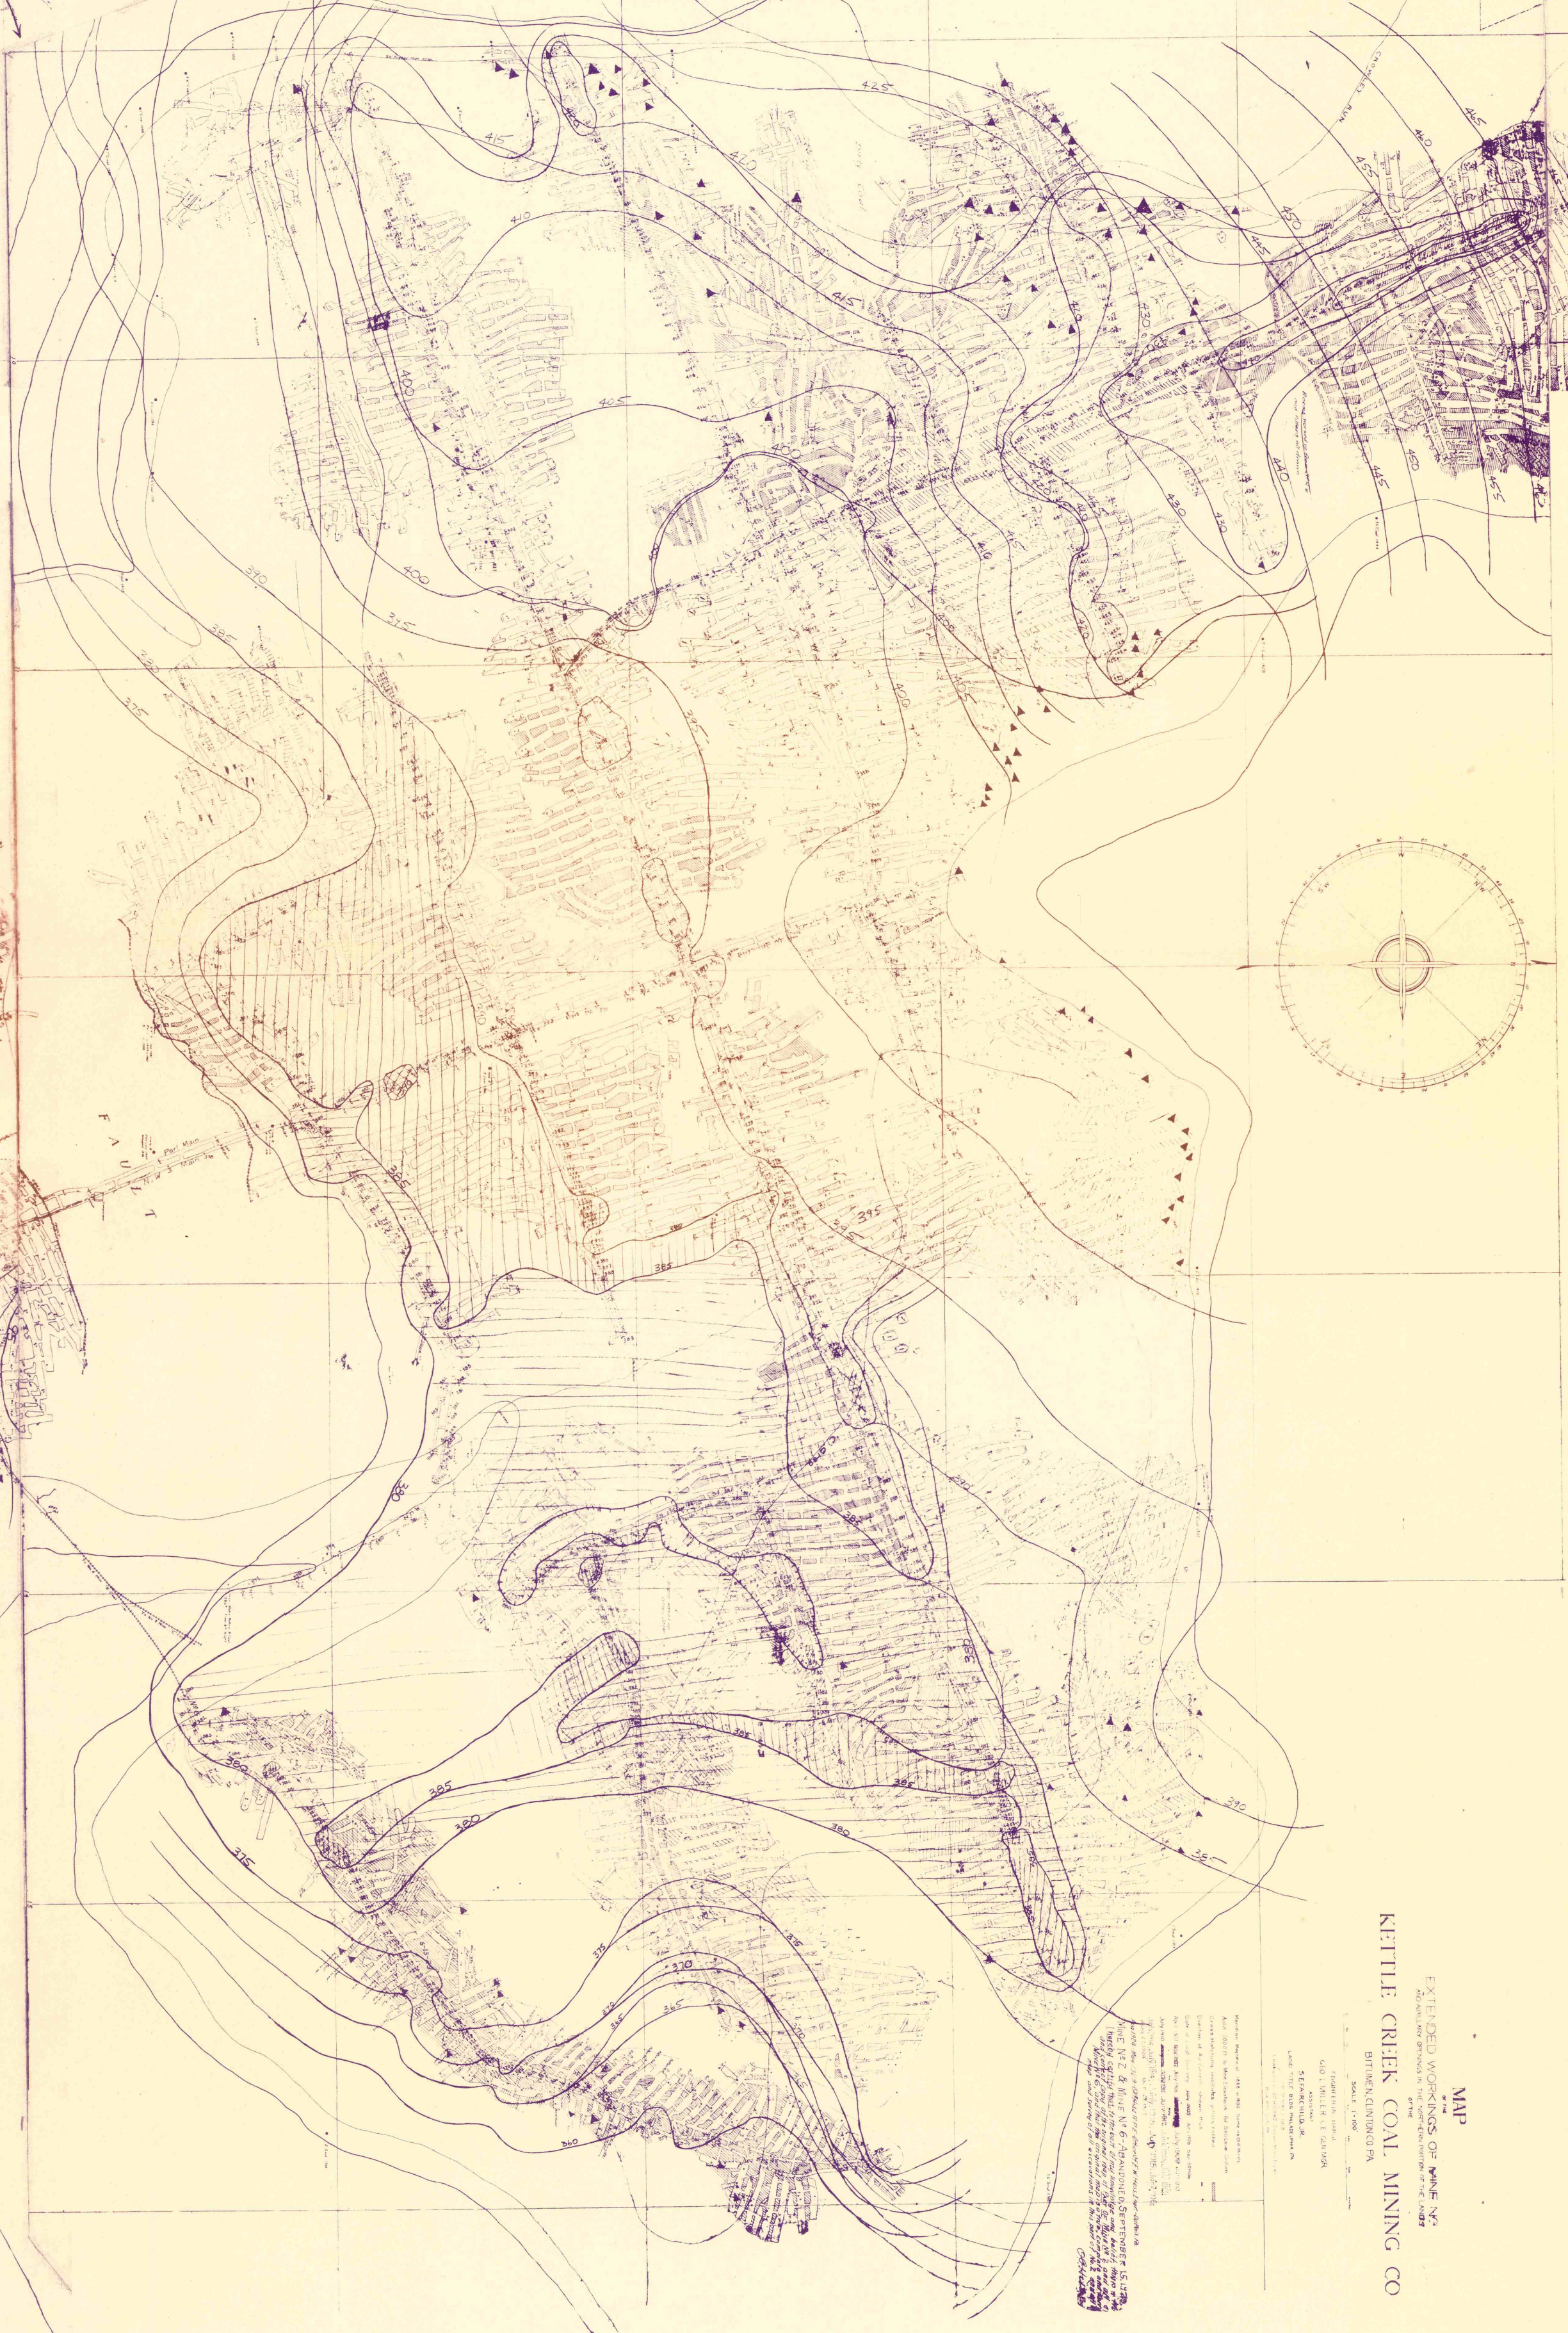

MAP
OF THE

