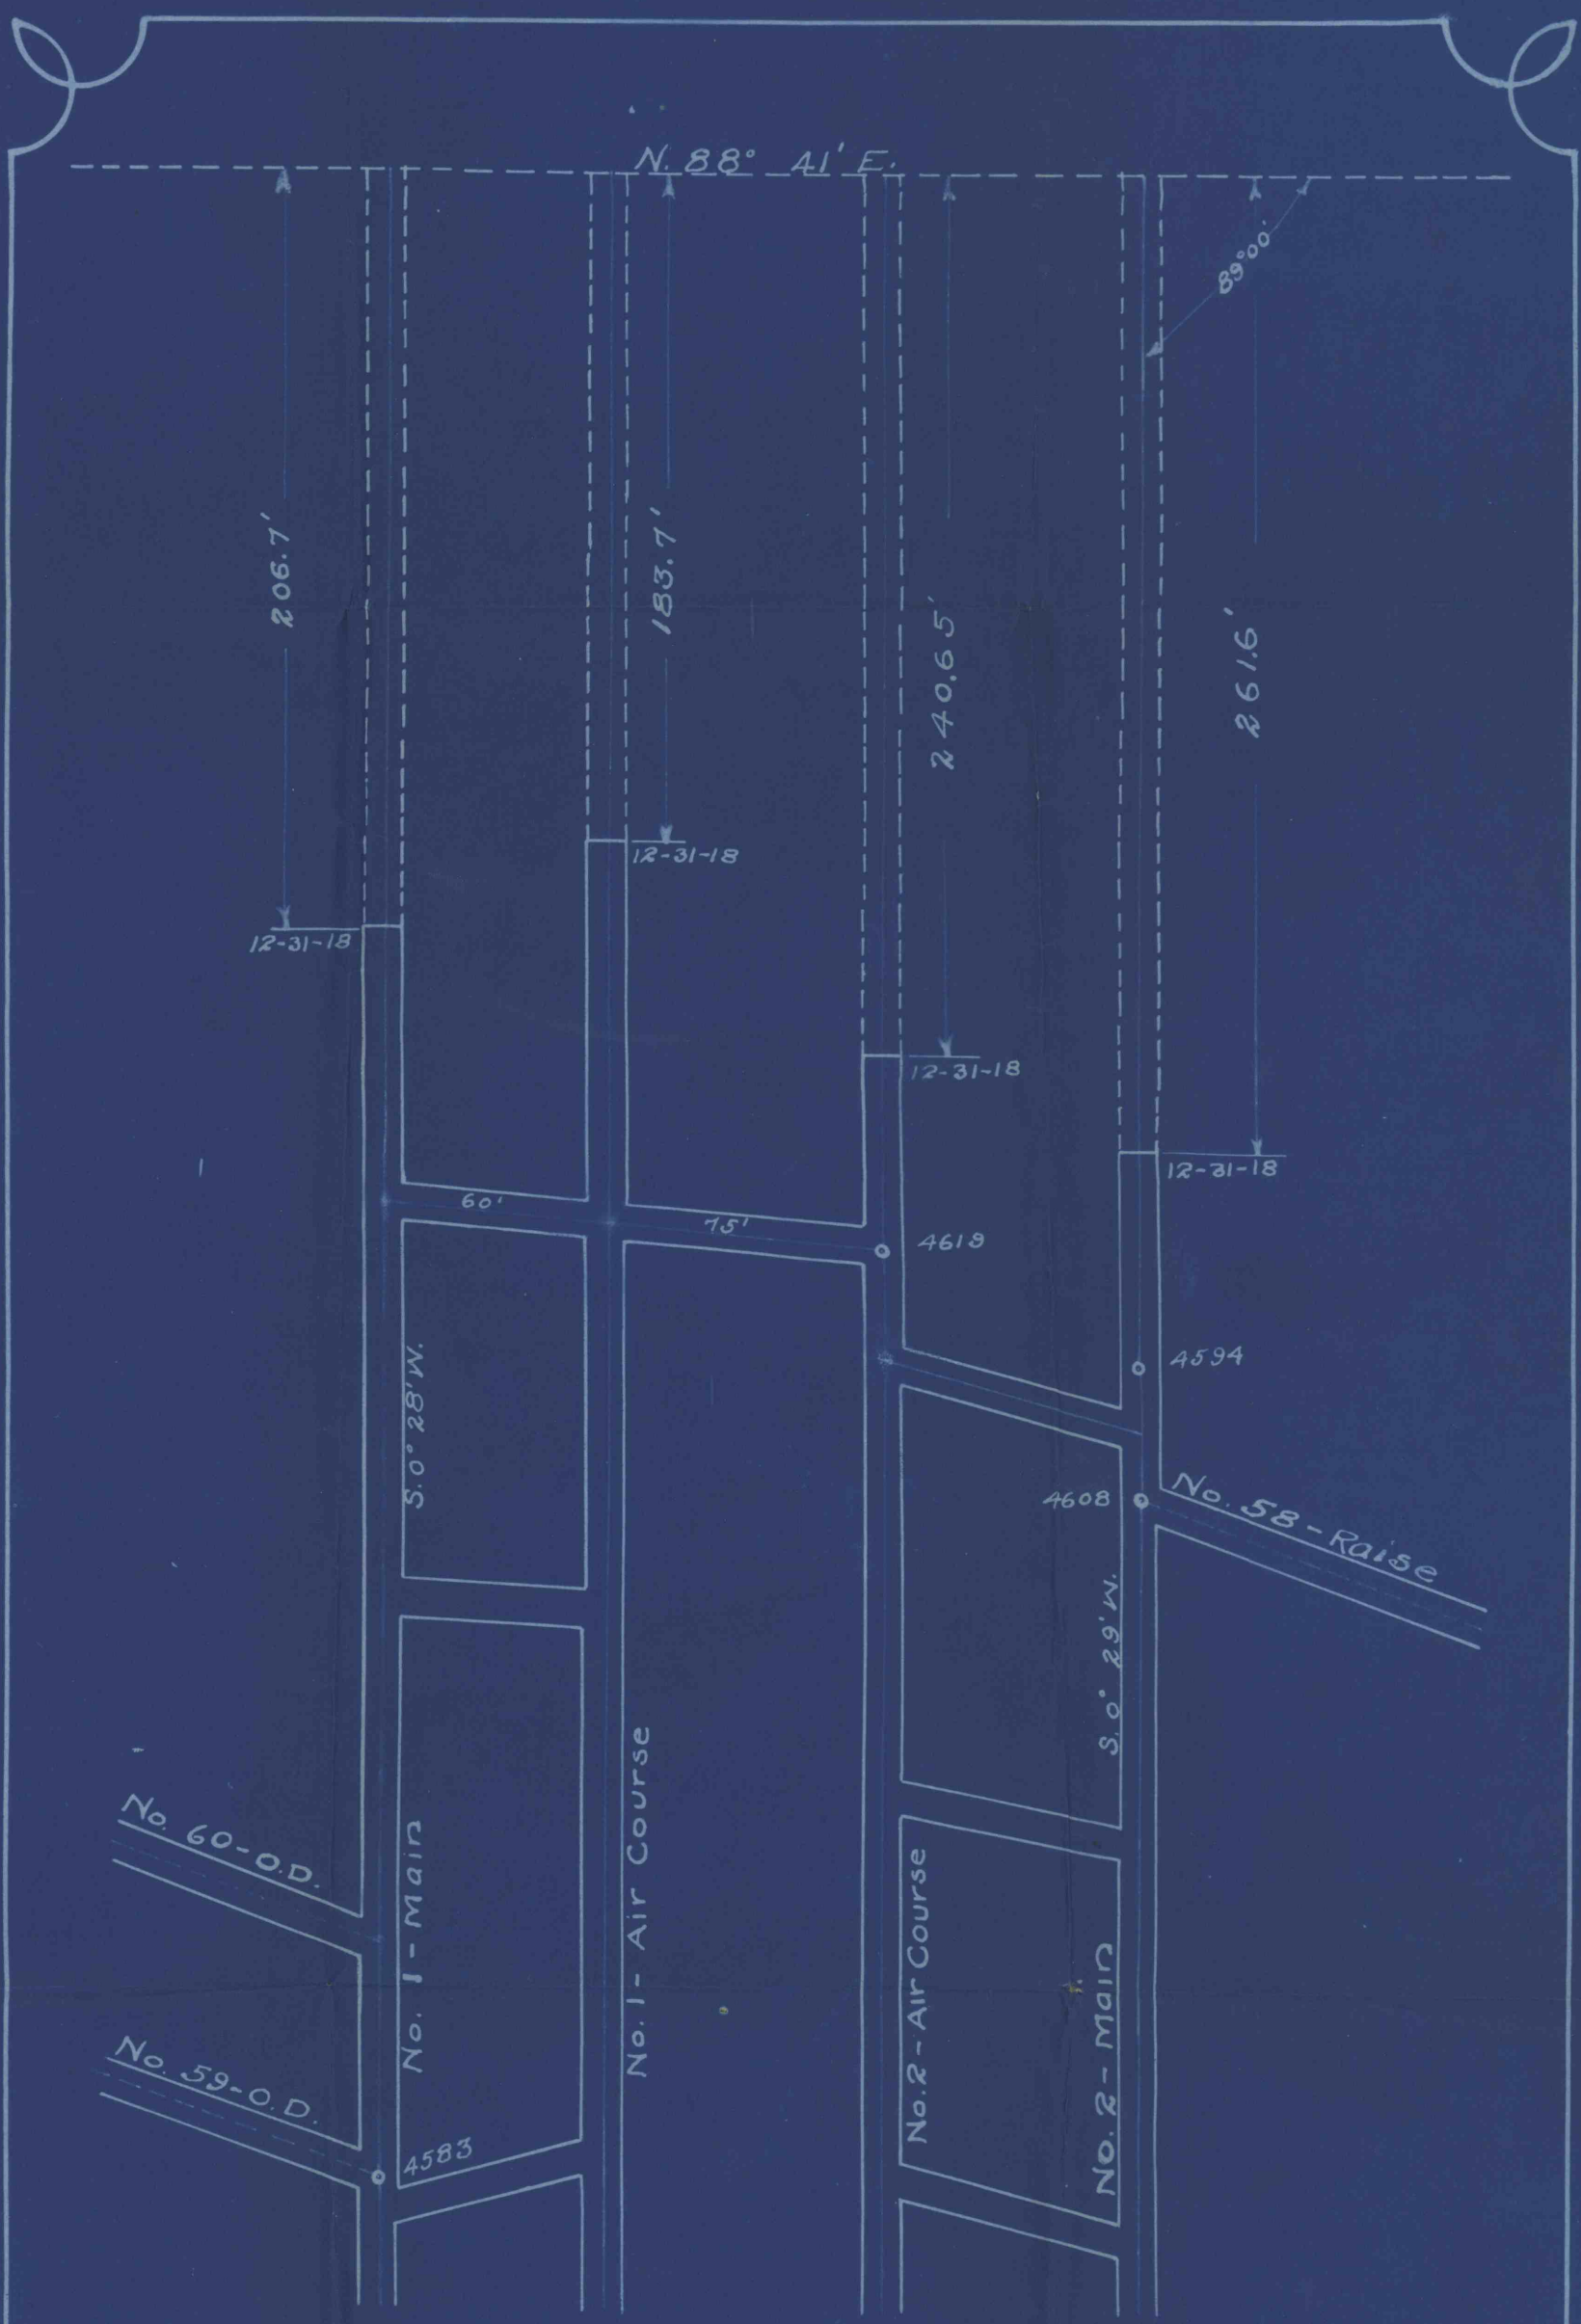

PLAN OF MAIN ENTRIES
HAZEL MINE
CHARTIERS CREEK COAL CO.
CANONSBURG PA.

Scale - 1" = 50'

Feb. 25, 1919.

H. M. Day Engineer.
Canonsburg, Pa.