


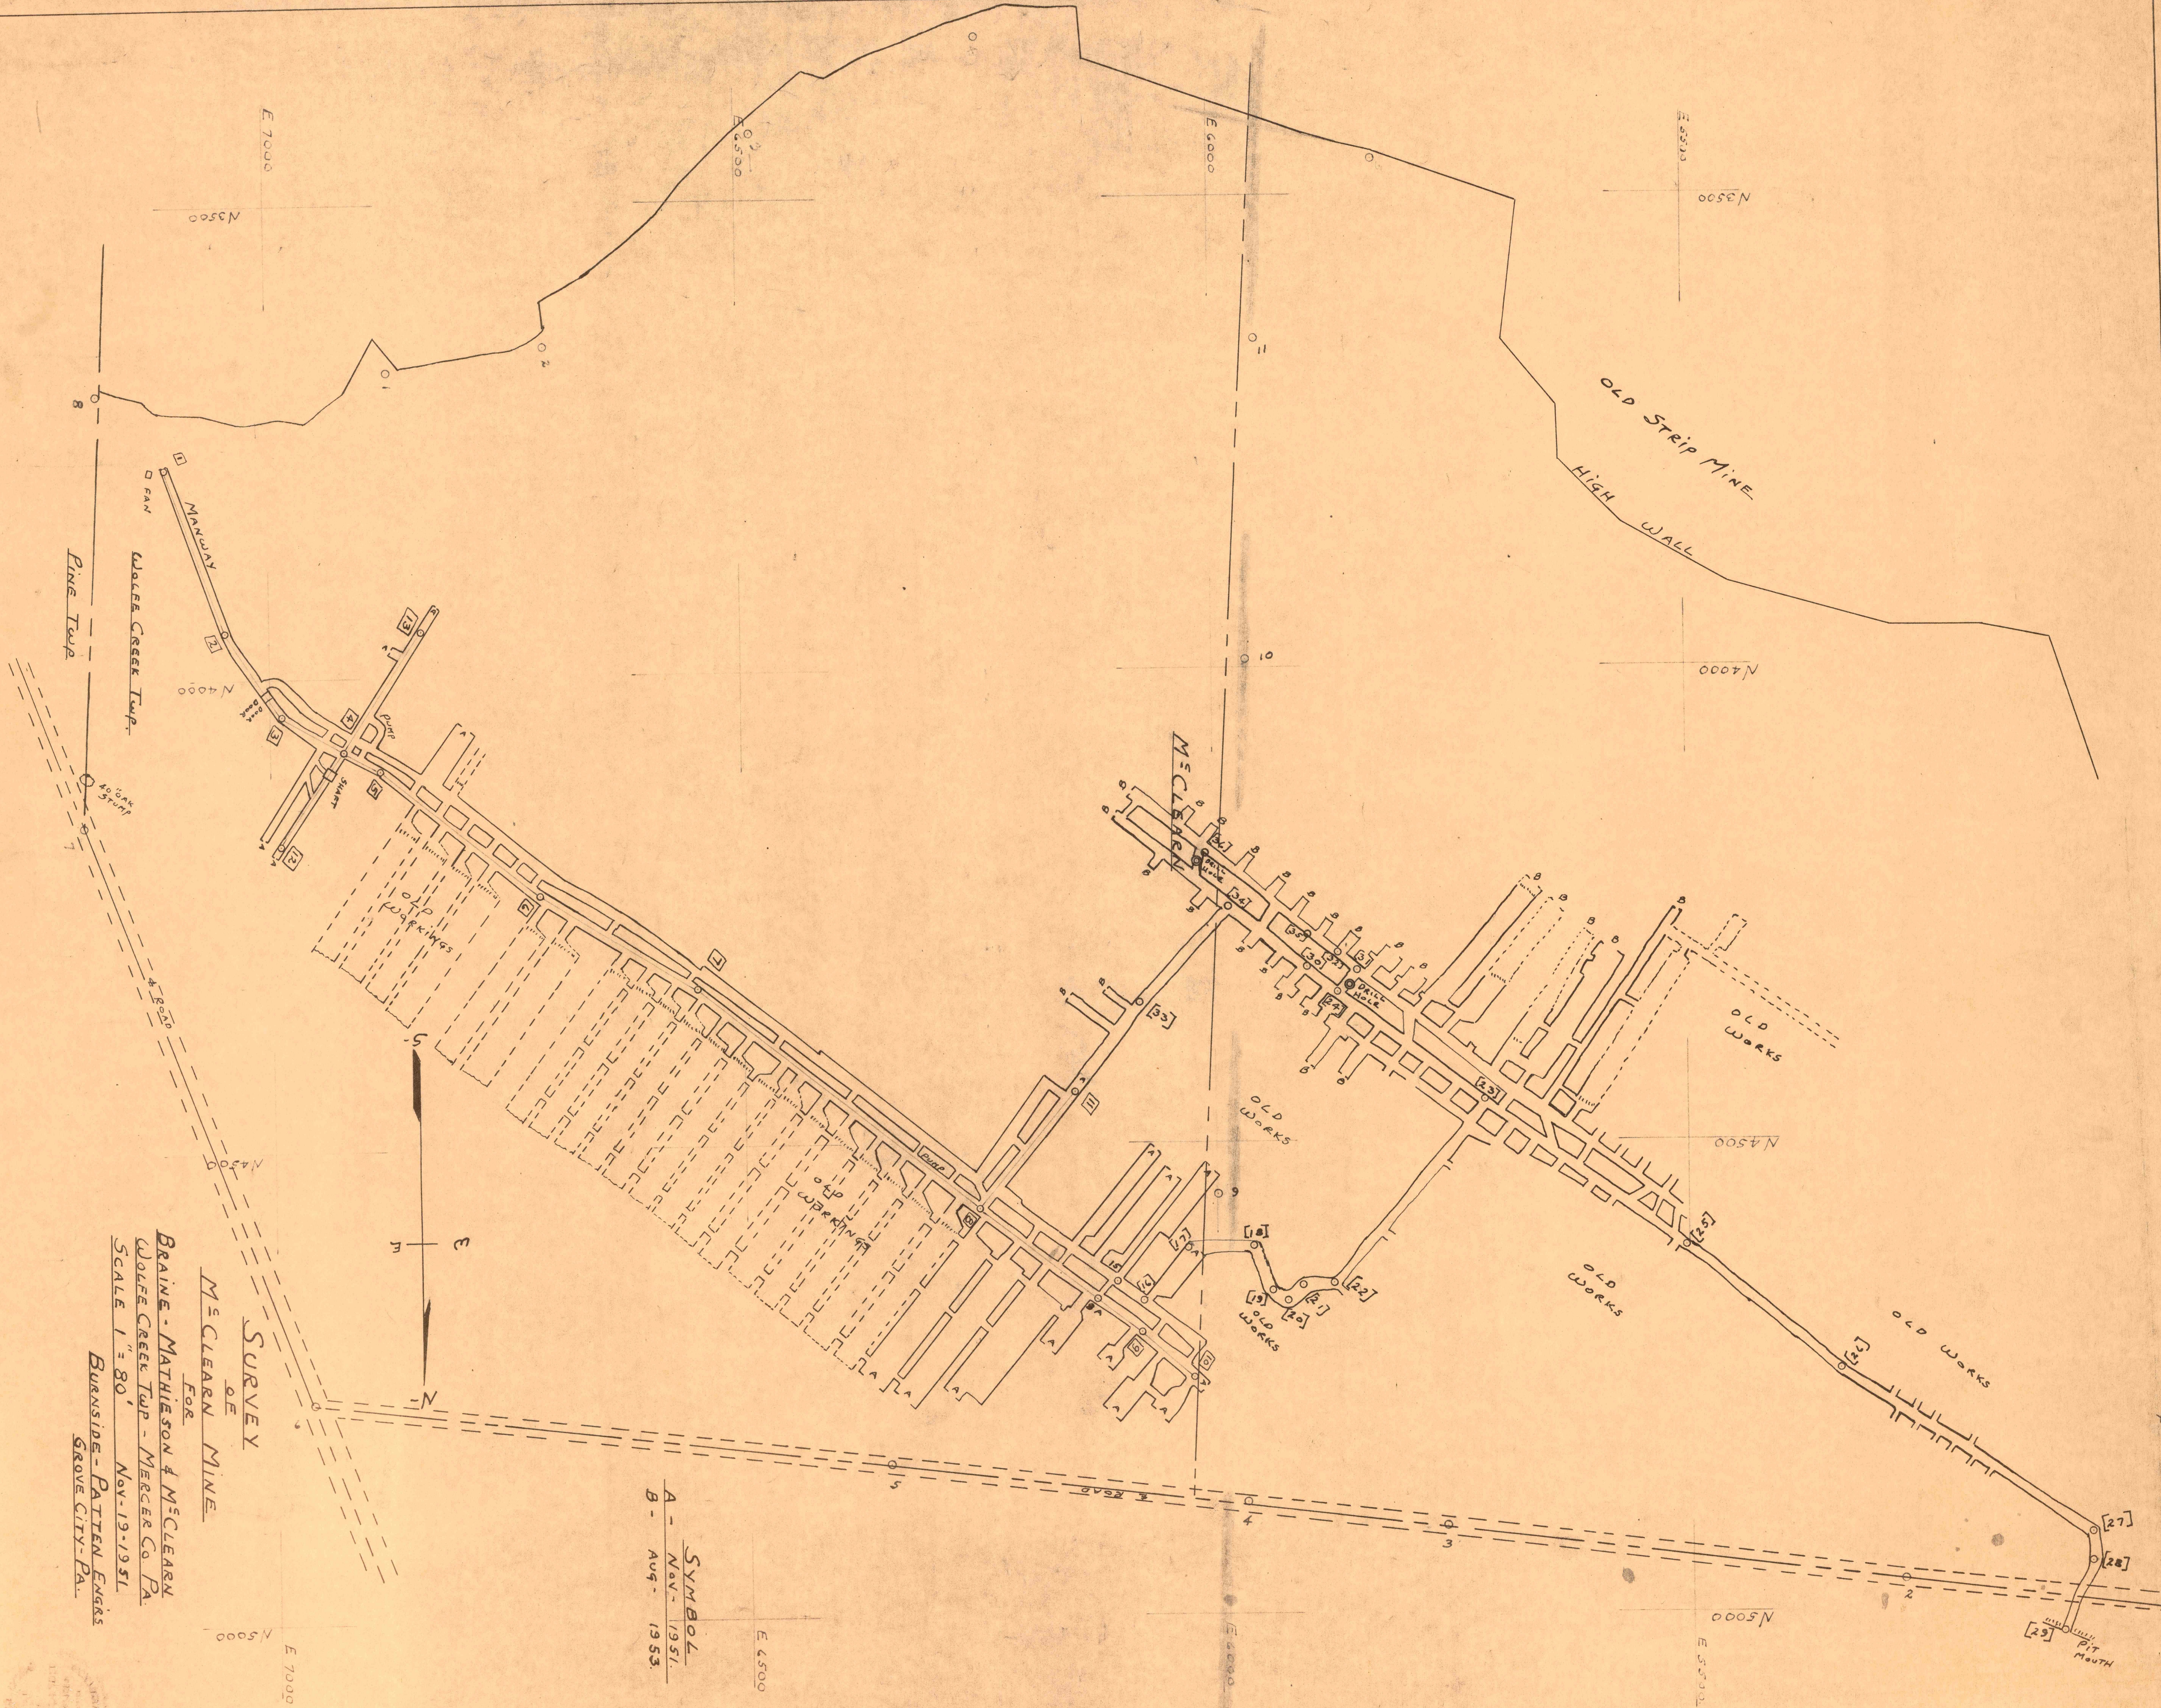

SYMBOL
A - Nov. 1951.
B - Aug. 1953.

SURVEY
OF
McCLEARY
FOR
BRAINE-MATHIESON & McCLEARY
WOLF CREEK TWP - MERCER CO. PA.
SCALE 1" = 80'
Nov. 19-1951
BURNSIDE-PATTEN ENGRS
GROVE CITY - PA.

