




SYMBOL
A - Nov-1951.
B - Aug-1953.

SURVEY
OF
McCLEARN MINE
FOR

BRAINE - MATHIESON & McCLEARN
WOLFE CREEK TWP - MERCER CO. PA.
SCALE 1" = 80' Nov-19-1951
BURNSIDE - PATTEN ENGRS
GROVE CITY - PA.

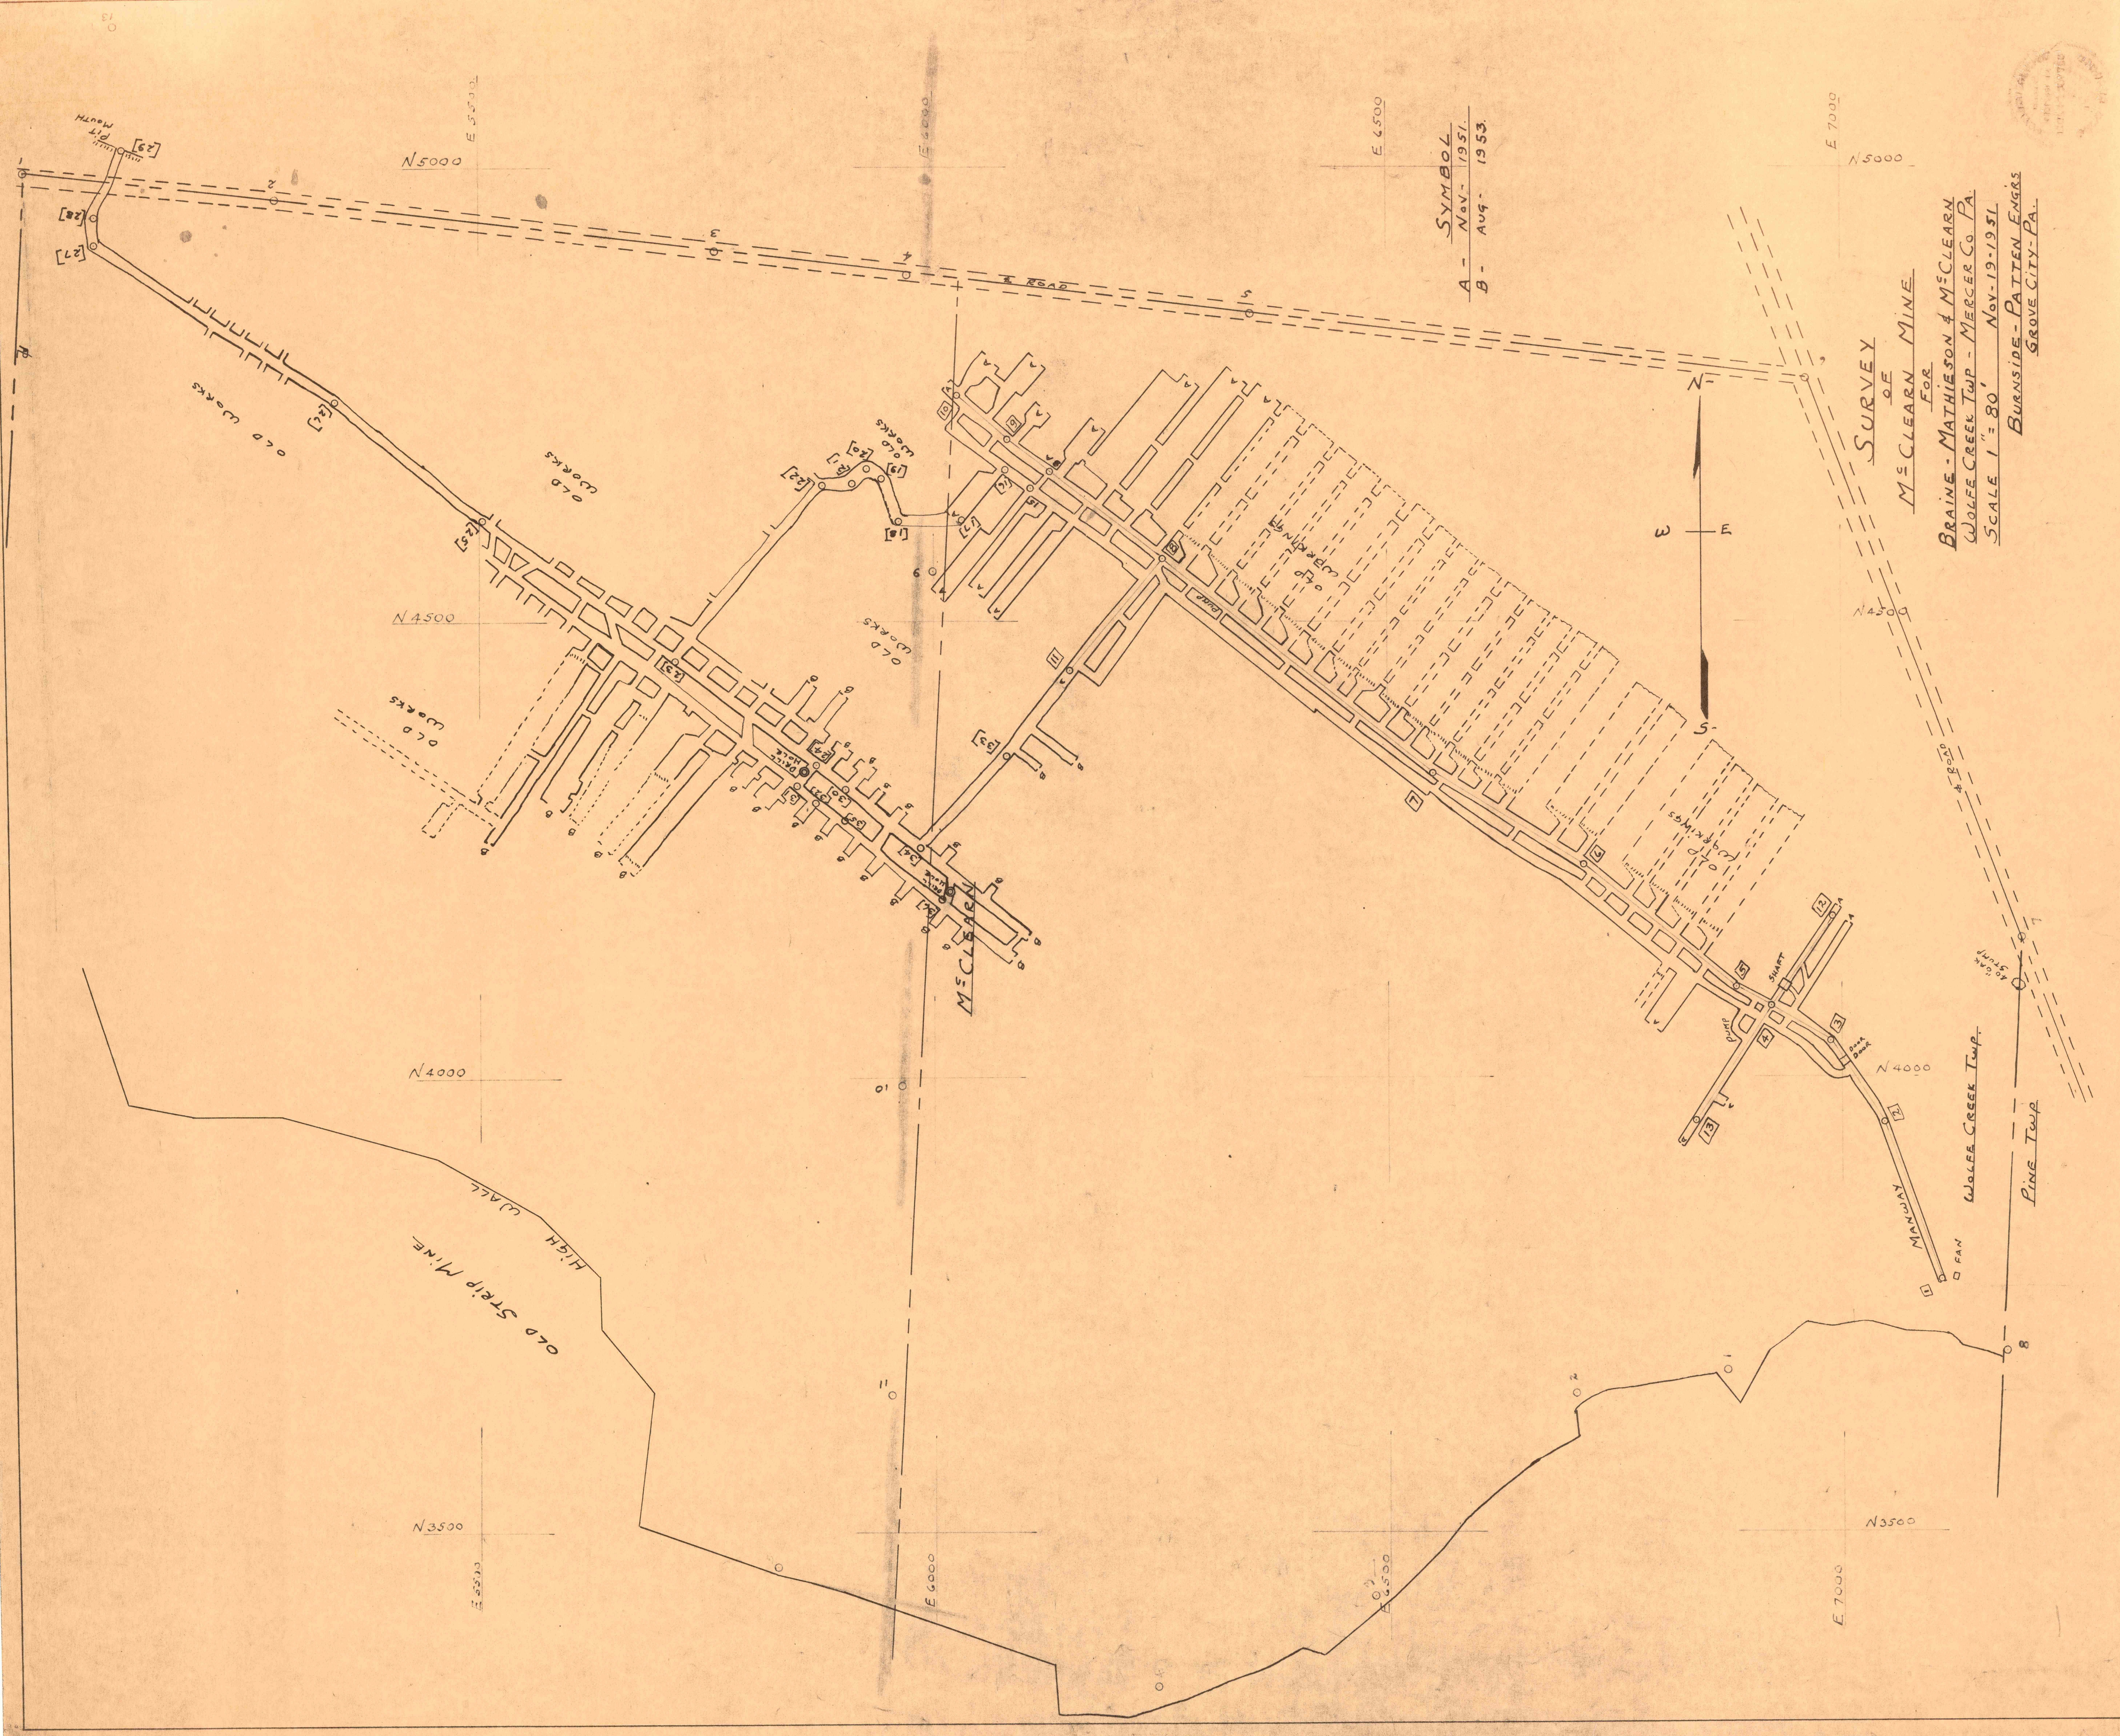