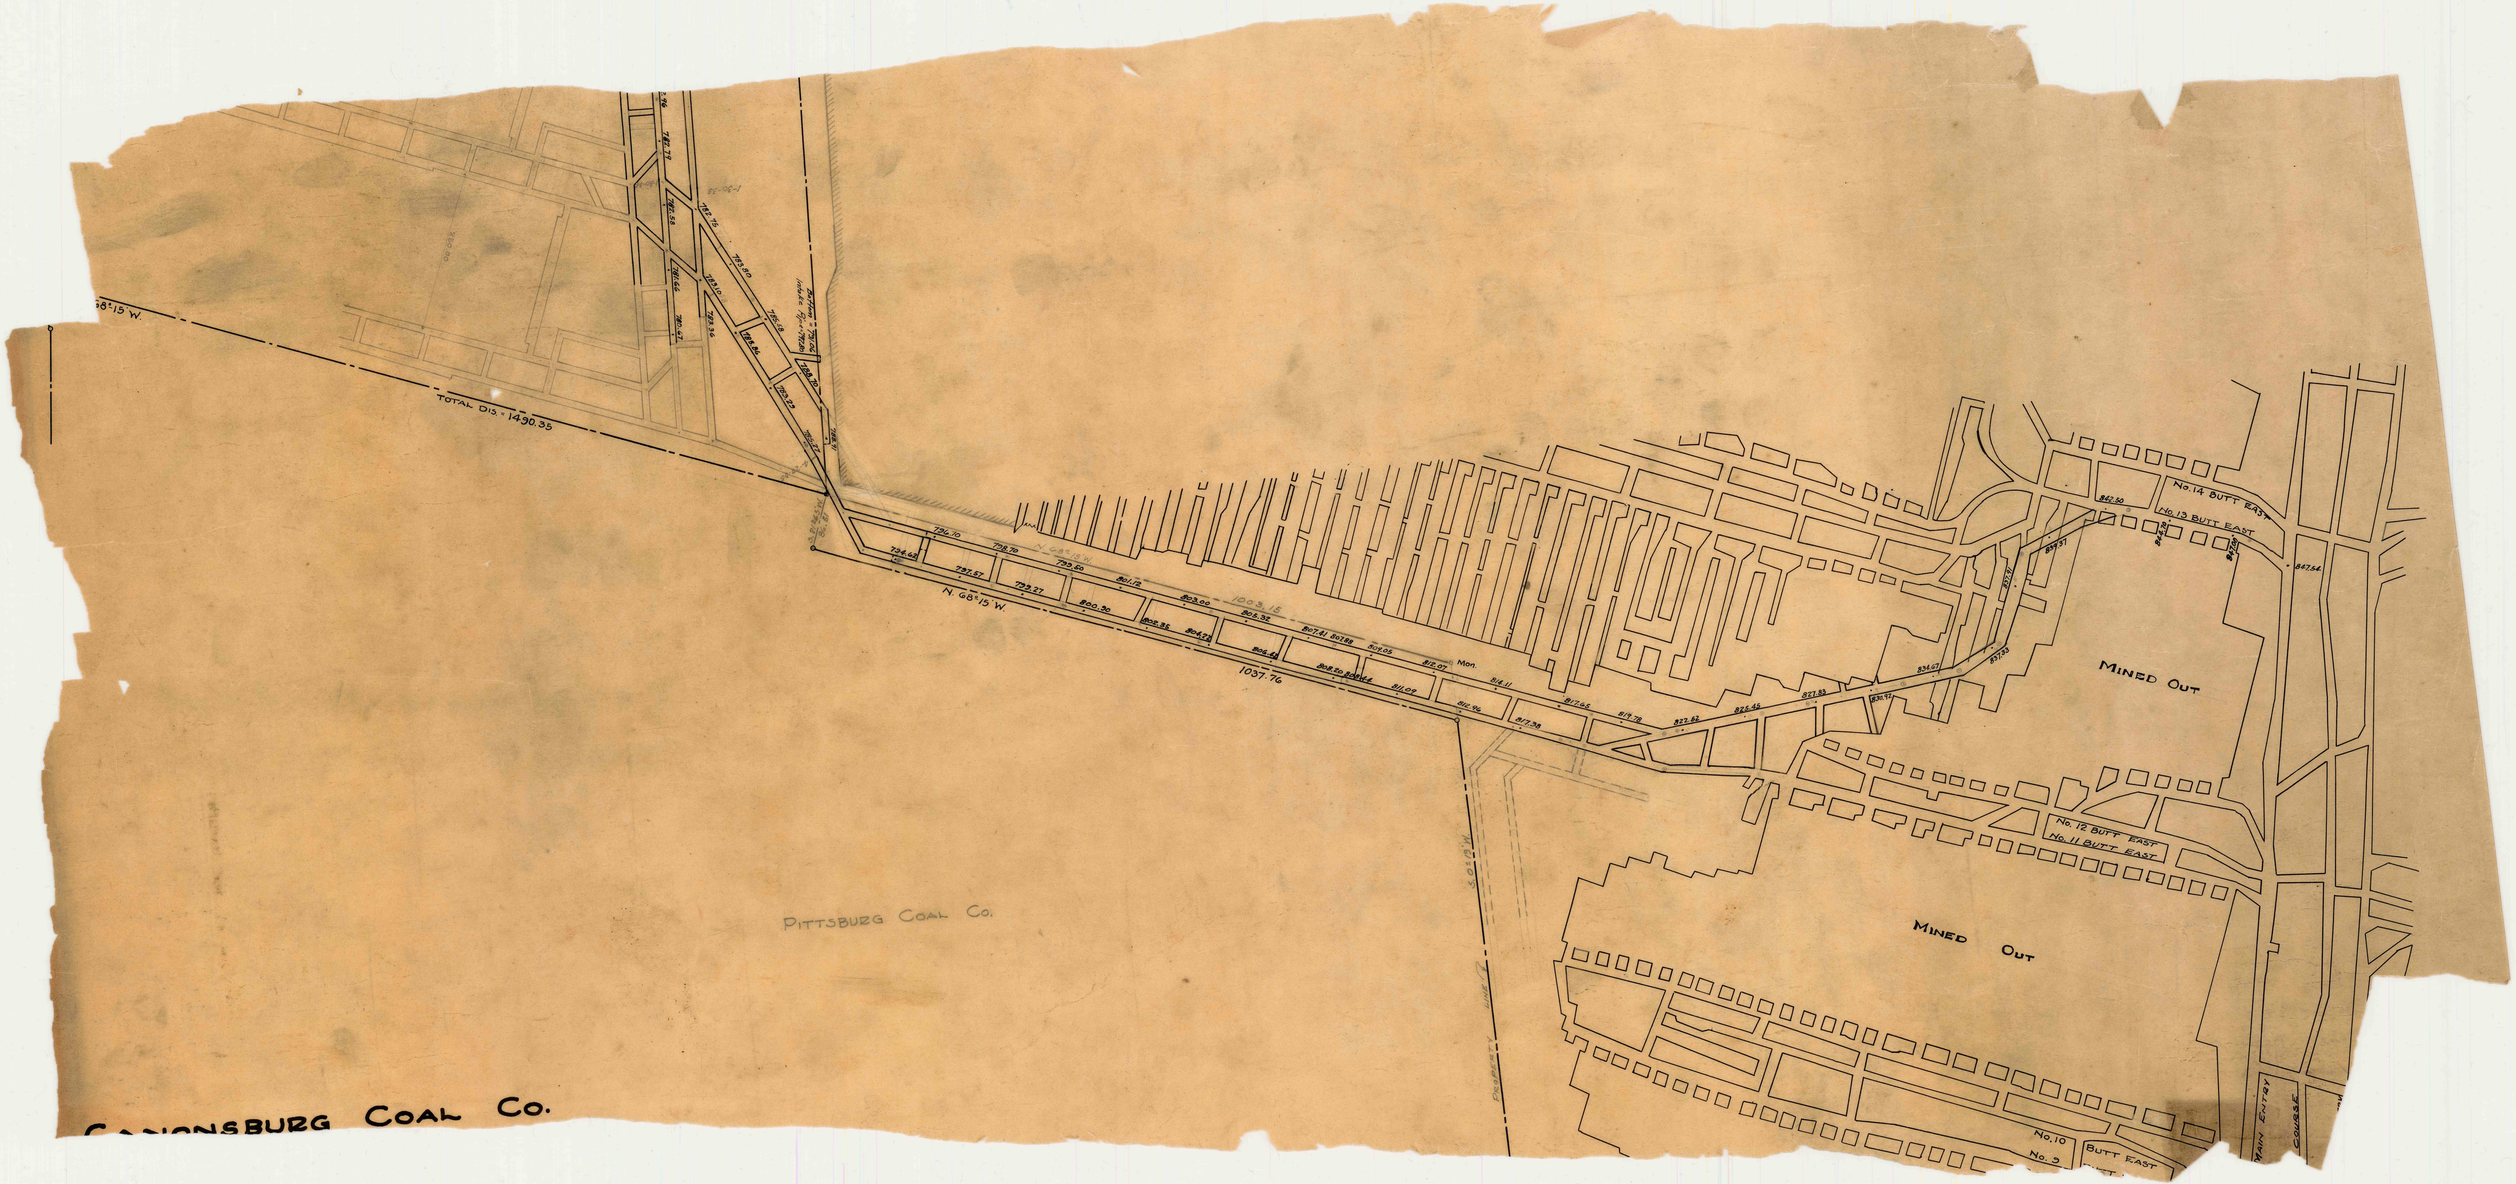
N 68°15 W.
TOTAL DIS. = 1490.35
N 68°15 W.
1057.76
1003.15
Mon.
PITTSBURG COAL CO.
MINED OUT
MINED OUT
No. 14 BUTT EAST
No. 13 BUTT EAST
No. 12 BUTT EAST
No. 11 BUTT EAST
No. 10
No. 9
BUTT EAST
MAIN ENTRY
COURSE
PROPERTY LINE
PITTSBURG COAL CO.