


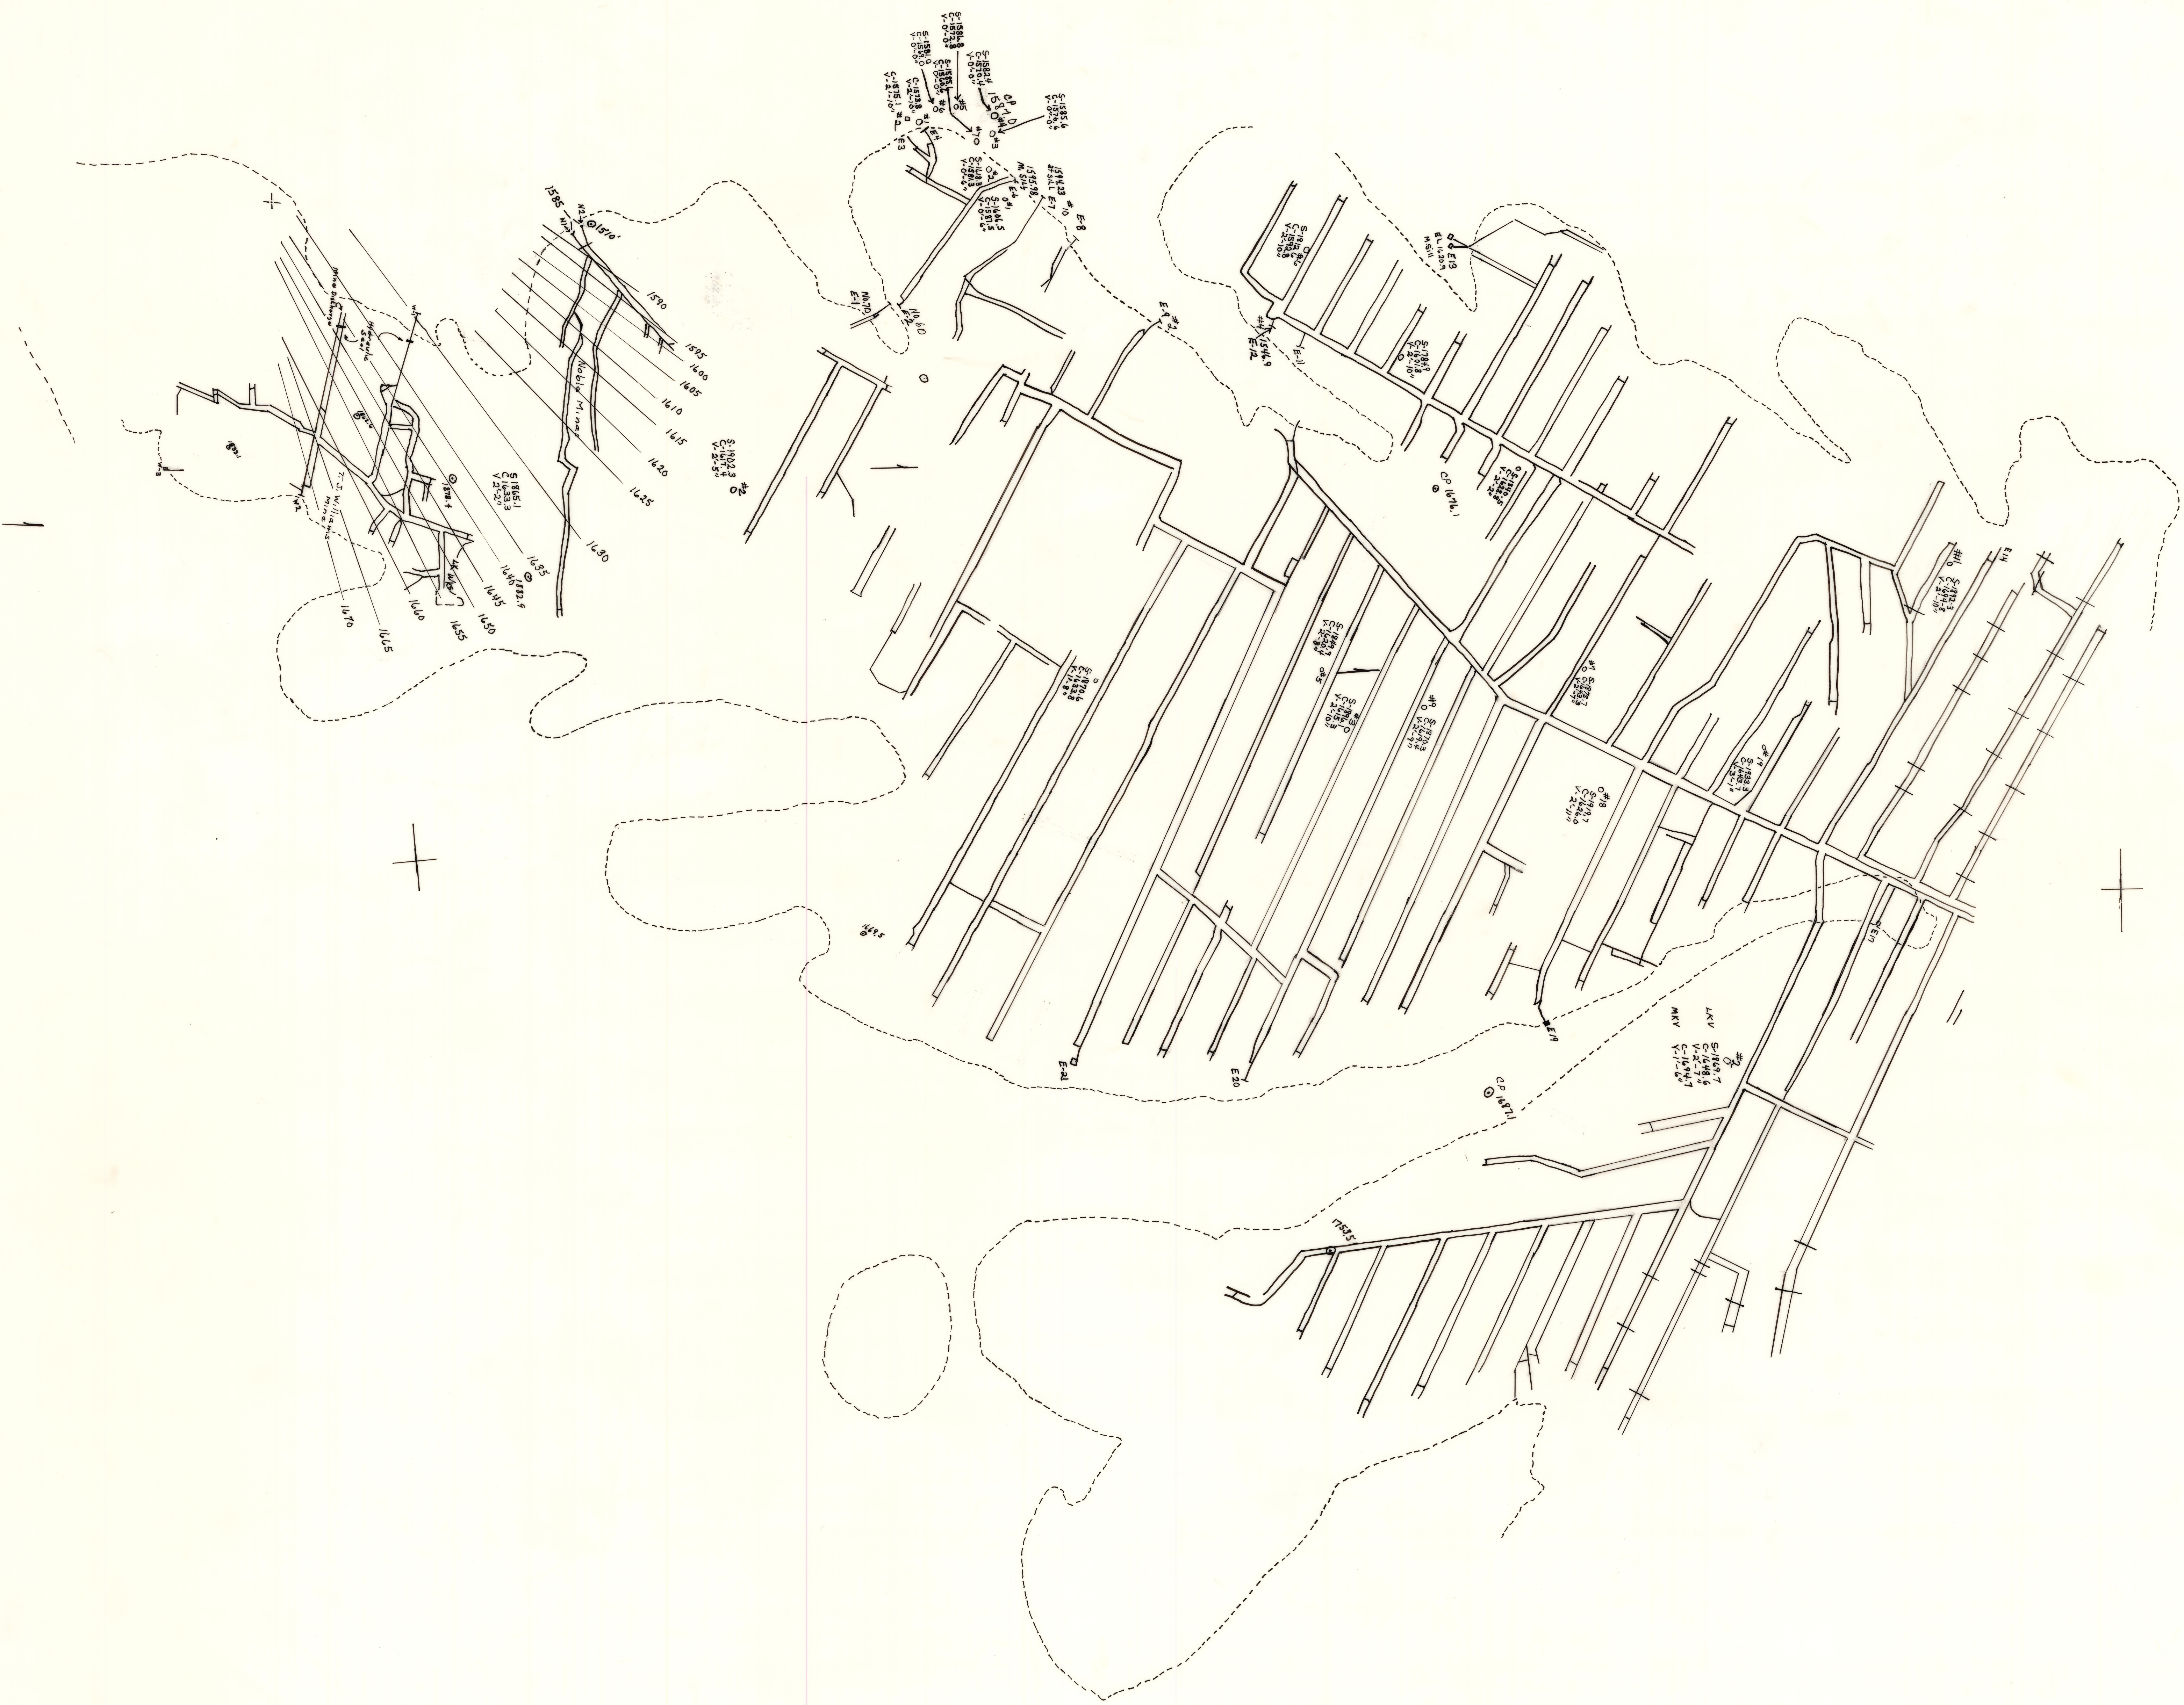

L.R. Seaman
Camp
Sketch
12.13.12