


1000 ft. scale




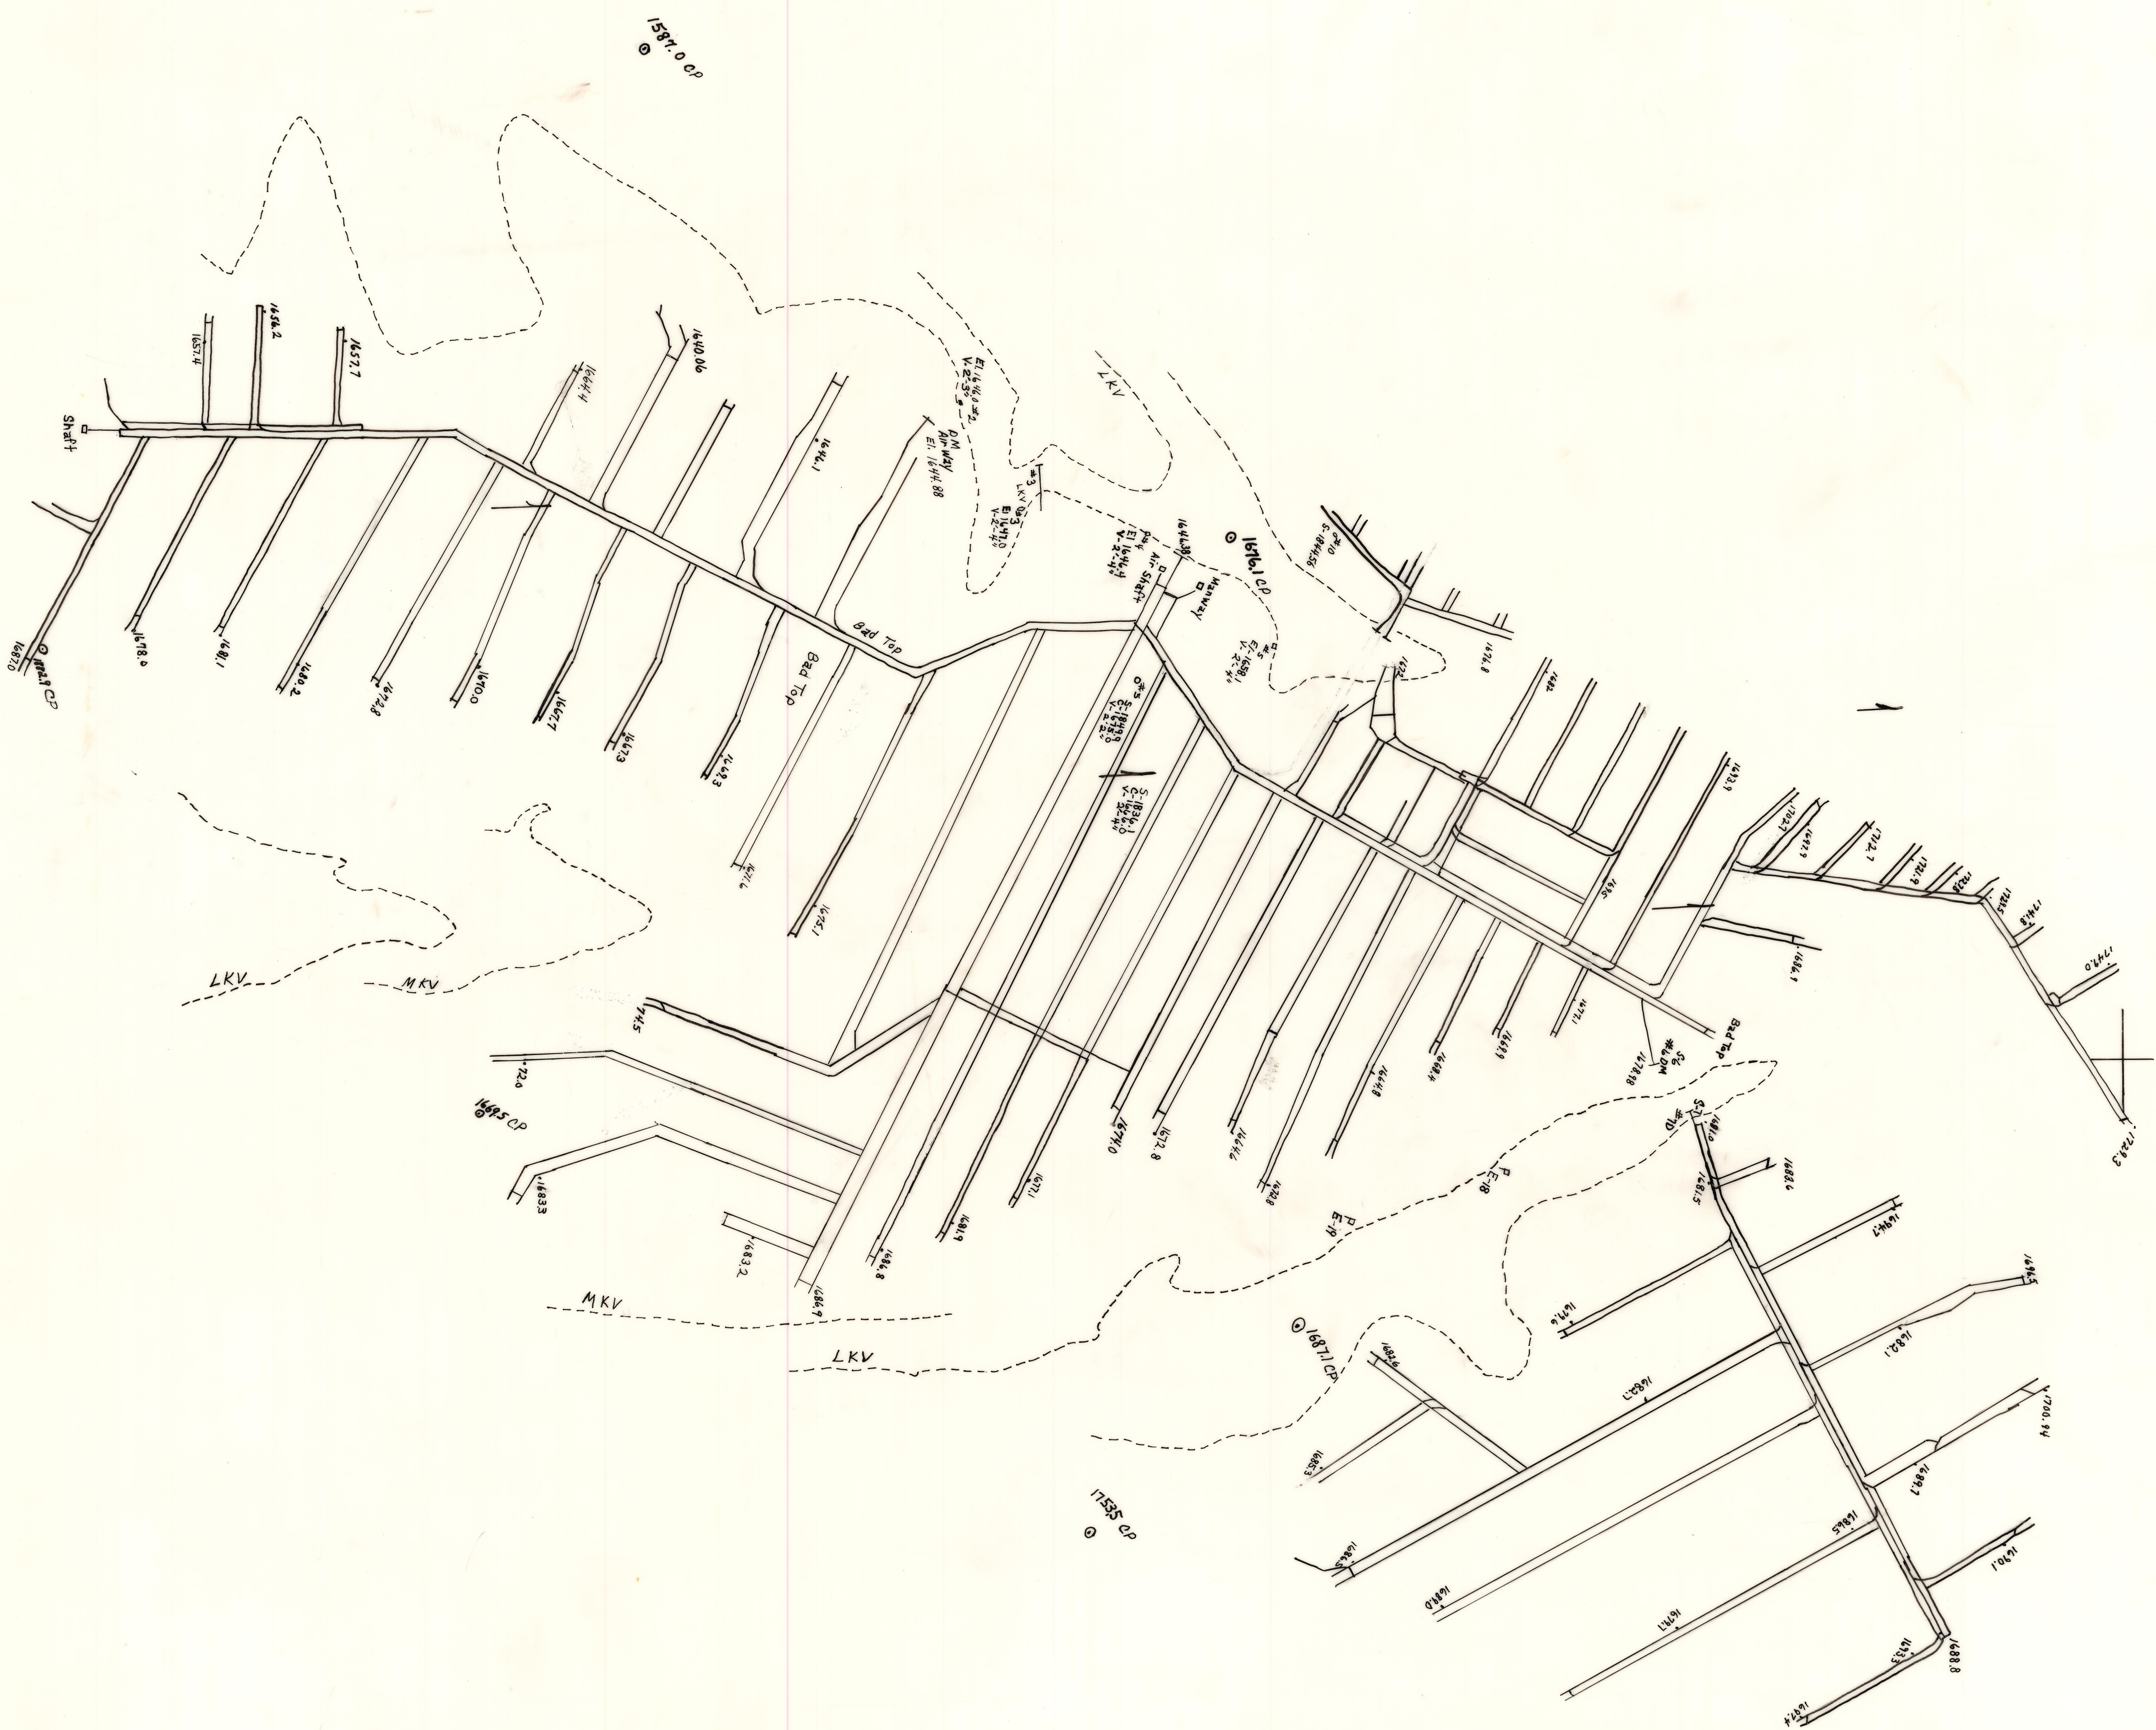

M K
Saam
(Thin)