
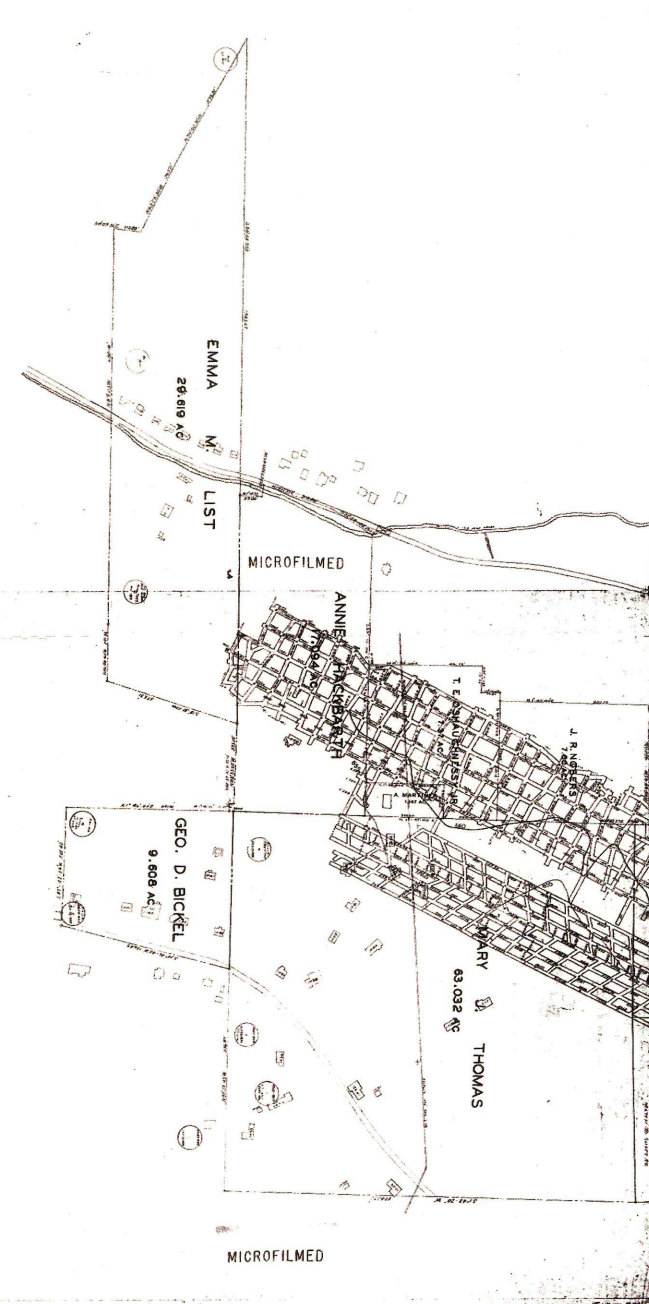


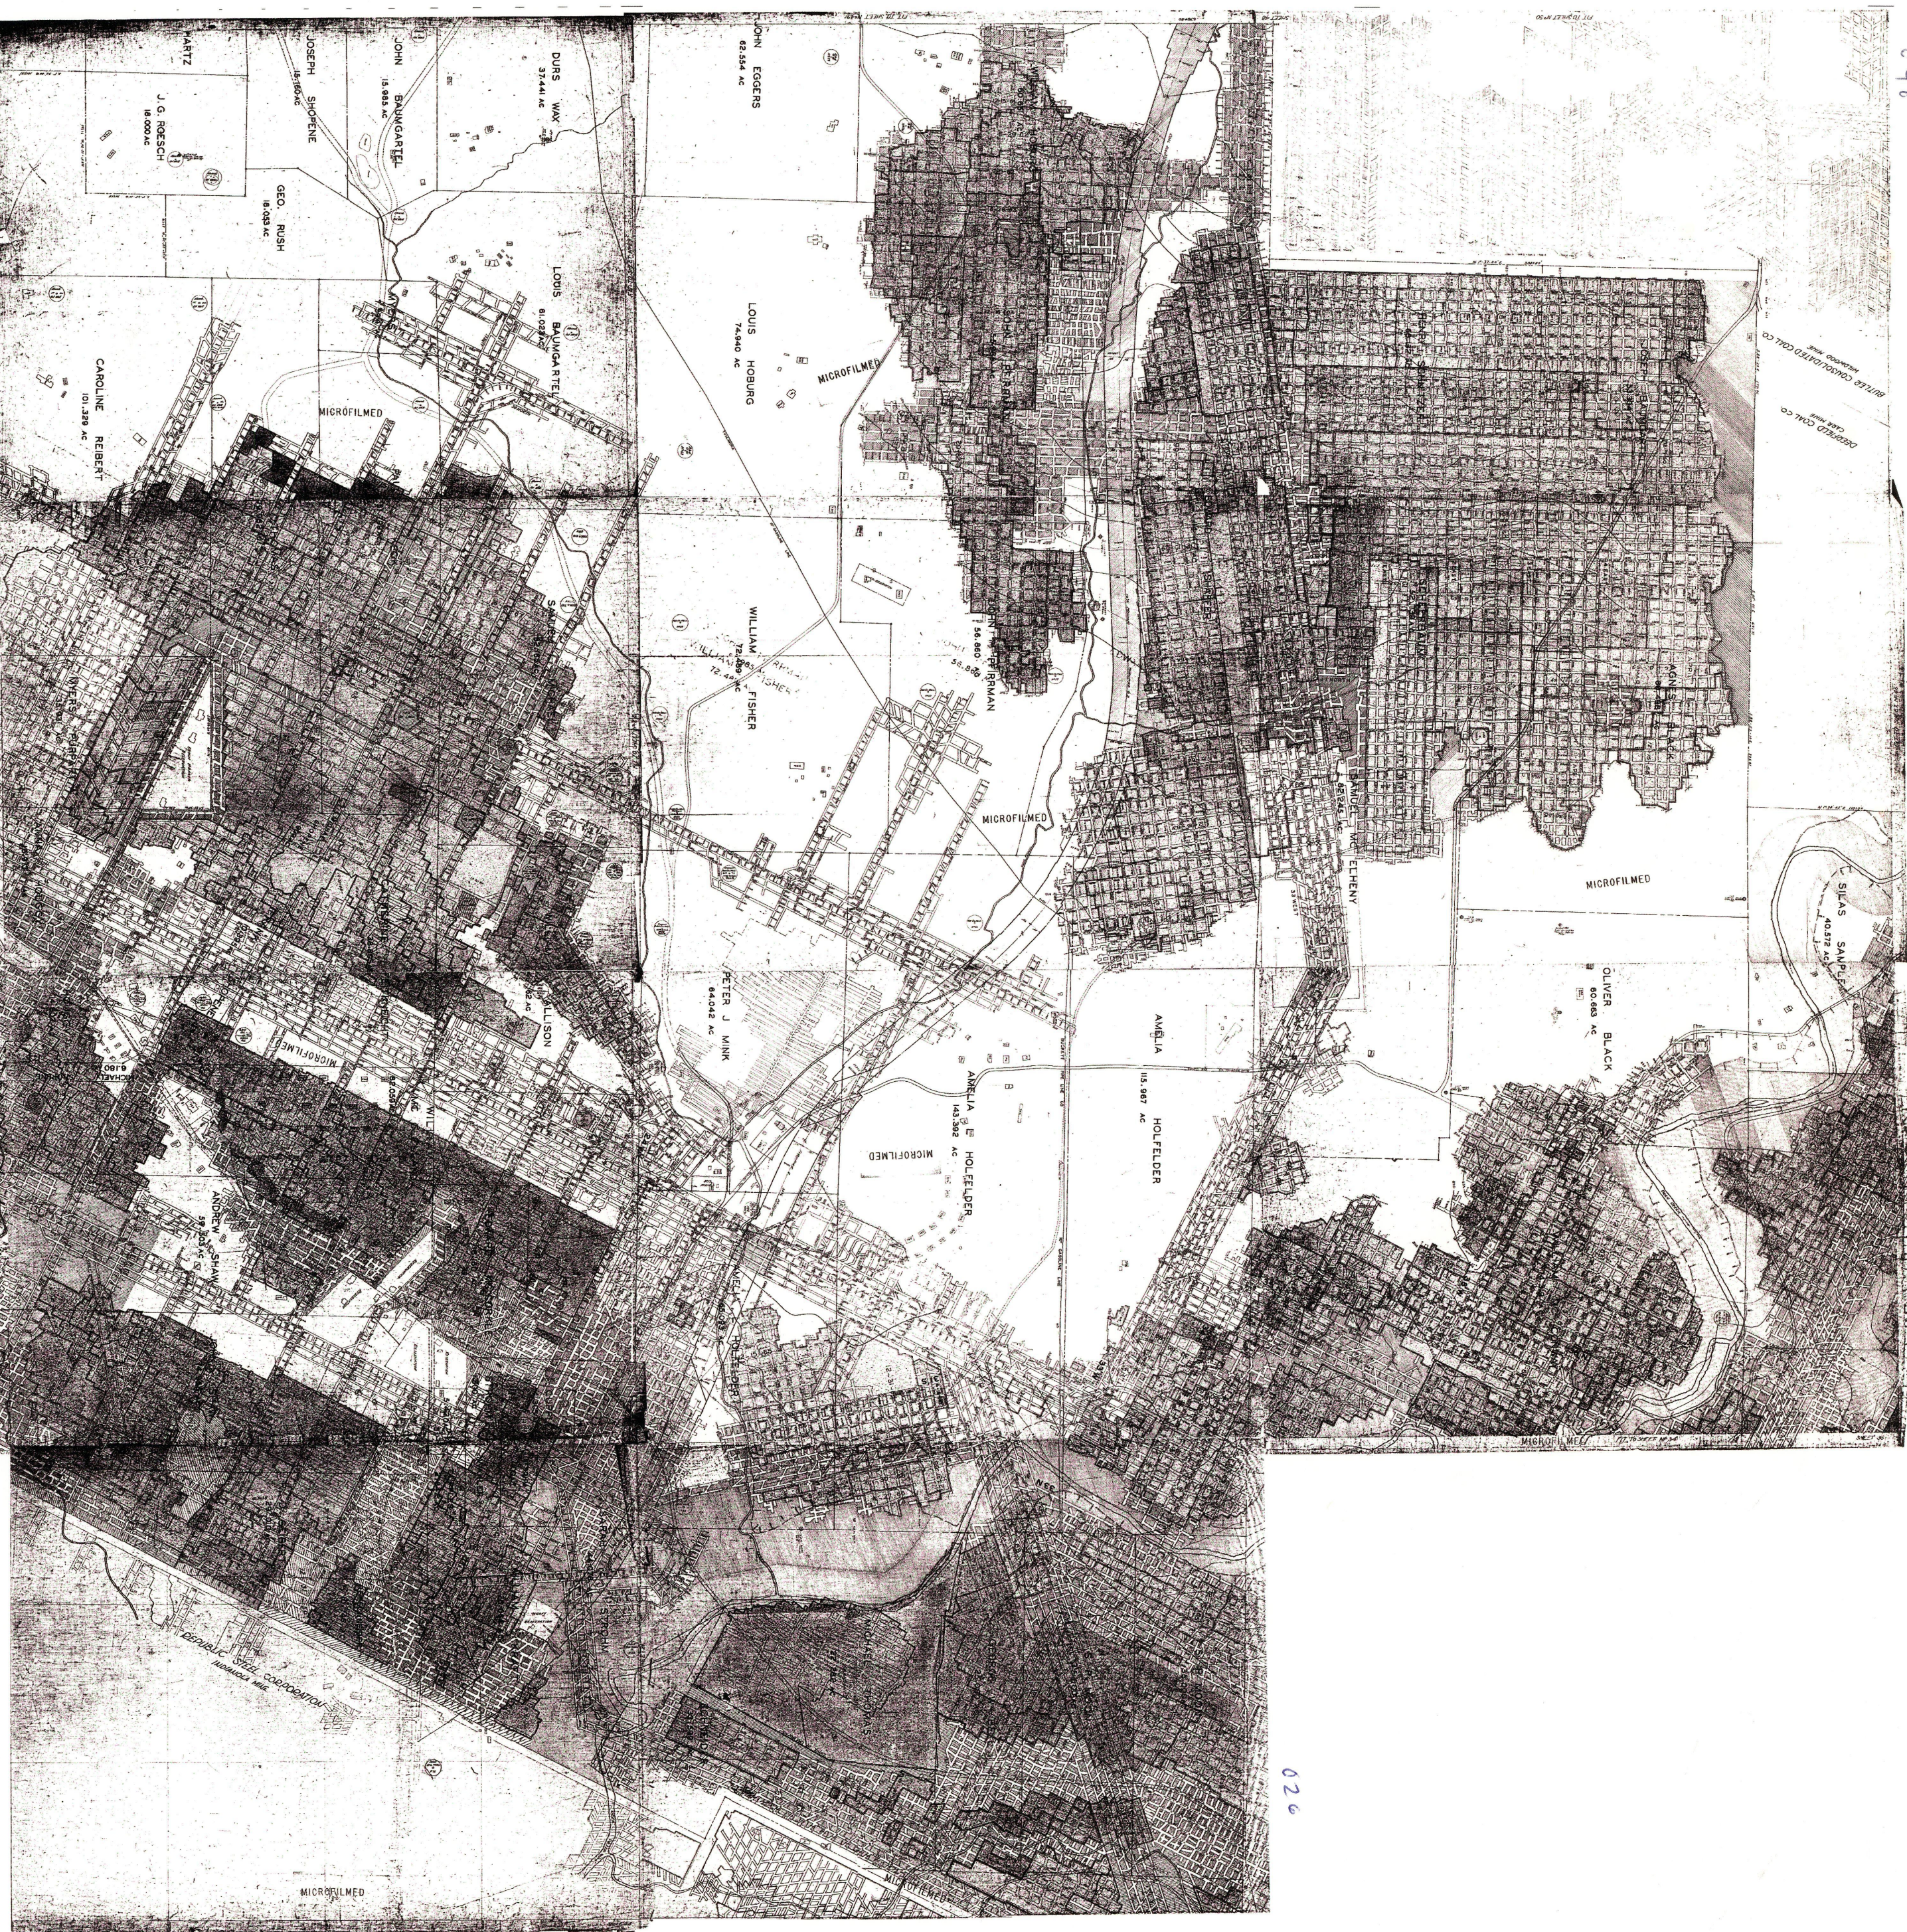

048

035

048

024

030

020

033

035

036

026

024

027

019

015

031

016

037

036