



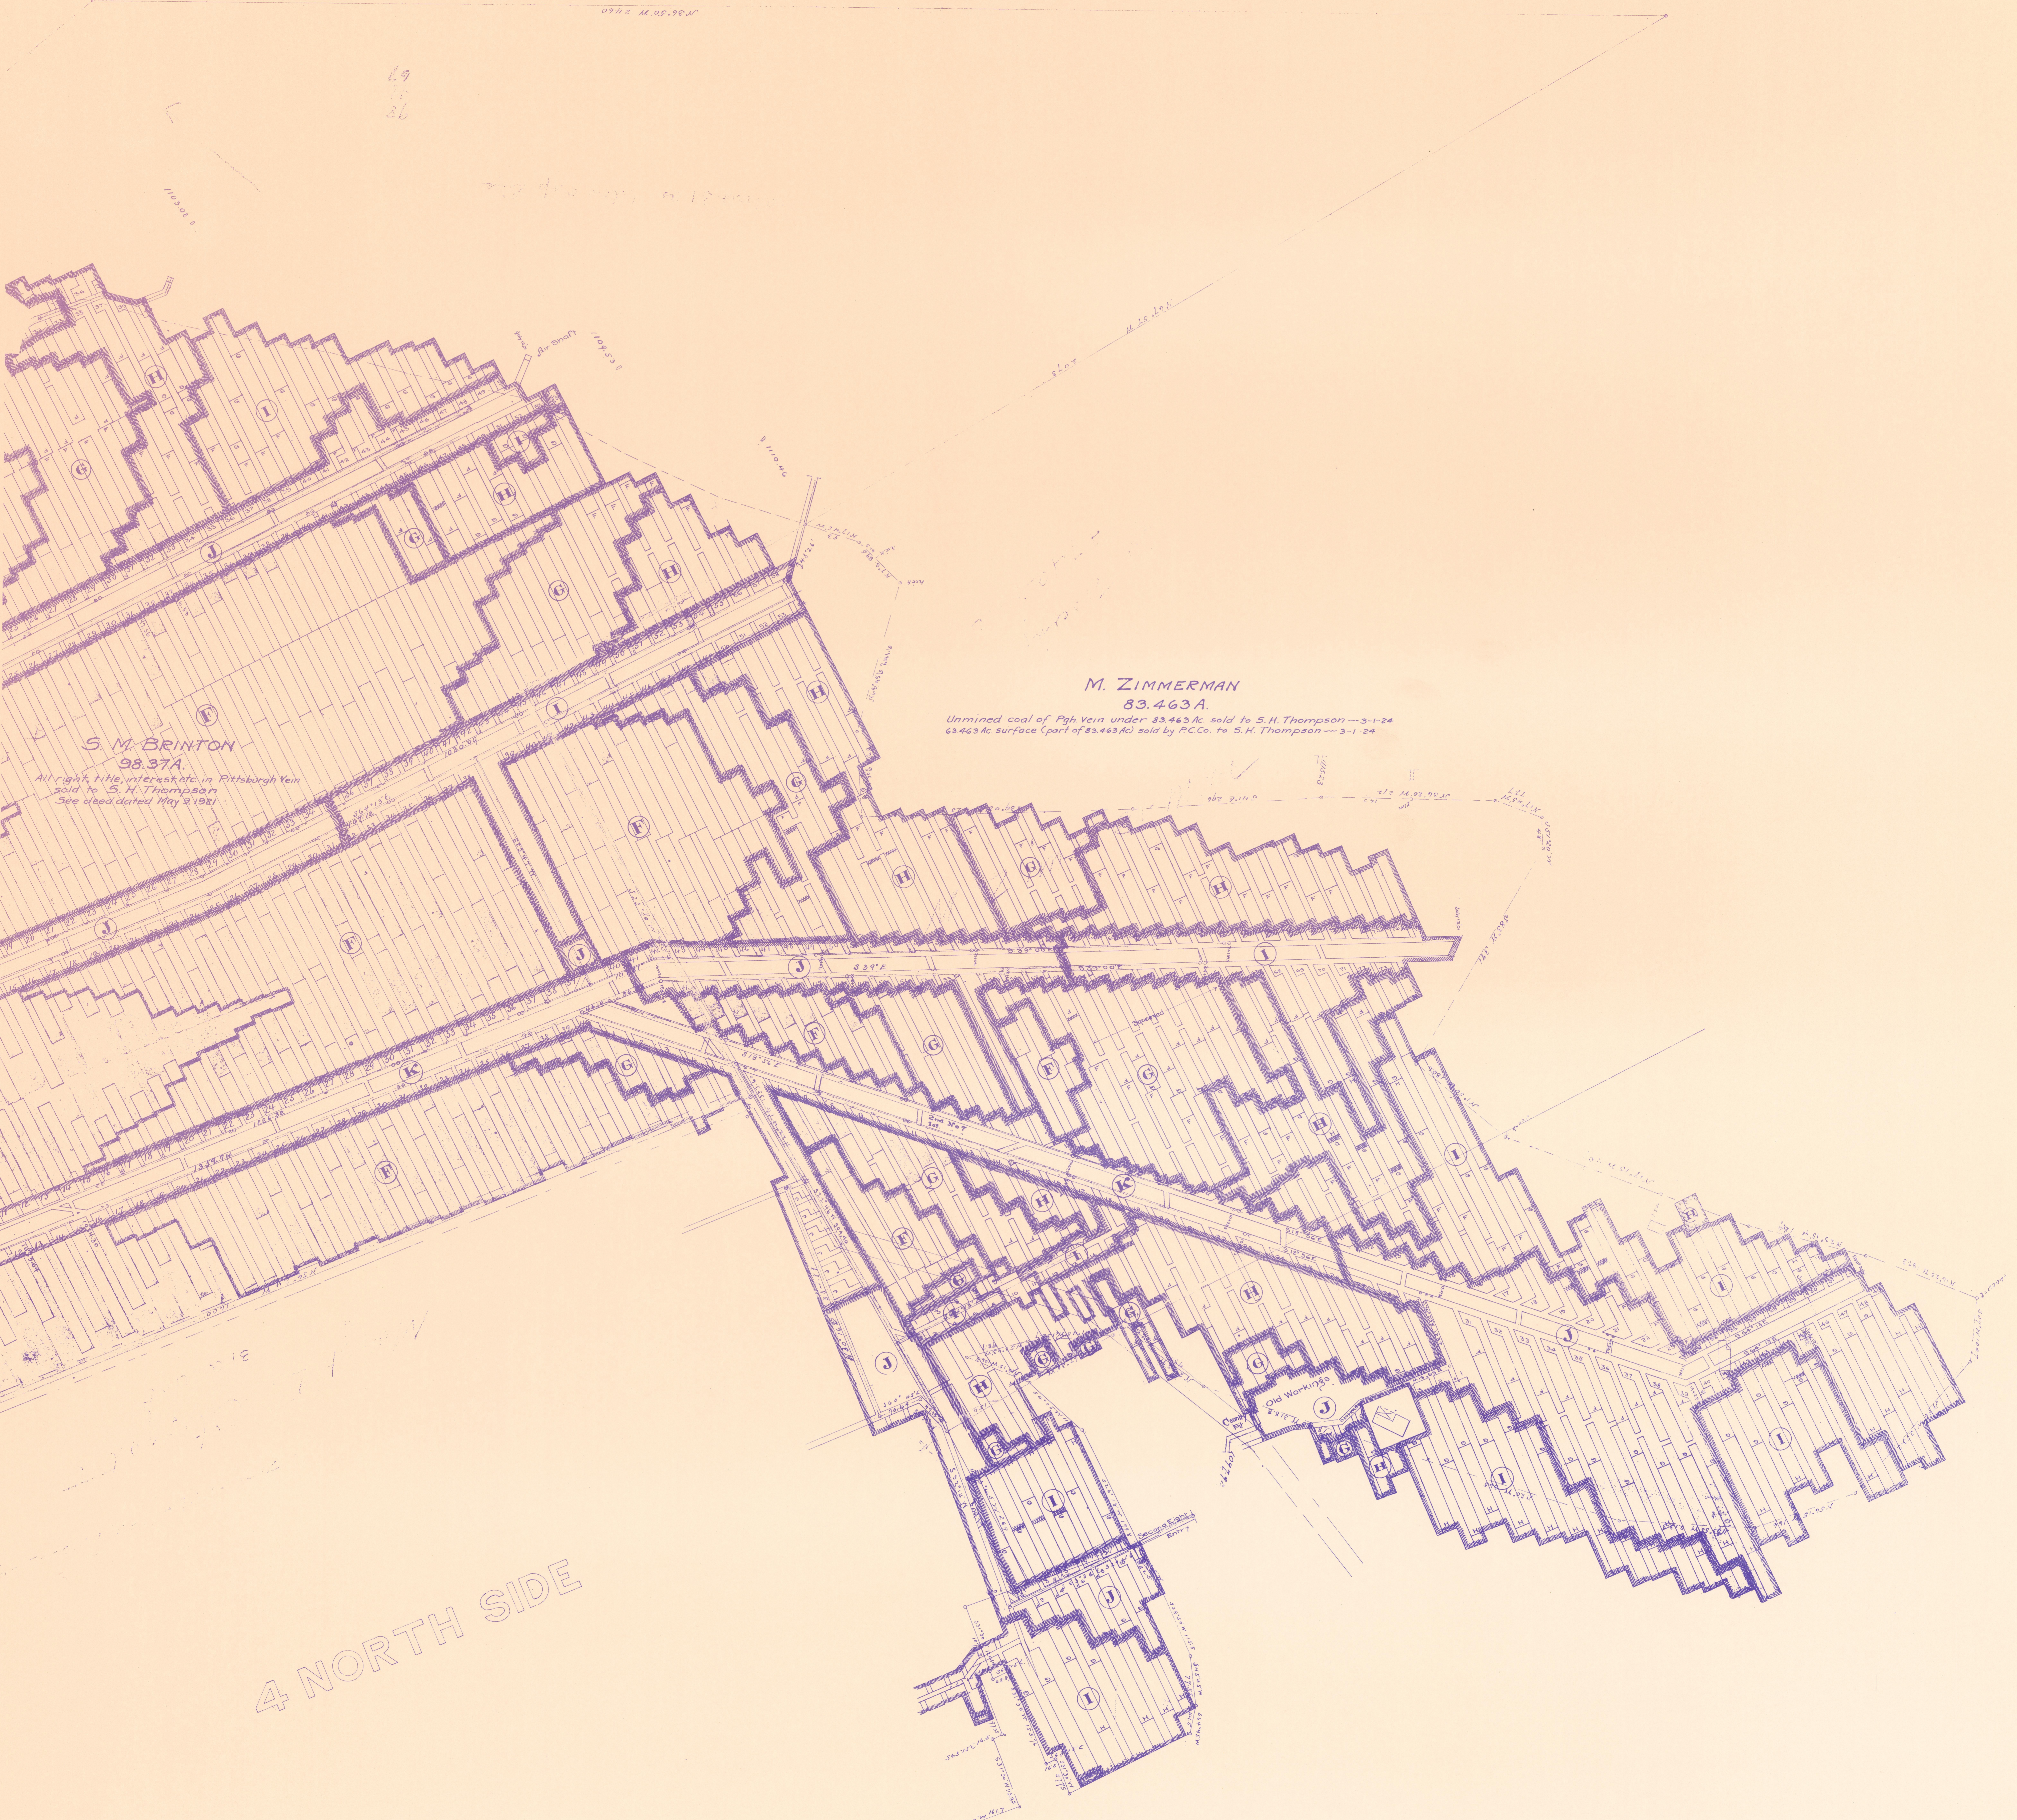

4 NORTH SIDE

Coal mined in Nos. 1, 2, 3, 4, 5 & 6 Entries prior to Mar 19 1900 and indicated thus 2.0476
 and Nos. 7, 8, 9, 10 & 11 Entries from Mar 19 to Aug 1900 " 12.352
 mined in other Entries " " " 20.280
 mined between Aug 1900 and Jan 1st 1901 " " " 2.1146

M. ZIMMERMAN
 83.463A
 Unmined coal of Pgh Ven under 83.463A sold to S. H. Thompson—3-1-24
 83.463A surface part of 83.463A sold by R.C. Co. to S. H. Thompson—3-1-24

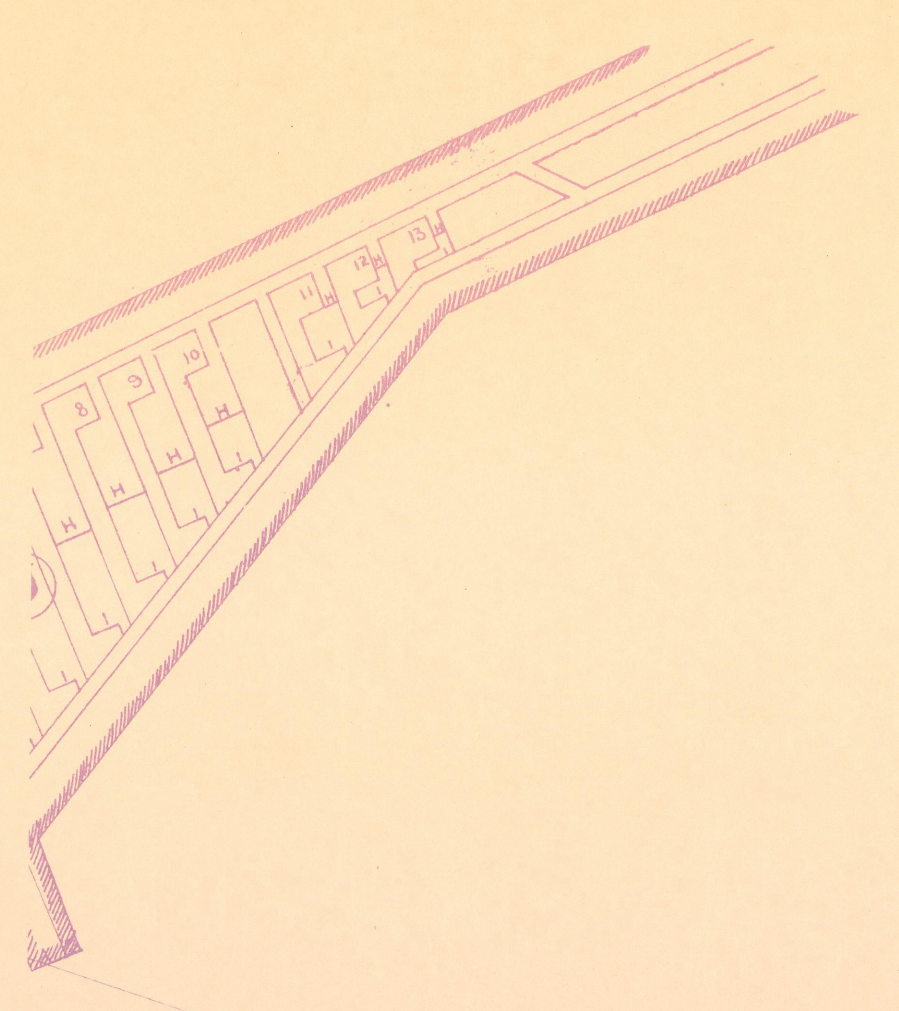