


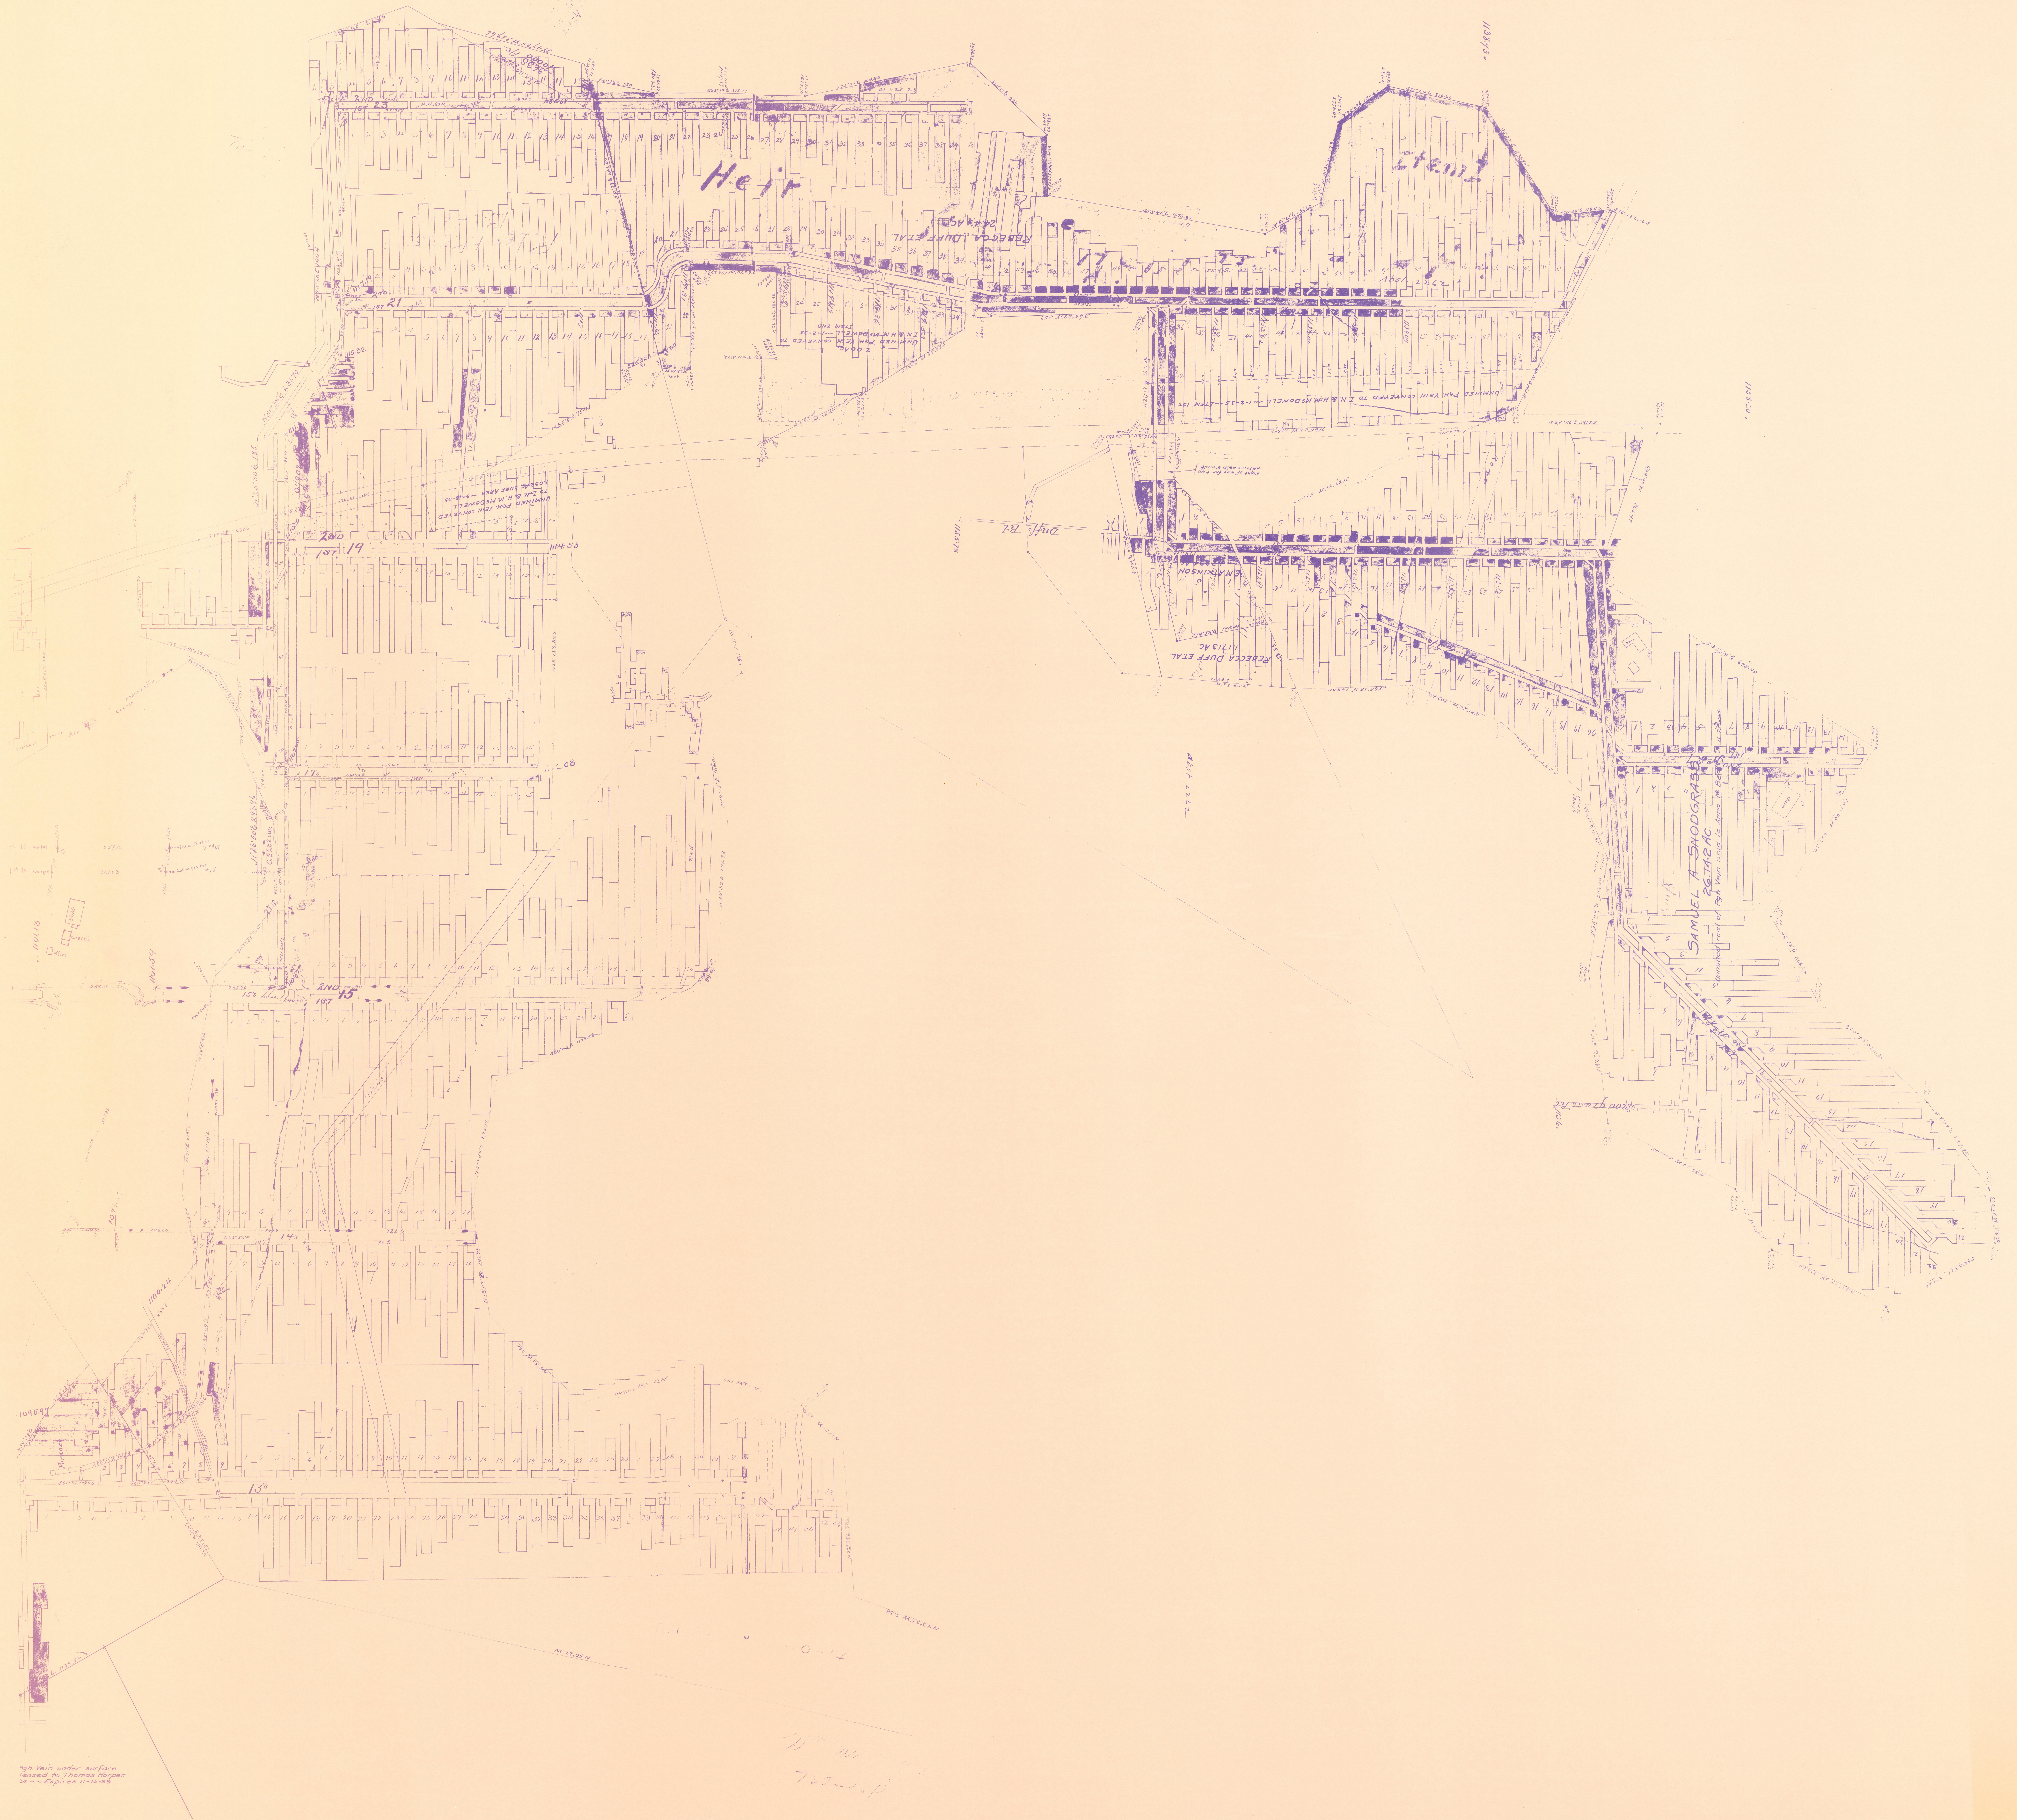

Sp. Vert. under surface
leased to Thomas Harper
se — Expires 11-10-25

1100 100-100
725-100