


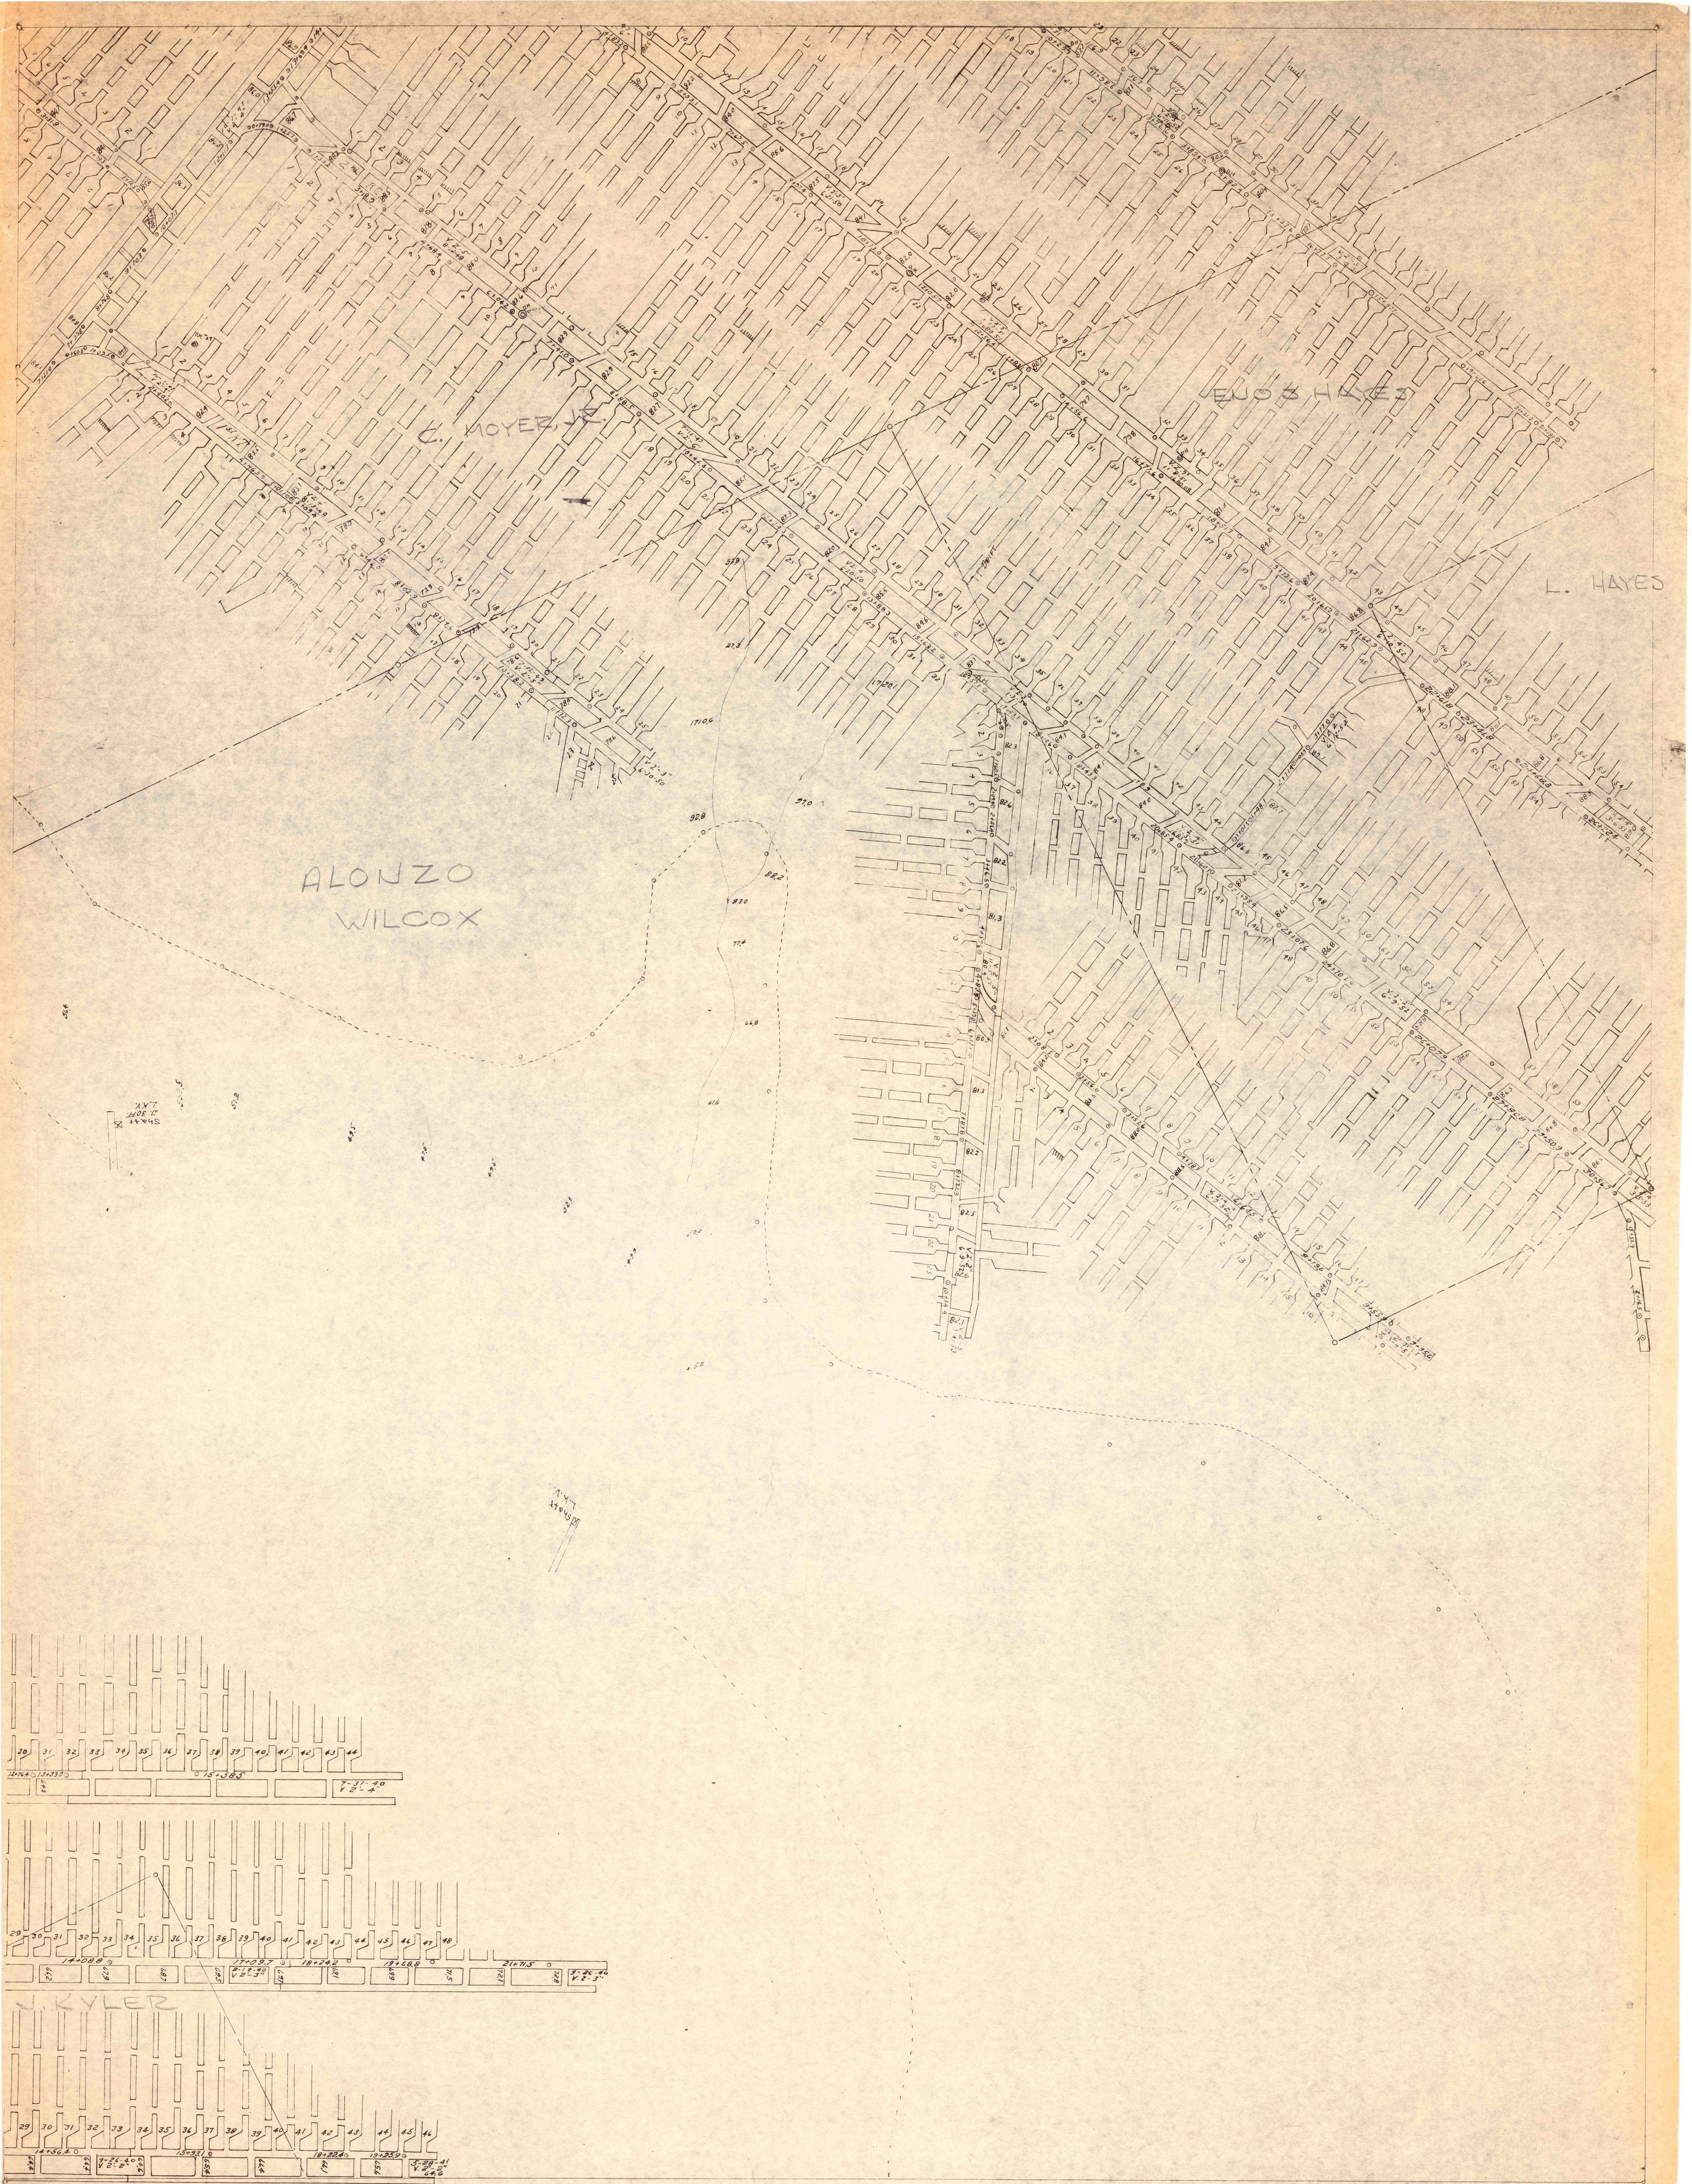

C. MOYER, JR.

EUOD HAYES

L. HAYES

ALONZO
WILCOX

J. KYLER