
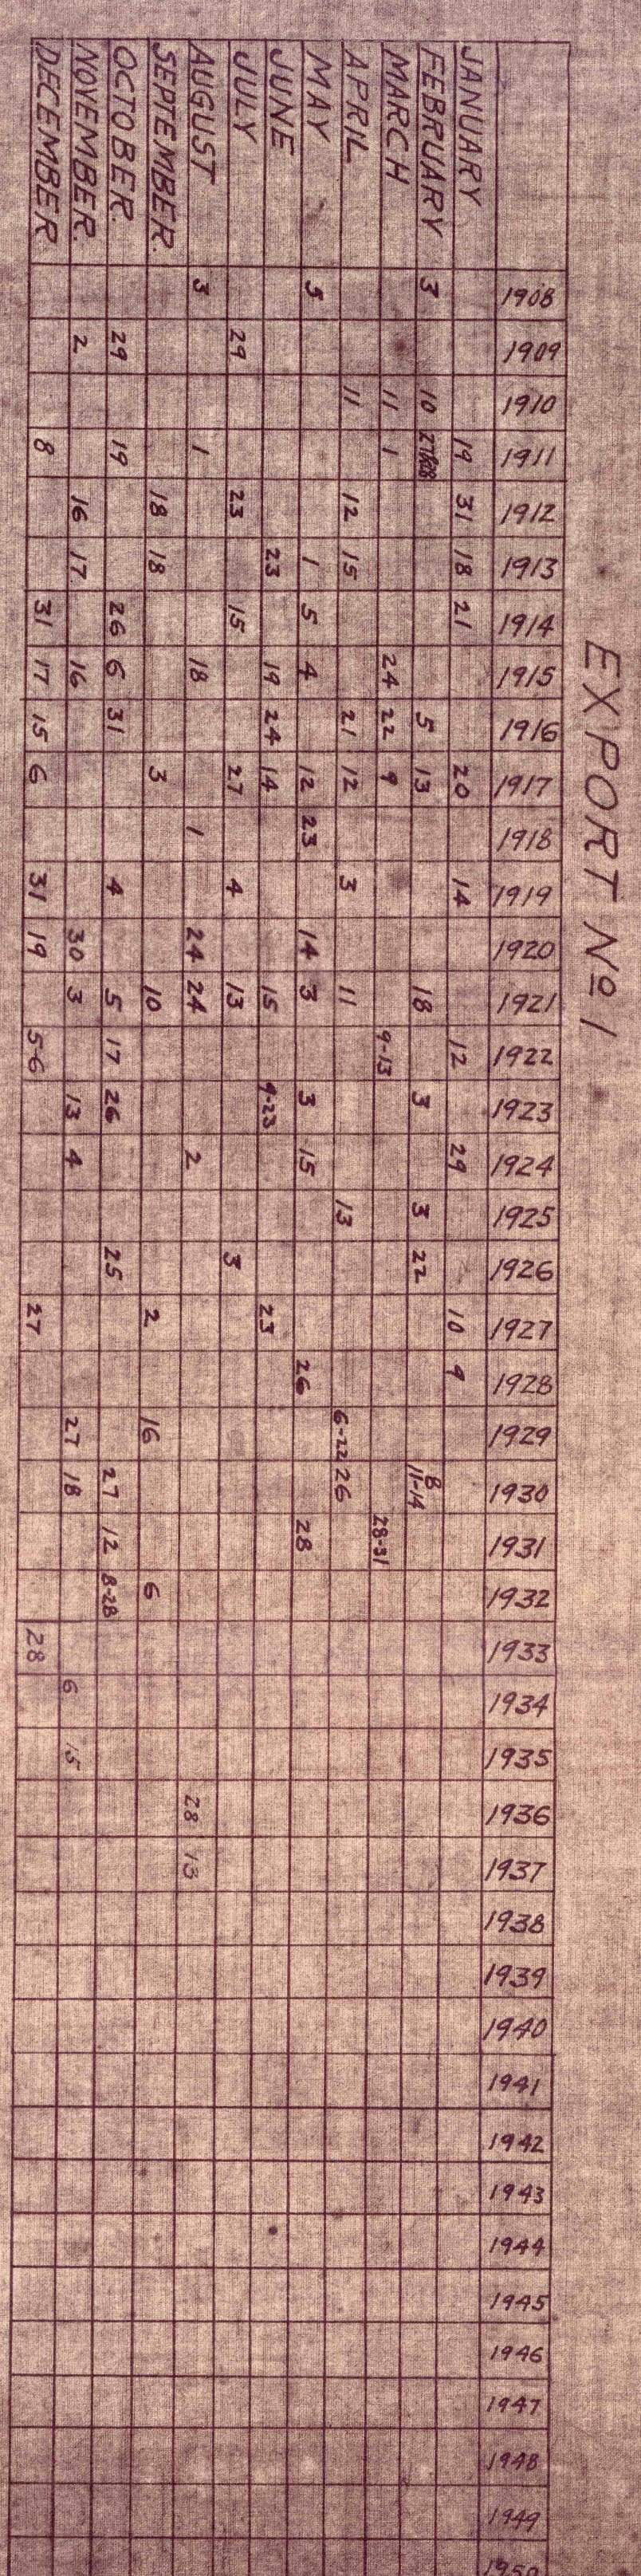


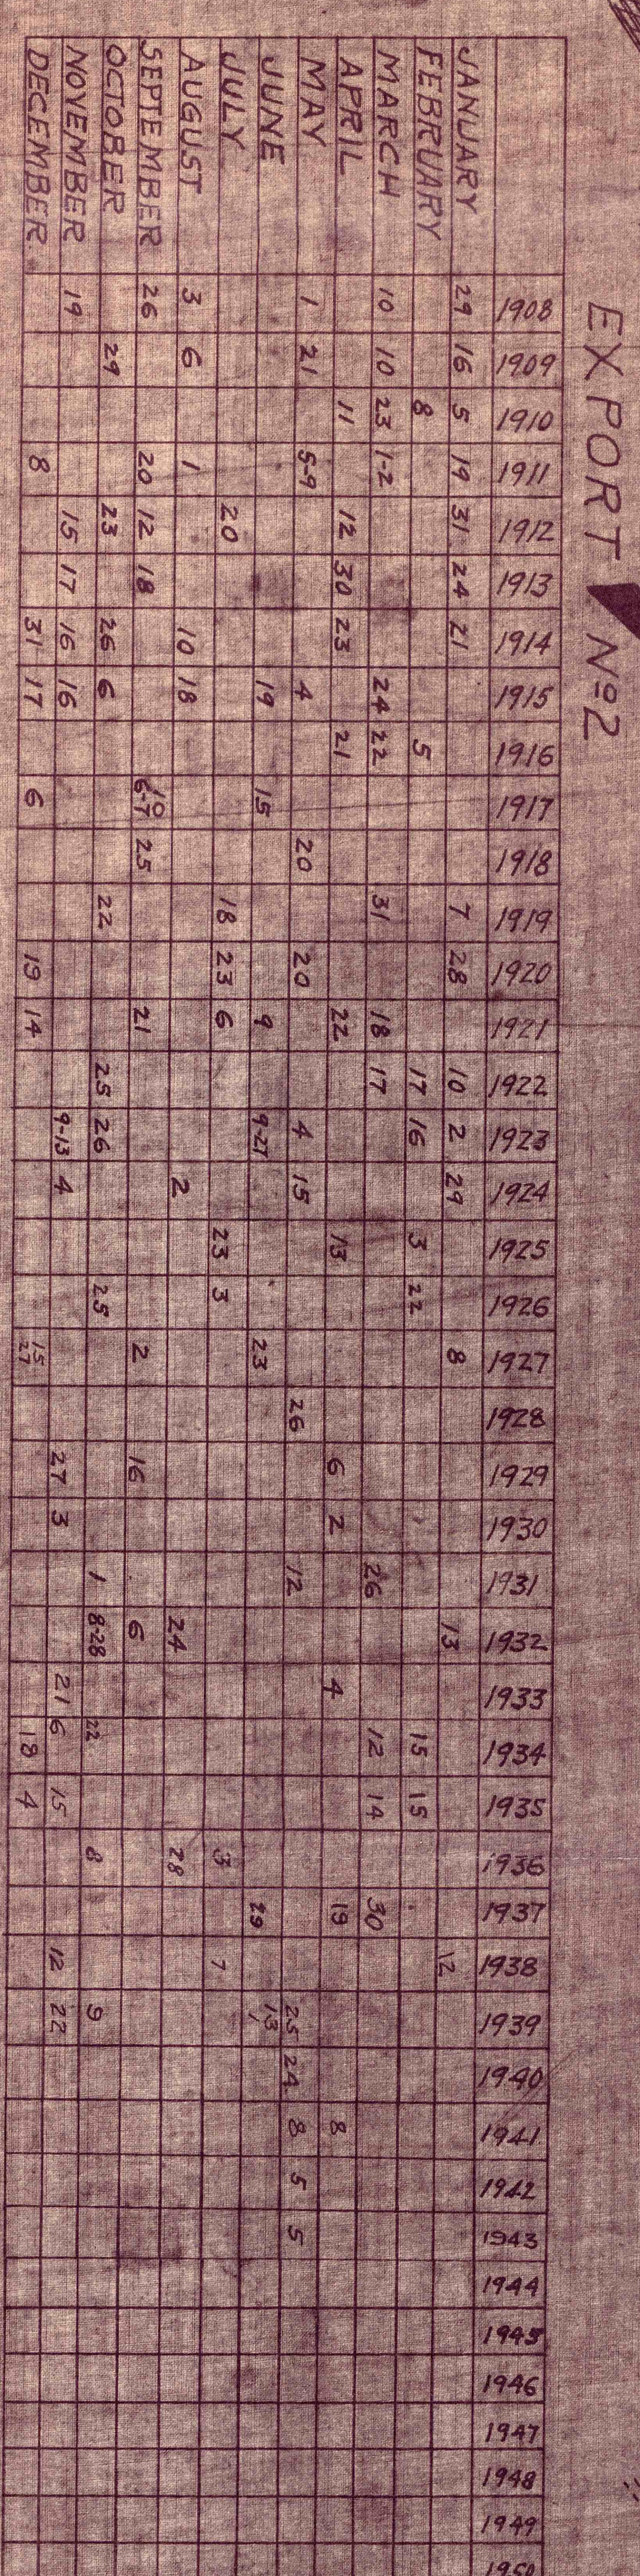

MAP OF
EXPORT MINES
WESTMORELAND COAL CO.
CHEMIST REPORTS
SCALE 600 FEET = 1 INCH
JUNE 8 1933
ENG. DEPT. W. C. CO. IRVING, PA.