



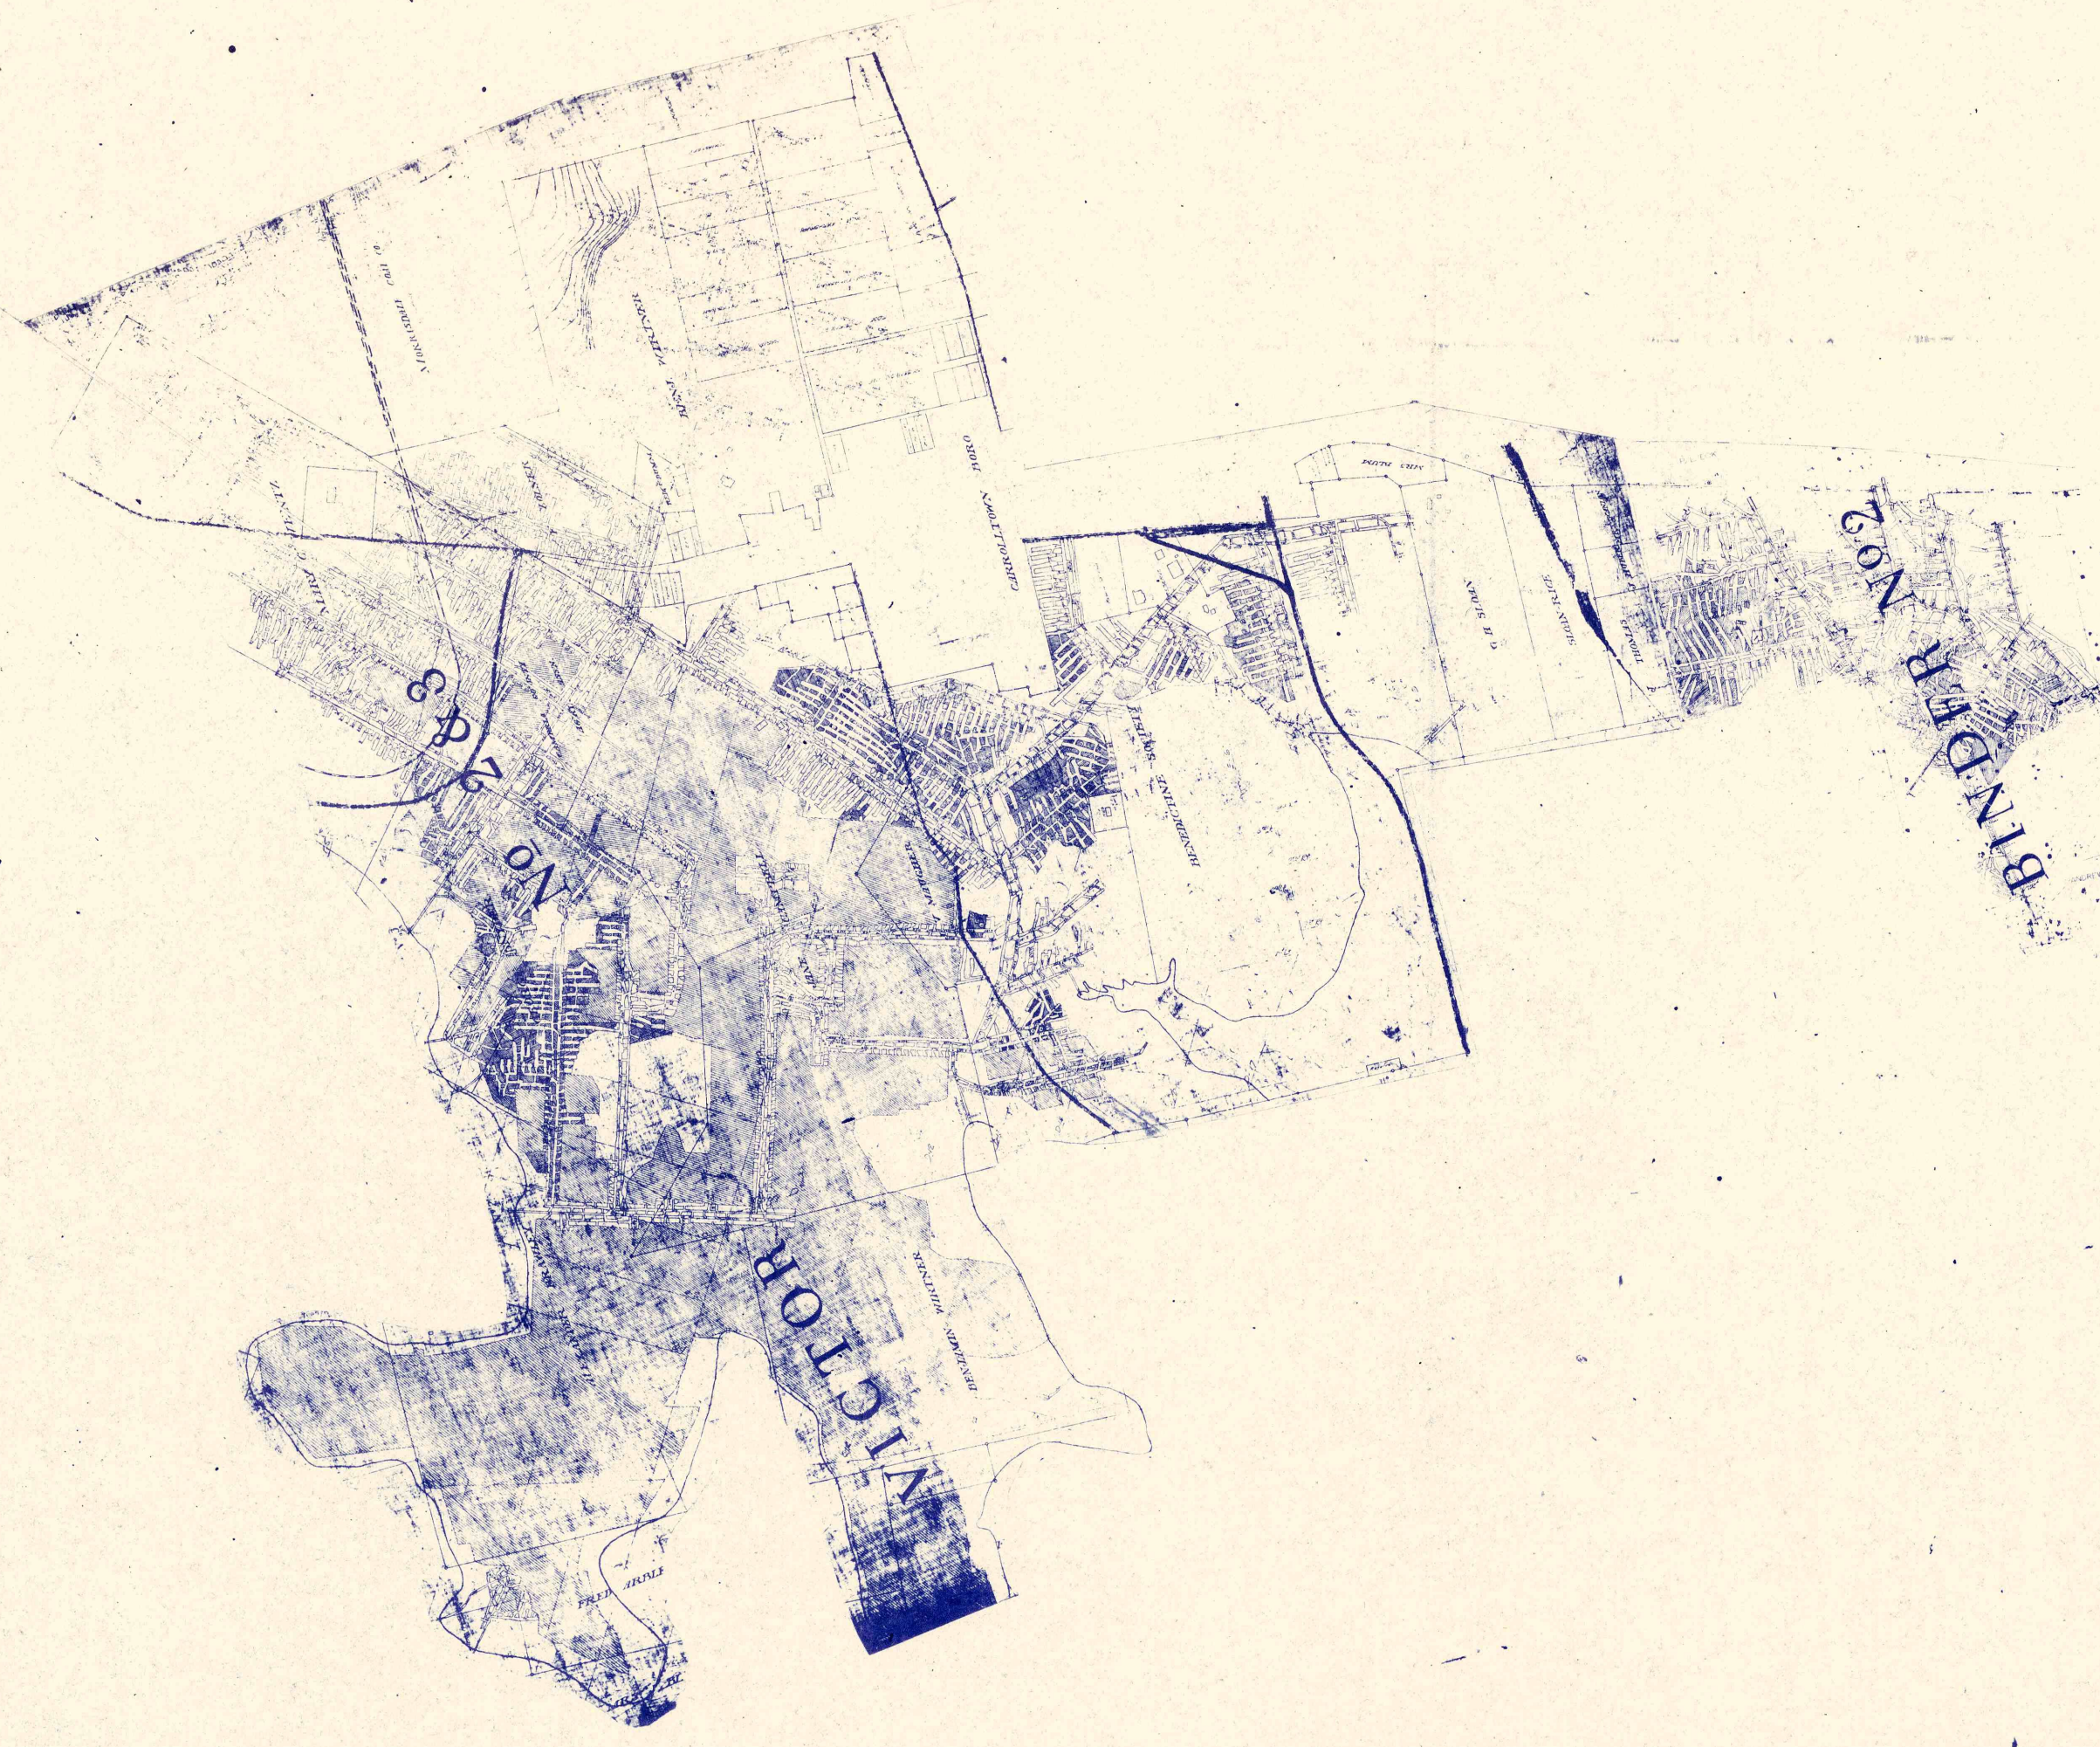

BEAR MINE

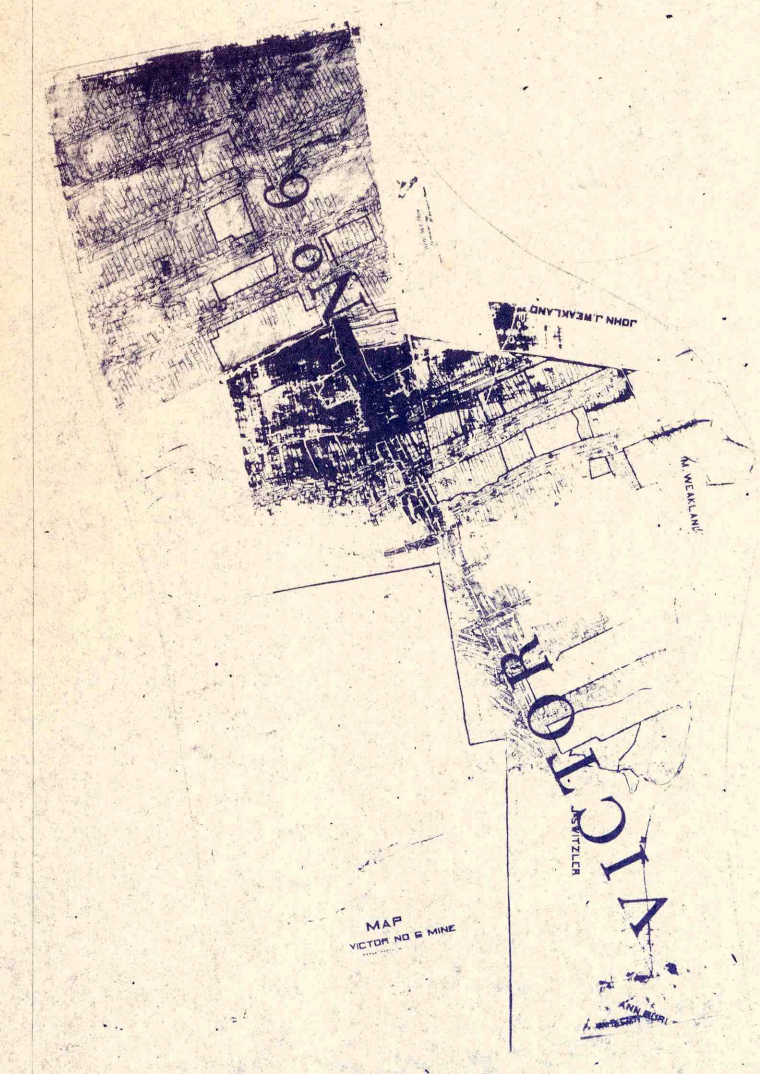