


SPANGLER No 4

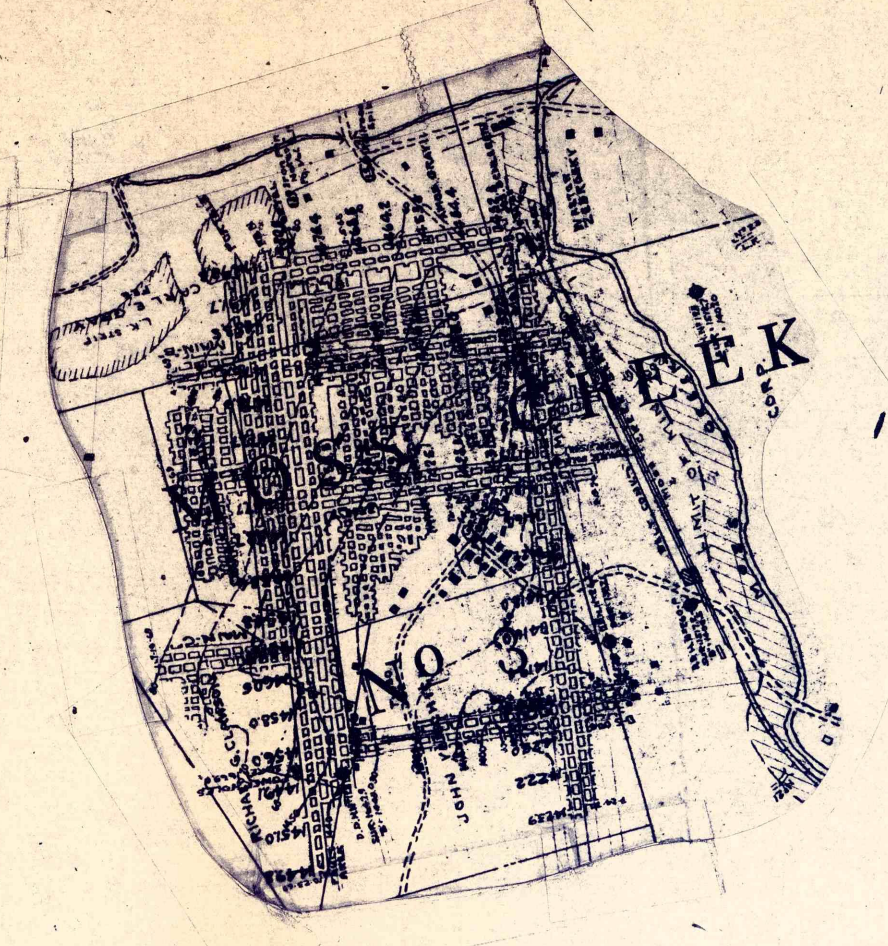

BINDER

STERLING No 3

HEISLEY

No 2

LANCASHIRE

No 14

CASHIER

No 6

COLVER MINNE

ST

LANCASHIRE

LANCASHIRE

