


304 160

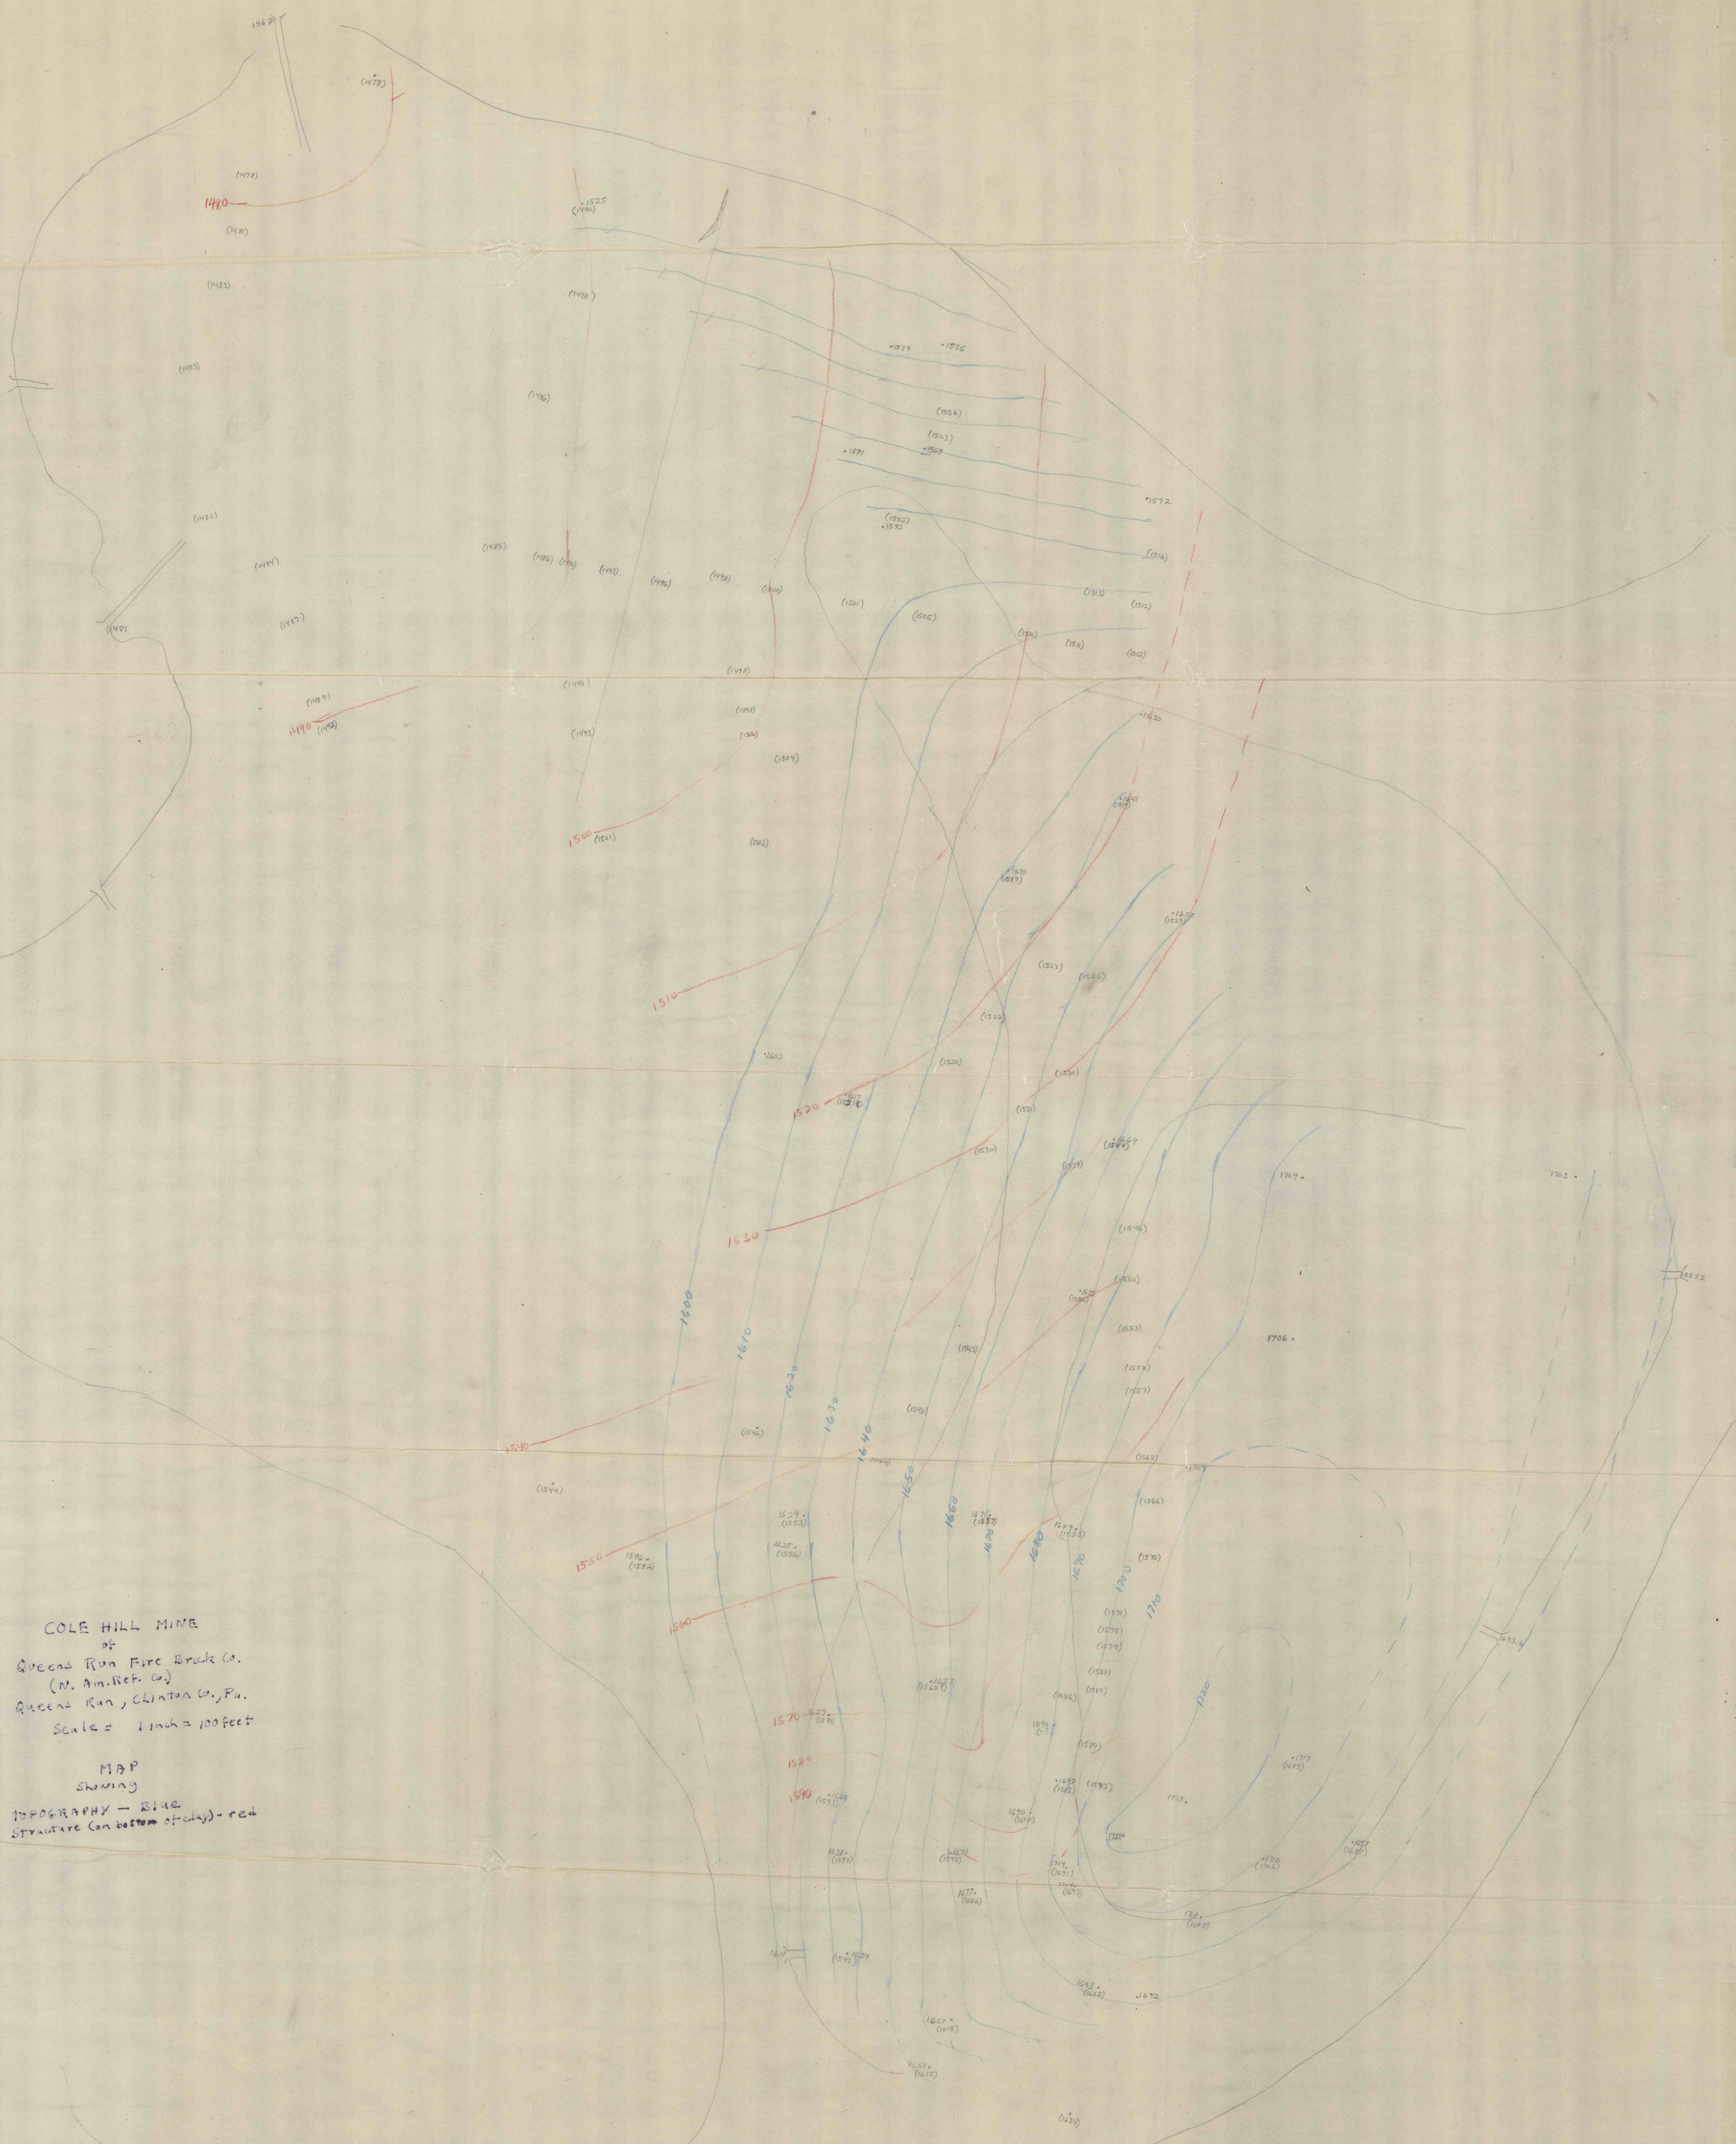

COLE HILL MINE
 of
 Queens Run Fire Brick Co.
 (N. Am. Ref. Co.)
 Queens Run, Clinton Co., Pa.
 Scale = 1 inch = 100 feet

MAP
 showing
 TOPOGRAPHY - Blue
 Structure (on bottom of clay) - red