


RECEIVED
JUNE 9 1985
SOMERSET COUNTY ENGINEERING OFFICE
SOMERSET, PENNSYLVANIA

SHADE MINING COMPANY

MATCH LINE (SHEET 2 OF 6)

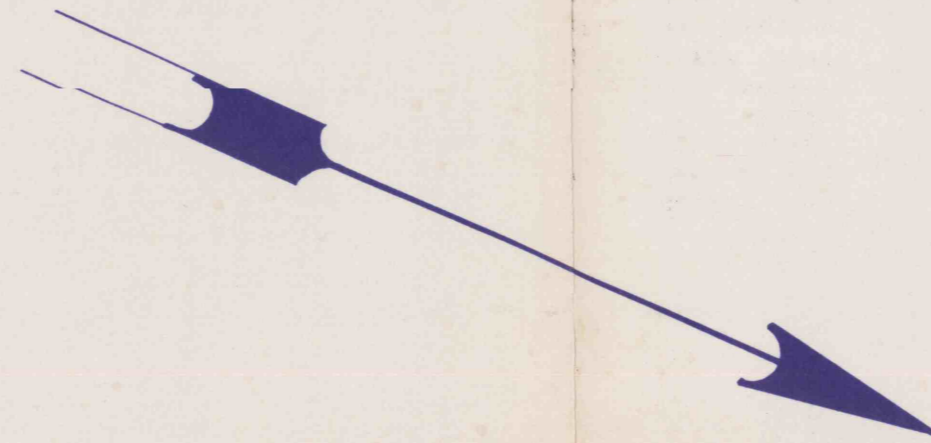

I, David R. Mills, do hereby certify that this map is a true and correct copy of the original map of the Iriza Mine (Trent No. 1) and that the original map is a true, complete, and correct map and survey of all encroachments made as of the date of the last survey.
Date of last survey: 4/15/85
David R. Mills
David R. Mills

PREPARED FOR
TRENT COAL, INC

MINE NO. 1
UPPER KITTANNING COAL SEAM
SITUATE
SHADE TOWNSHIP, SOMERSET COUNTY,
PENNSYLVANIA

SCALE 1" = 100'

SHEET
6 of 6

EARTHTECH
R.D. 2, Box 124
Somerset, PA 15501

Phone: (814) 443-3384