

MATCH TO SHEET 3H

E1751,000
N 450,000

N 449,000

N 448,000

N 447,000

N 446,000

E1750,000

E1749,000


E1748,000

L11038

T499

L11038

SPT
E1182.53

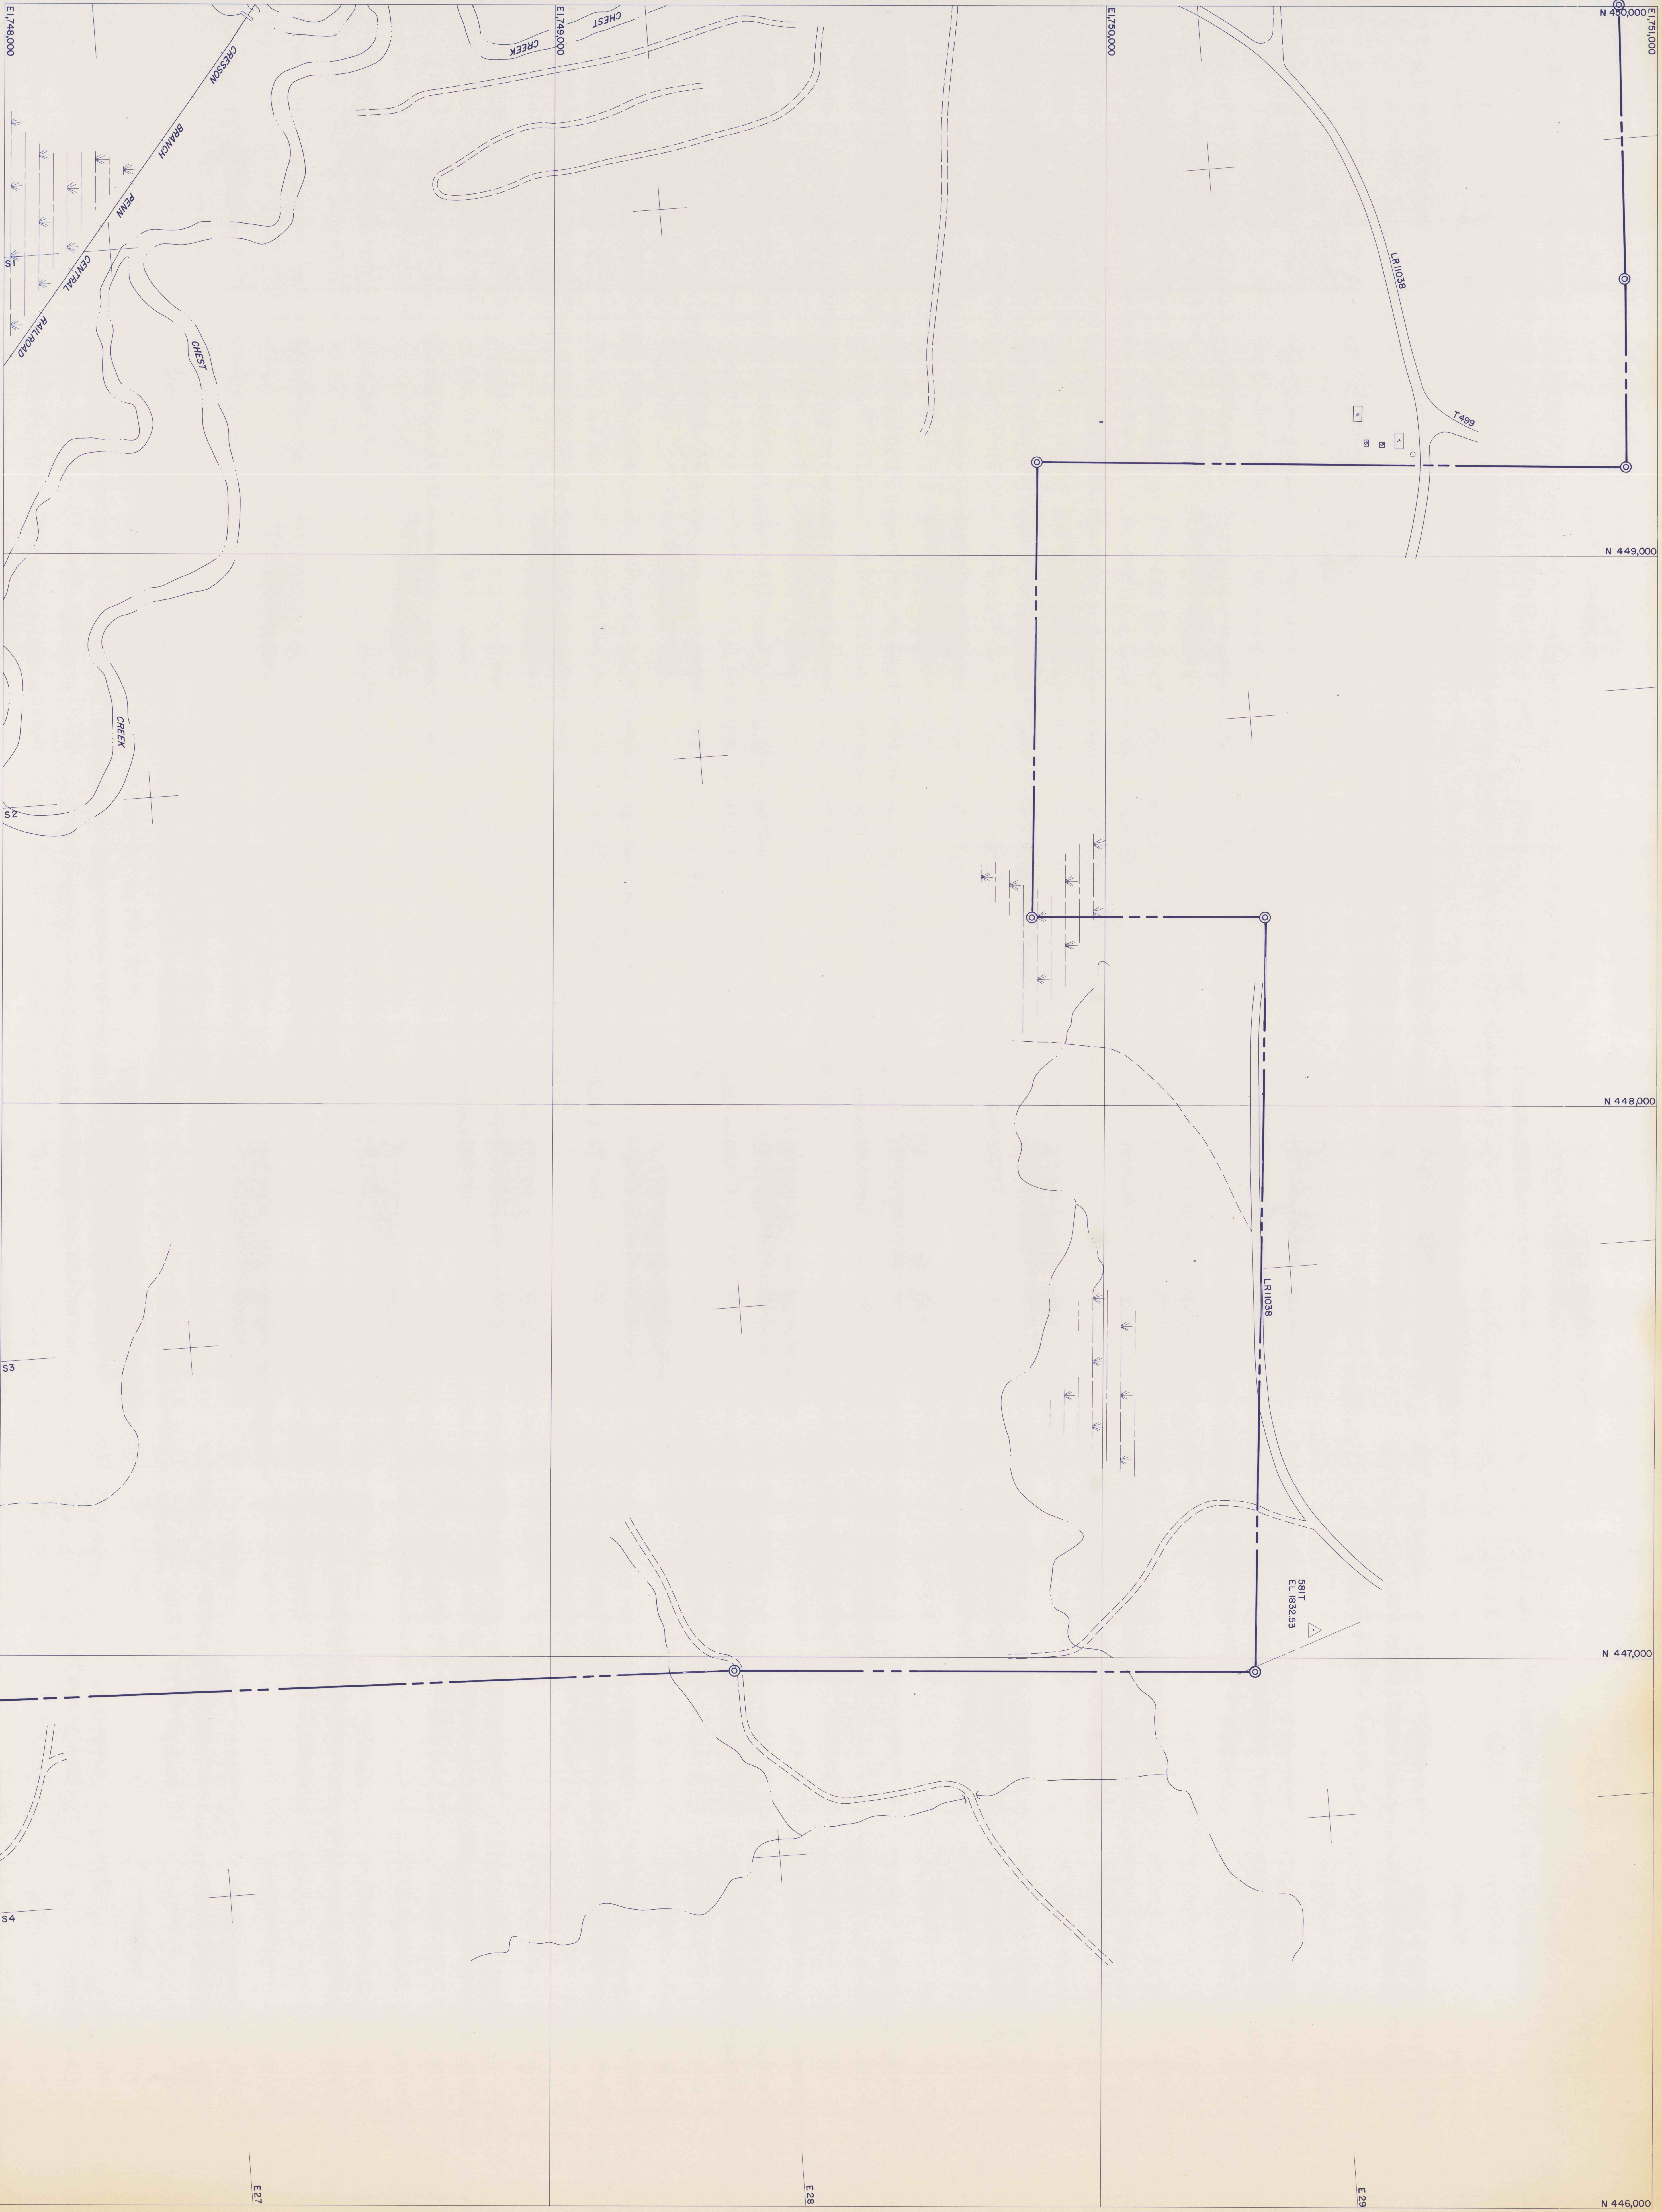

MATCH TO SHEET 4G



FINAL MAPPING DATE: 01-29-86

BARNES & TURKER COMPANY
 LANCASTER NO. 20 MINE
 EAST CARROLL TOWNSHIP, CAMBRIA COUNTY, PENNSYLVANIA
 SCALE: 1"=100'
 DATE: JULY, 1976

