
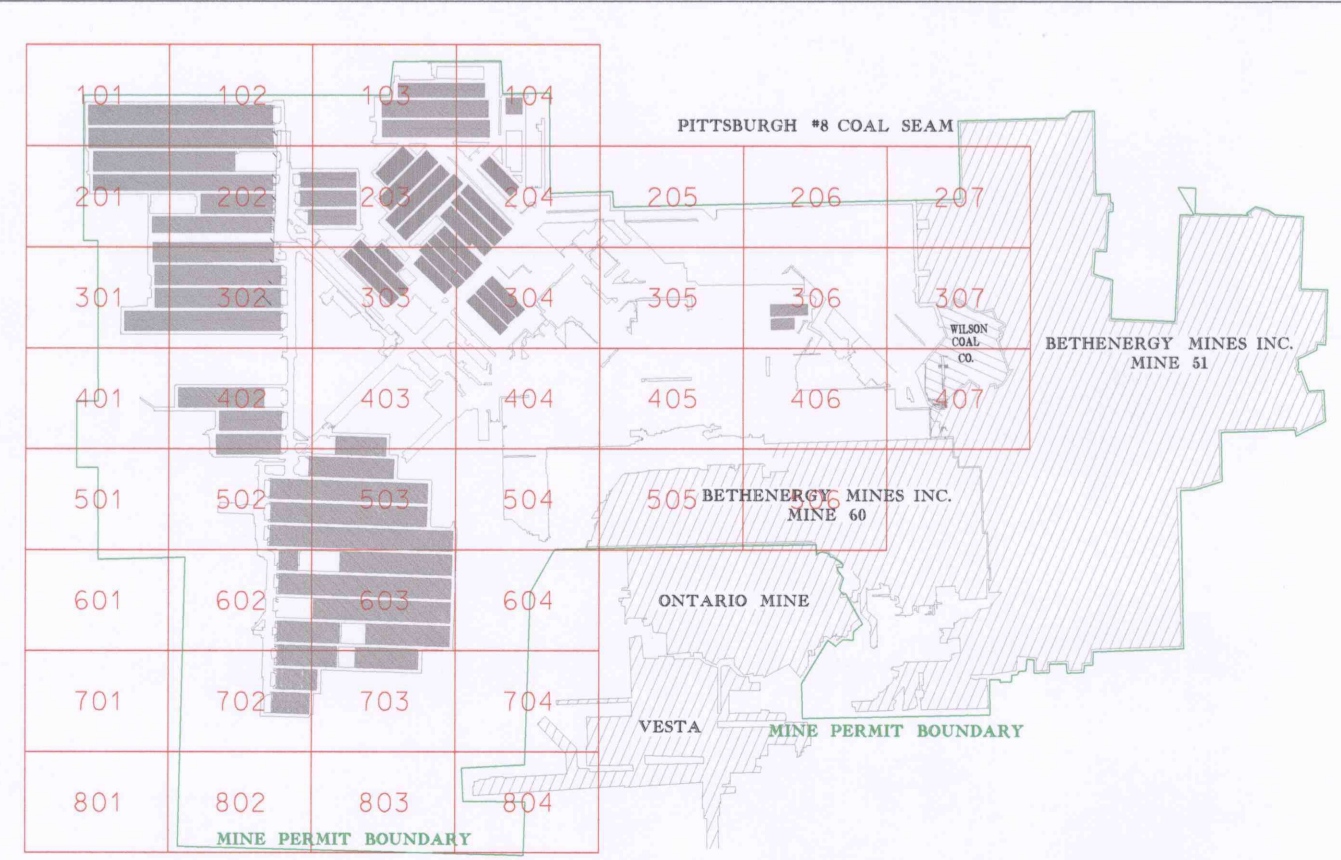


MATCH TO SHEET 603

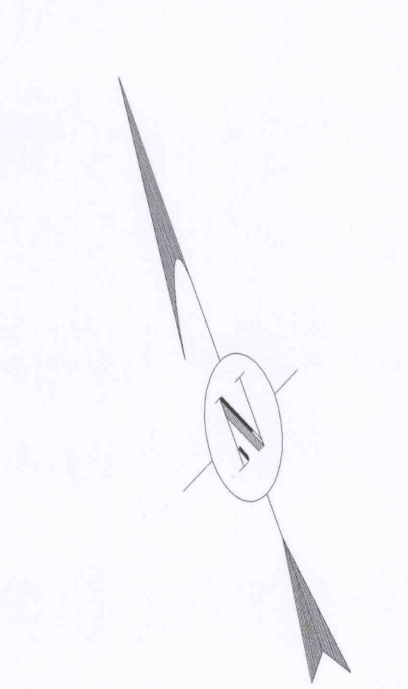

This map submitted in accordance with 30 CFR Sec. 75.1204 & PA Act 55 SB 949 Sec. 228  
 PERSONS PROVIDING INFORMATION ON MAP:  
 MARK HUBBARD, MINE FOREMAN  
 NATHAN WOODS, MINE ENGINEER-TRAINER

INFORMATION INCORPORATED IN THIS MINE MAP WAS PROVIDED BY THE OPERATOR AND PREVIOUS OPERATORS AND MAY NOT HAVE ALL BEEN VERIFIED OR EVALUATED BY THE UNDERGROUND. THE MAP MAY ALSO INCORPORATE THE SURVEY RESULTS AND MAPPING PREPARED UNDER THE DIRECTION OF REGISTERED ENGINEERS OTHER THAN THE UNDERGROUND. SUBJECT TO THE AFORESAID, THE DRAWING CONTAINS ACCURATE INFORMATION AND HAS BEEN COMPILED IN ACCORDANCE WITH GOOD ENGINEERING PRACTICES AS OF MARCH 15, 2005. MINE MAPS PREPARED BY STANIMEX CONSULTING ENGINEERS, INC. IN ACCORDANCE WITH 30 CFR PART 75.1204-75.1205 AND 75.1206-75.1207.

CHAIN OF OWNERSHIP:  
 OWNER/LESSOR  
 RESERVE COAL PROPERTIES CO. 11/16/2001 - PRESENT  
 LUCERNE LAND CO. 12/30/1992 - 11/16/2001  
 BETHLEHEM STEEL CORP. 12/24/1988 - 12/30/1992  
 CONSOLIDATION COAL CO. 05/01/1958 - 12/24/1988  
 PITTSBURGH CONSOLIDATION COAL CO. 12/23/1945 - 05/01/1958

LESSEE/OPERATOR  
 EIGHTY FOUR MINING CO. 12/25/1992 - PRESENT  
 BETHLEHEM MINE, INC. 07/01/1987 - 12/30/1992

EIGHTY FOUR MINING COMPANY  
 MINE #4  
 P.O. BOX 4  
 CLAYSVILLE, PA 15123

MSHA I.D. NO. 36-0098  
 PA DEP CMAP NO. E383302  
 SCALE 1" = 200'  
 FINAL MINE MAP  
 NOVEMBER 28, 2011

RELIEF/WATER MONITORING BOREHOLE  
 HORIZONTAL & VERTICAL CONTROL  
 STREAM  
 IDENTIFIED GAS WELL  
 ALLEGED WELL  
 EXPLORATION CORE HOLE  
 SEAL  
 MINE PERMIT BOUNDARY  
 NO KNOWN MINE WORKINGS UNDERLYING OR OVERLYING THE MINE PROPERTY  
 MIN SURVEY ACCURACY ±10,000 (CLOSED LOOP)

ALL BOREHOLES SEALED EXCEPT PRESSURE RELIEF/WATER MONITORING BOREHOLES  
 (HALAM POWER, MUSTAVA VENTILATION, KOSI BRIGLINE, LIVINGSTON CONCRETE, LONG SHAFT BOREHOLE, RICHMOND POWER, WEP POWER & ZENKER POWER)

