



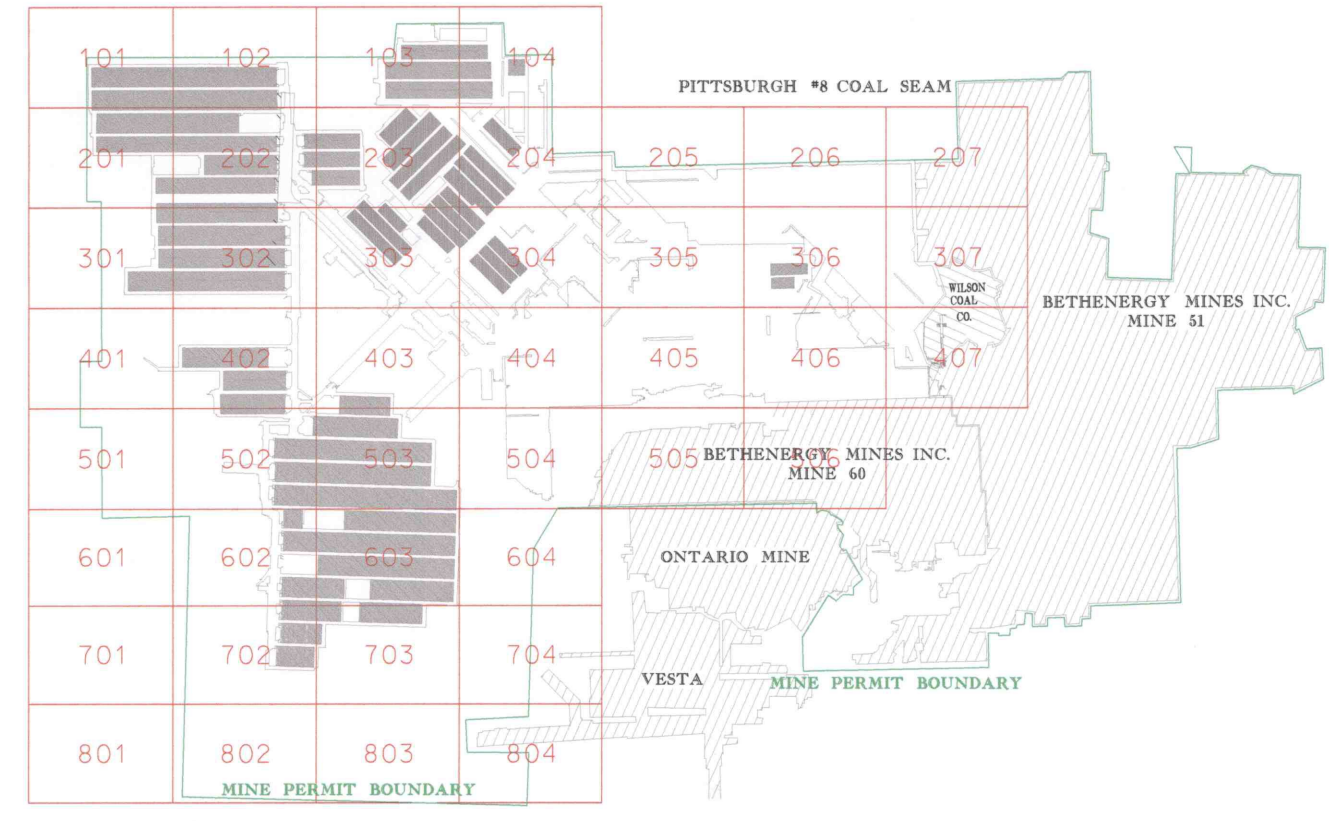

MATCH TO SHEET 703

MATCH TO SHEET 804

SHEET 704

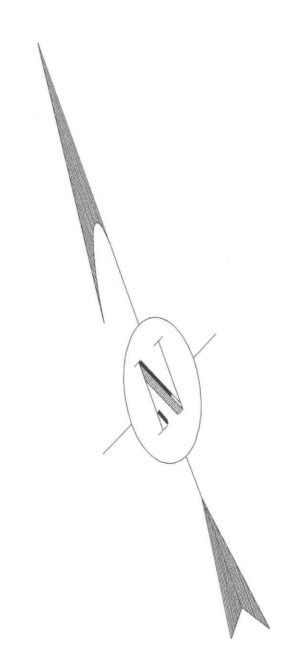

This map submitted in accordance with 30 CFR Sec. 75.1004 & PA Act 55 SB 949 Sec. 228  
 PERSONS PROVIDING INFORMATION ON MAP:  
 MARK HRUTKAY, MINE FOREMAN  
 NATHAN WOODS, MINE ENGINEER TRAINER

INFORMATION INCORPORATED IN THIS MINE MAP WAS PROVIDED BY THE OPERATOR AND PREVIOUS OPERATORS AND MAY NOT HAVE ALL BEEN VERIFIED OR EVALUATED BY THE UNDERSIGNED. THE MAP MAY ALSO INCORPORATE THE SURVEY RESULTS AND MAPPING PREPARED UNDER THE DIRECTION OF REGISTERED ENGINEERS OTHER THAN THE UNDERSIGNED. SUBJECT TO THE INFORMATION QUALIFICATIONS TO THE BEST OF MY KNOWLEDGE AND BELIEF THIS DRAWING CONTAINS ACCURATE INFORMATION AND HAS BEEN COMPILED IN ACCORDANCE WITH GOOD ENGINEERING PRACTICES AS OF MARCH 16, 2005. MINE MAPS PREPARED BY STANDARDS ACCORDING TO PA DEP TID NO. 863-2000-610 SEC. 22.8 PENNSYLVANIA STATE PLANE COORDINATE GRID (NAD83 DATUM).

CHAIN OF OWNERSHIP  
 OWNER/LESSOR  
 RESERVE COAL PROPERTIES CO. 15/16/2001 - PRESENT  
 LUCINE LAGO CO. 12/10/1982 - 11/18/2001  
 BETHLEHEM STEEL CORP. 12/24/1968 - 12/30/1992  
 CONSOLIDATION COAL CO. 12/30/1958 - 12/24/1968  
 PITTSBURGH CONSOLIDATION COAL CO. 11/23/1945 - 05/01/1958

LESSEE/OPERATOR  
 EIGHTY FOUR MINE CO. 12/30/1992 - PRESENT  
 BETHENERDY MINES, INC. 07/01/1987 - 12/30/1992

EIGHTY FOUR MINE COMPANY  
 MINE #4  
 P.O. BOX J  
 CLAIRSVILLE, PA 15323

MEHA I.D. NO. 36-00558  
 PA DEP OMP AS 6363302  
 SCALE 1" = 200'  
 FINAL MINE MAP  
 NOVEMBER 28, 2011

RELEVANT MONITORING BOREHOLE  
 HORIZONTAL & VERTICAL CONTROL  
 STREAM  
 IDENTIFIED GAS WELL  
 ALLEGED WELL  
 EXPLORATION CORE HOLE  
 SEAL  
 MINE PERMIT BOUNDARY  
 NO KNOWN MINE WORKINGS UNDERLYING OR OVERLYING THE MINE PROPERTY  
 MN SURVEY ACCURACY ±10,000 (CLOSED LOOP)

ALL BOREHOLES SEALED EXCEPT PRESSURE RELIEF/WATER MONITORING BOREHOLES  
 HULLAM POWER, MUSTATA VENTILATION, KERR-ROGUE, LIVINGSTON CONCRETE, LONG SHIFT BOREHOLE, RICHARDSON POWER, WEP POWER, & ZEDKER POWER.

