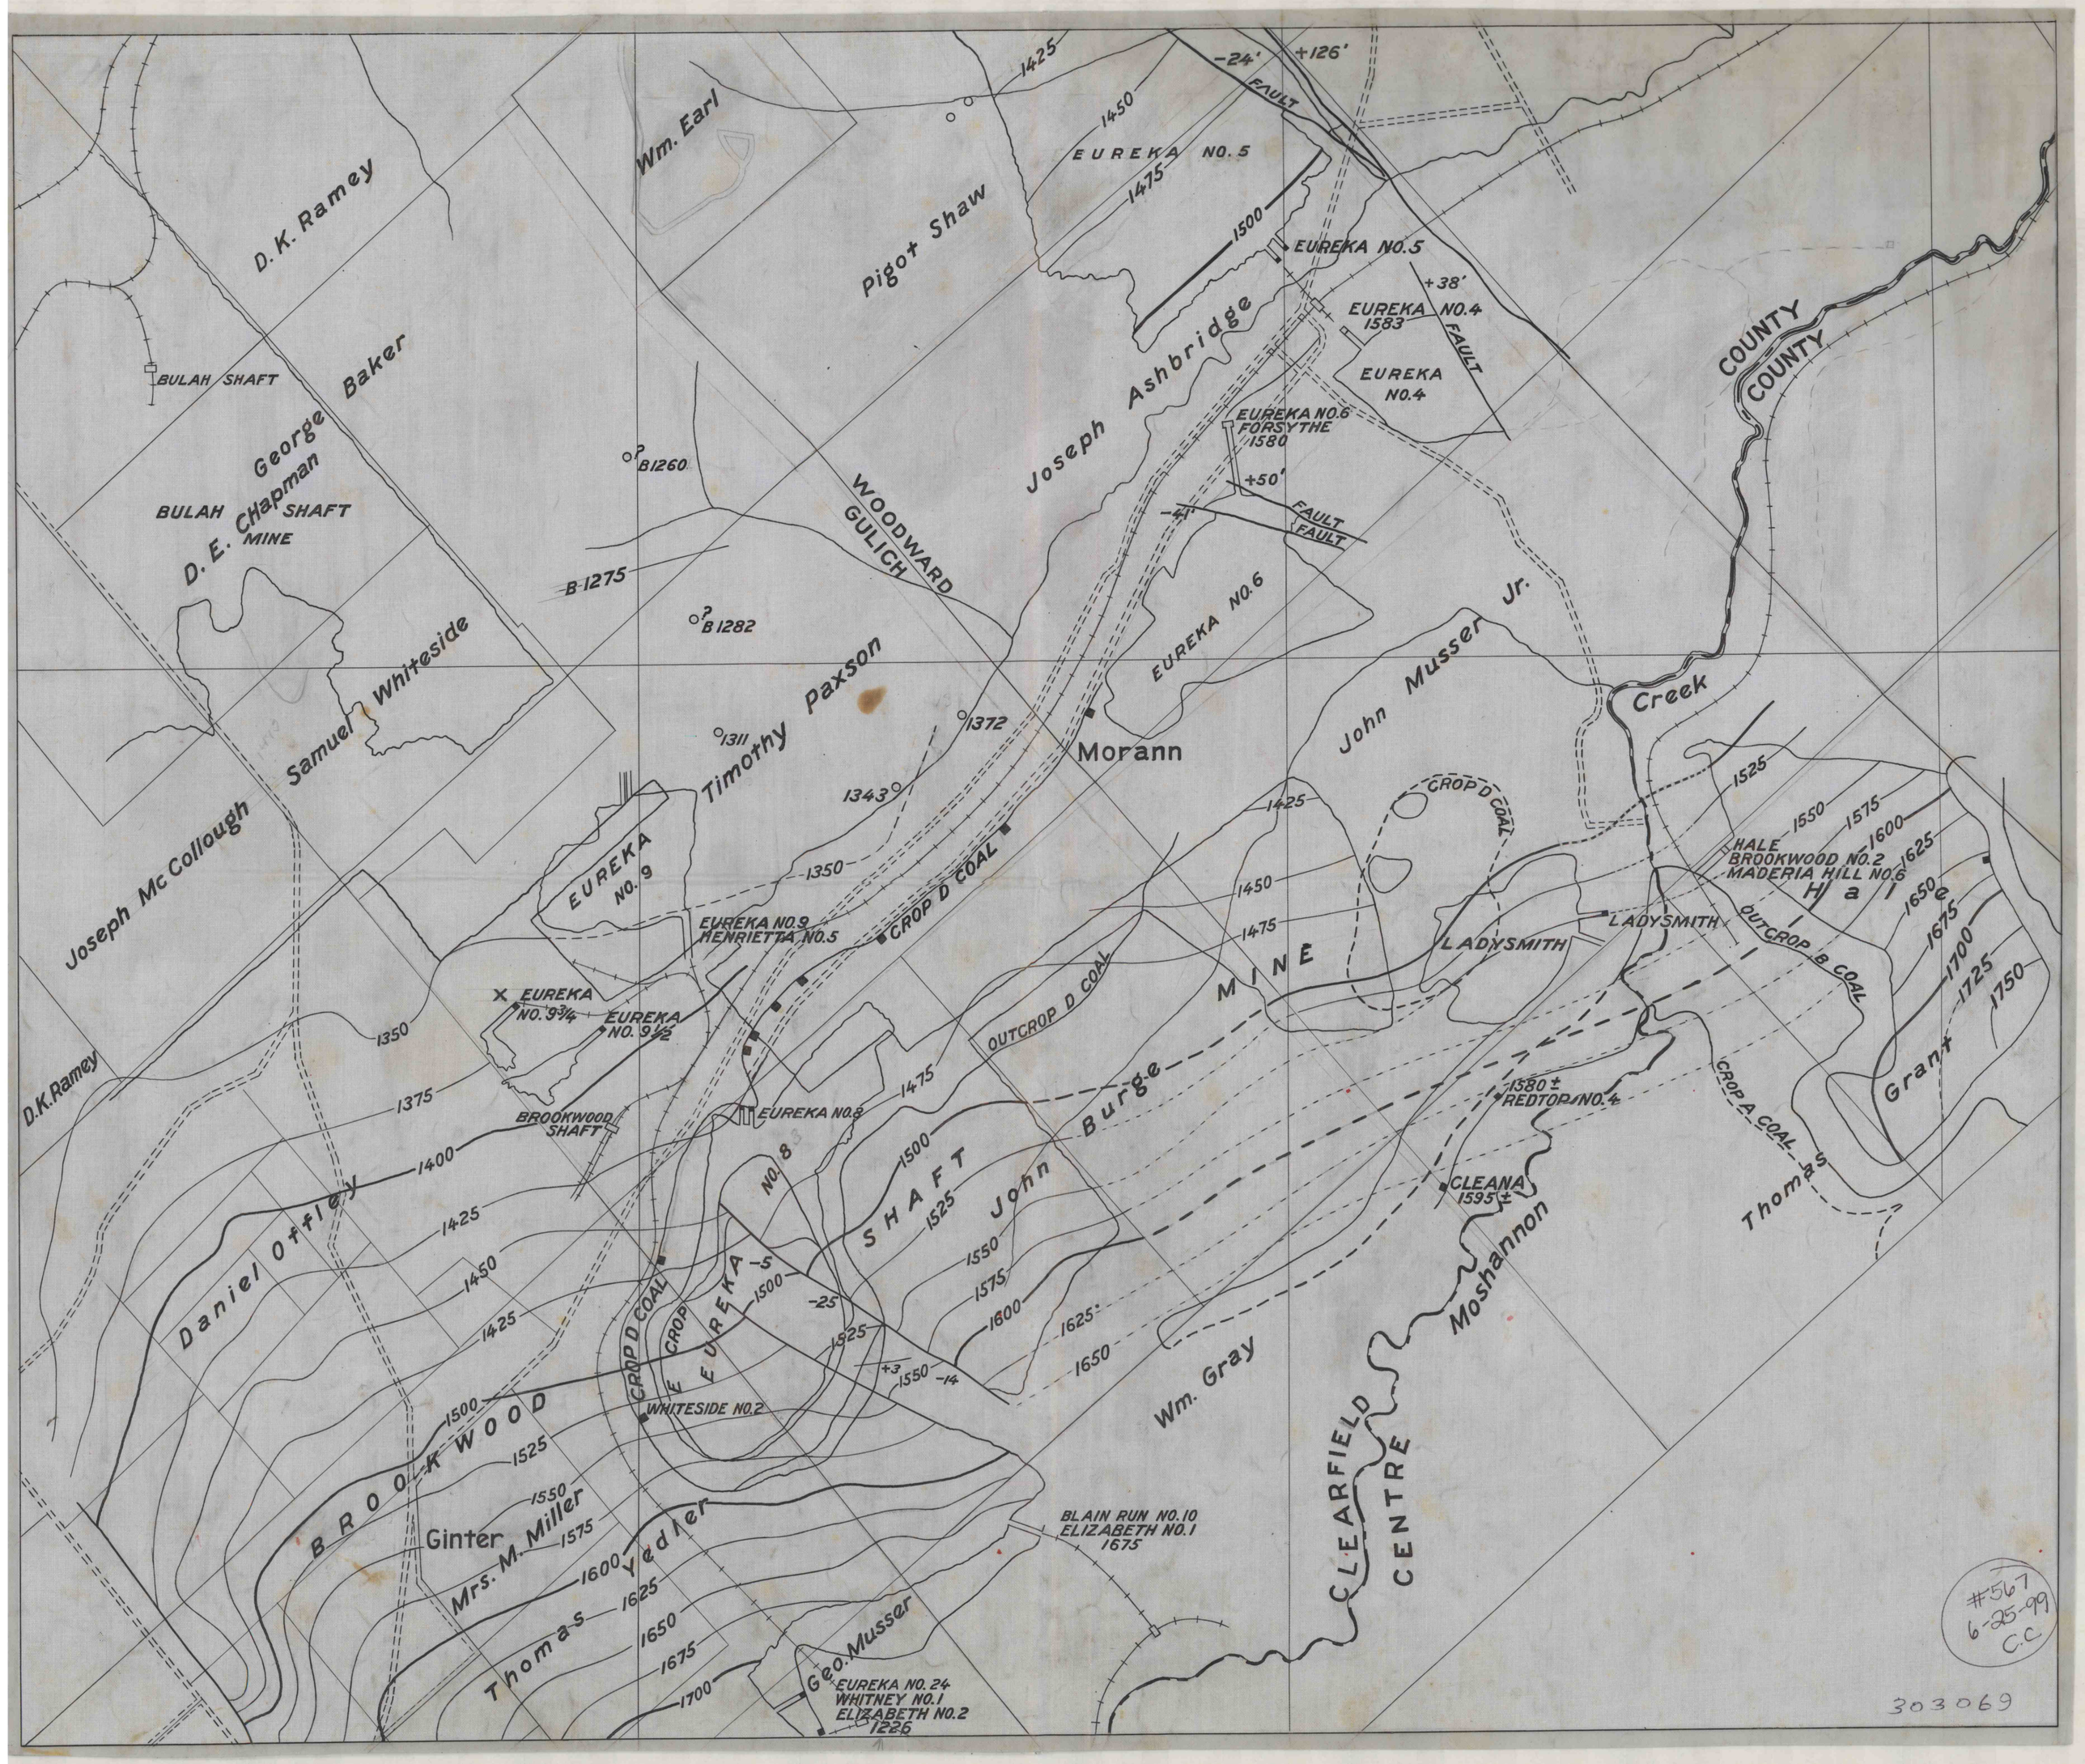
D. K. Ramey
Wm. Earl
Pigot Shaw
EUREKA NO. 5
-24'
+126'
FAULT
EUREKA NO.5
+38'
EUREKA NO.4
1583
FAULT
EUREKA NO.4
Joseph Ashbridge
COUNTY
COUNTY
BULAH SHAFT
George Baker
BULAH SHAFT
D. E. Chapman
MINE
EUREKA NO.6
FORSYTHE
1580
+50'
-41'
FAULT
FAULT
B1260
WOODWARD GULICH
B1275
B1282
EUREKA NO.6
John Musser Jr.
Creek
Samuel Whiteside
Joseph Mc Collough
Timothy Paxson
1311
1372
1343
Morann
CROP D COAL
1425
1525
1550
1575
1600
1625
HALE
BROOKWOOD NO.2
MADERIA HILL NO.6
Hale
EUREKA NO. 9
1350
EUREKA NO.9
HENRIETTA NO.5
CROP D COAL
1450
1475
LADYSMITH
LADYSMITH
OUTCROP B COAL
1650
1675
1700
1725
1750
Grant
X EUREKA NO. 9¾
EUREKA NO. 9½
OUTCROP D COAL
MINE
D.K.Ramey
1375
BROOKWOOD SHAFT
EUREKA NO.8
1400
1580 ± REDTOP NO.4
CROP A COAL
Thomas
Daniel Offley
NO. 8
SHAFT
John Burge
CLEANA
1595 ±
Moshannon
EUREKA
-5
-25
+3
-14
CROP D COAL
CROP
WHITESIDE NO.2
Wm. Gray
CLEARFIELD CENTRE
BROOKWOOD
Ginter
Mrs. M. Miller
Yedler
Thomas
BLAIN RUN NO.10
ELIZABETH NO.1
1675
Geo. Musser
EUREKA NO. 24
WHITNEY NO.1
ELIZABETH NO.2
1226
#567
6-25-99
C.C.
303069